FED ROAD DIST. NO.	STATE	FED. AID PROJ. NO.	FISCAL YEAR	SHEET NO.	TO
9	VT	12	1939-40	4	1

GUARD RAIL REQUIRED

19+68 ON LEFT
Sta 19+68 to Sta 19+92 Length 24 ft.
" 25+88 - " 26+12 - 24 ft.
19+06 ON RIGHT
19+06 to Sta 19+82 - 24 ft.
" 25+88 - - 26+12 - 24 ft.
" 28+00 - - 28+24 - 24 ft. 331
27+60 30 ft.
TOTAL THIS SHEET 216 ft.
ON LEFT
29+46 To Sta. 30+79 " 139 "

TOTAL THIS SHEET 556

NEW CULVERTS REQUIRED

19+25 1V 30
Sta 19+20 18" Cor. Iron Pipe 28 ft.
Concrete Headwalls 1-2-4 1.5 cu.yds.
" 26+00 18" Cor. Iron Pipe 28 ft.
Concrete Headwalls 1-2-4 1.0 cu.yds.

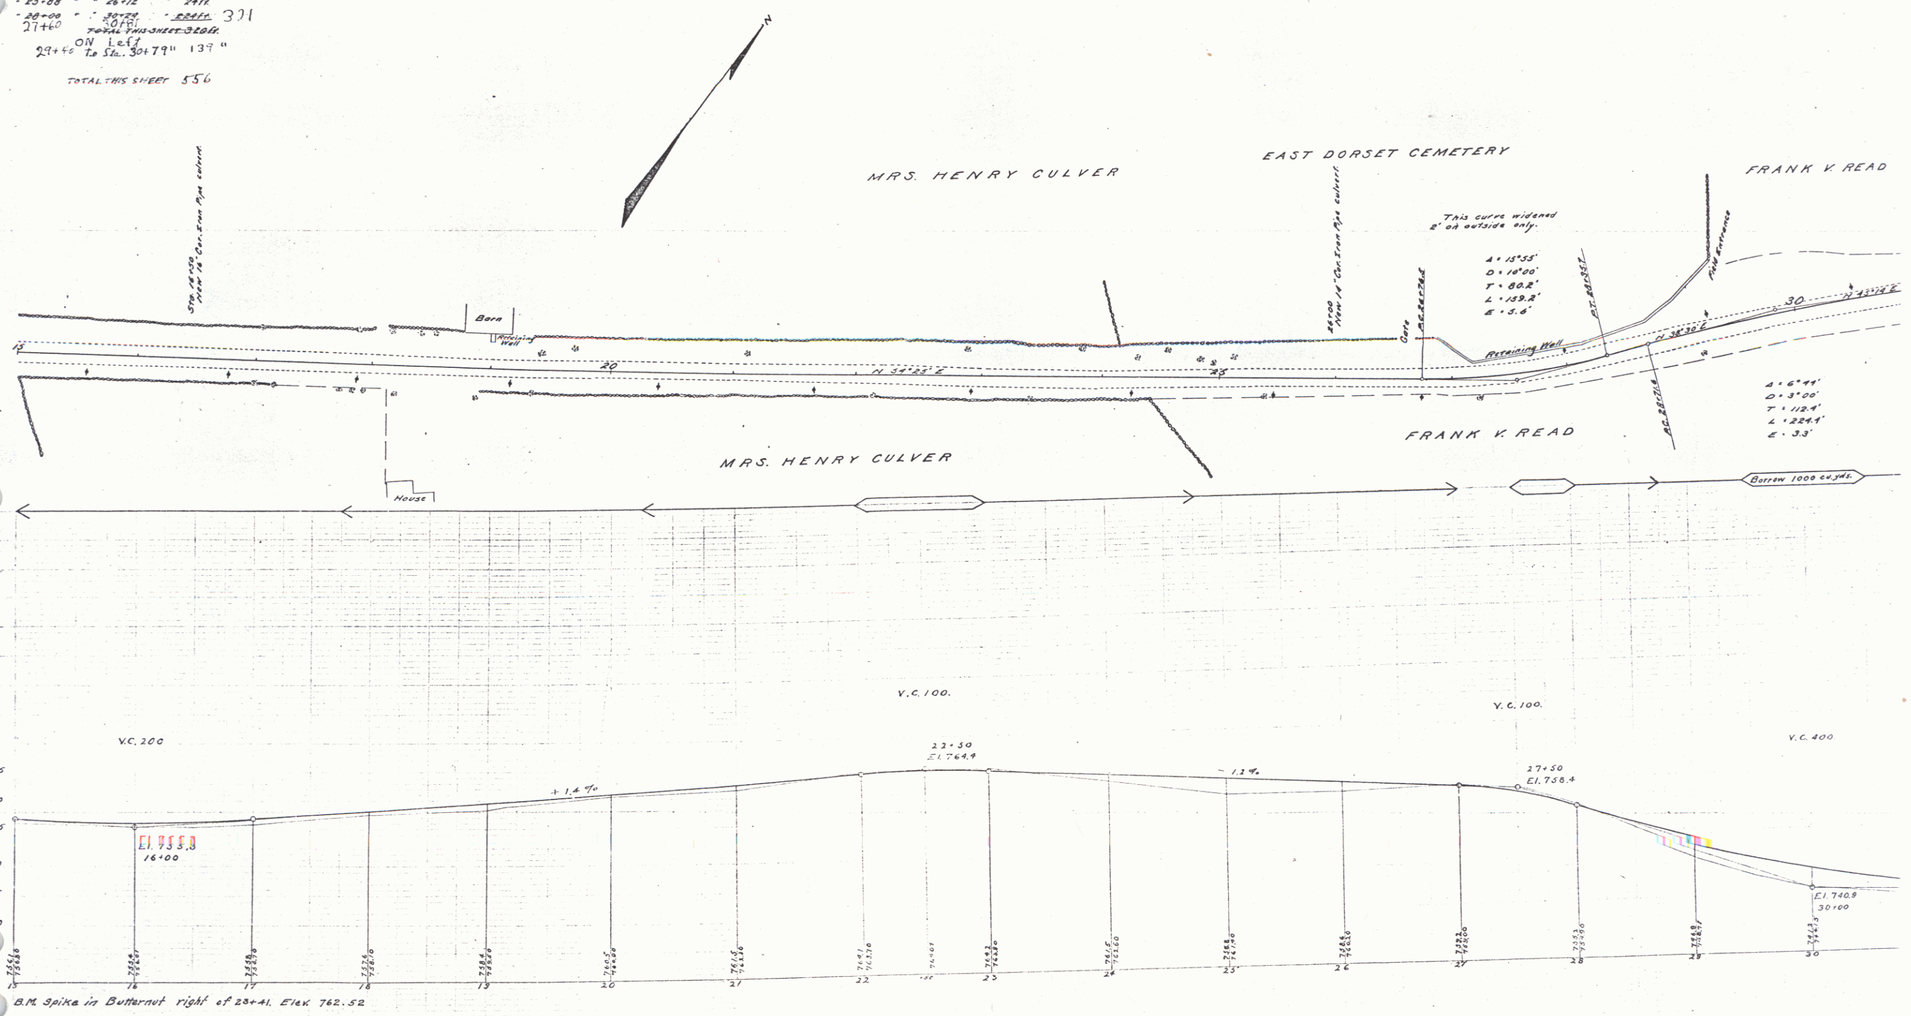

Series F No. 12 F.
Sheet 4 of 1