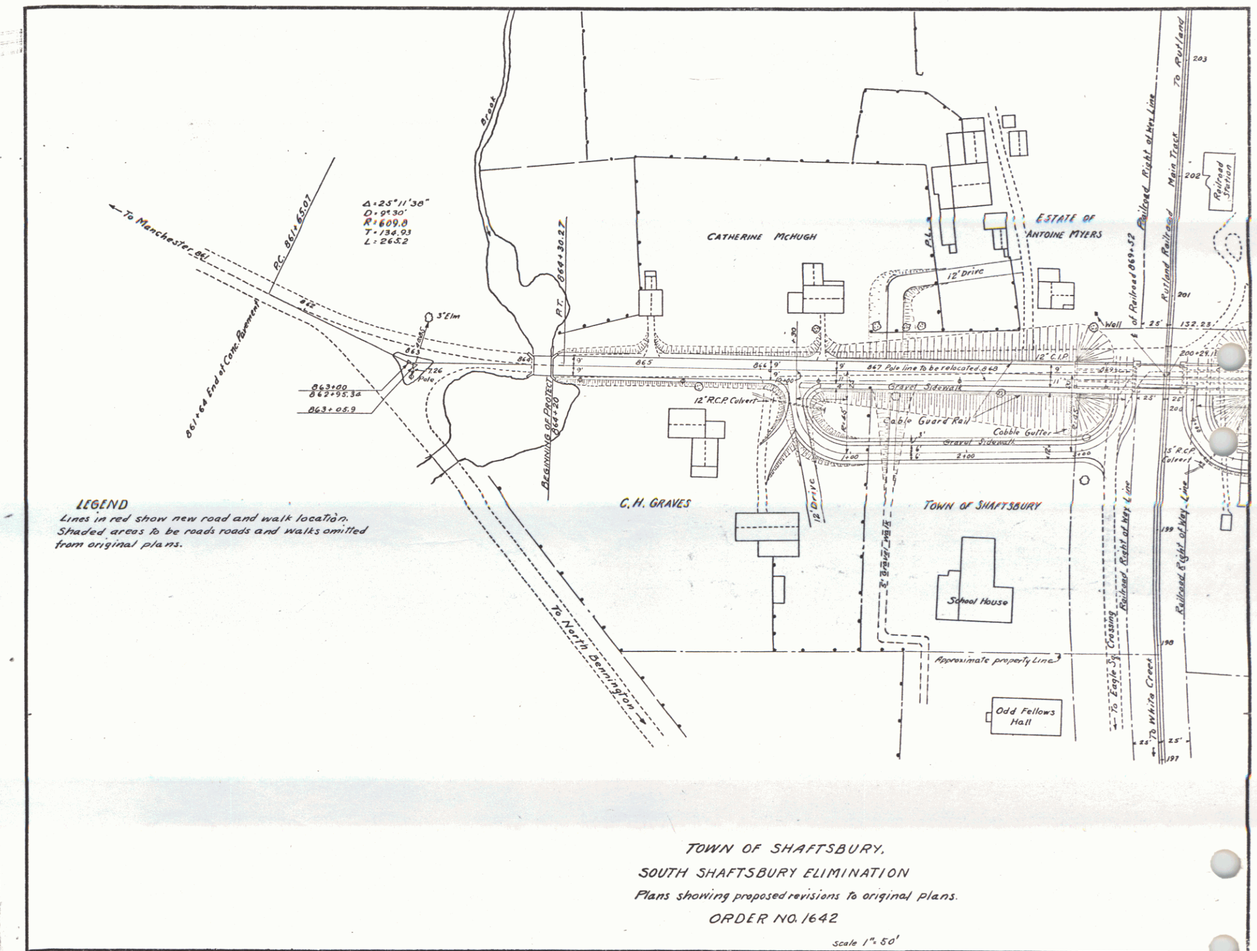


TOWN OF SHAFTSBURY.

SOUTH SHAFTSBURY ELIMINATION

Plans showing proposed revisions to original plans.

ORDER NO. 1642

scale 1" = 50'

DIST. #1 PLANS

3A

2