


POOR ORIGINAL COPY

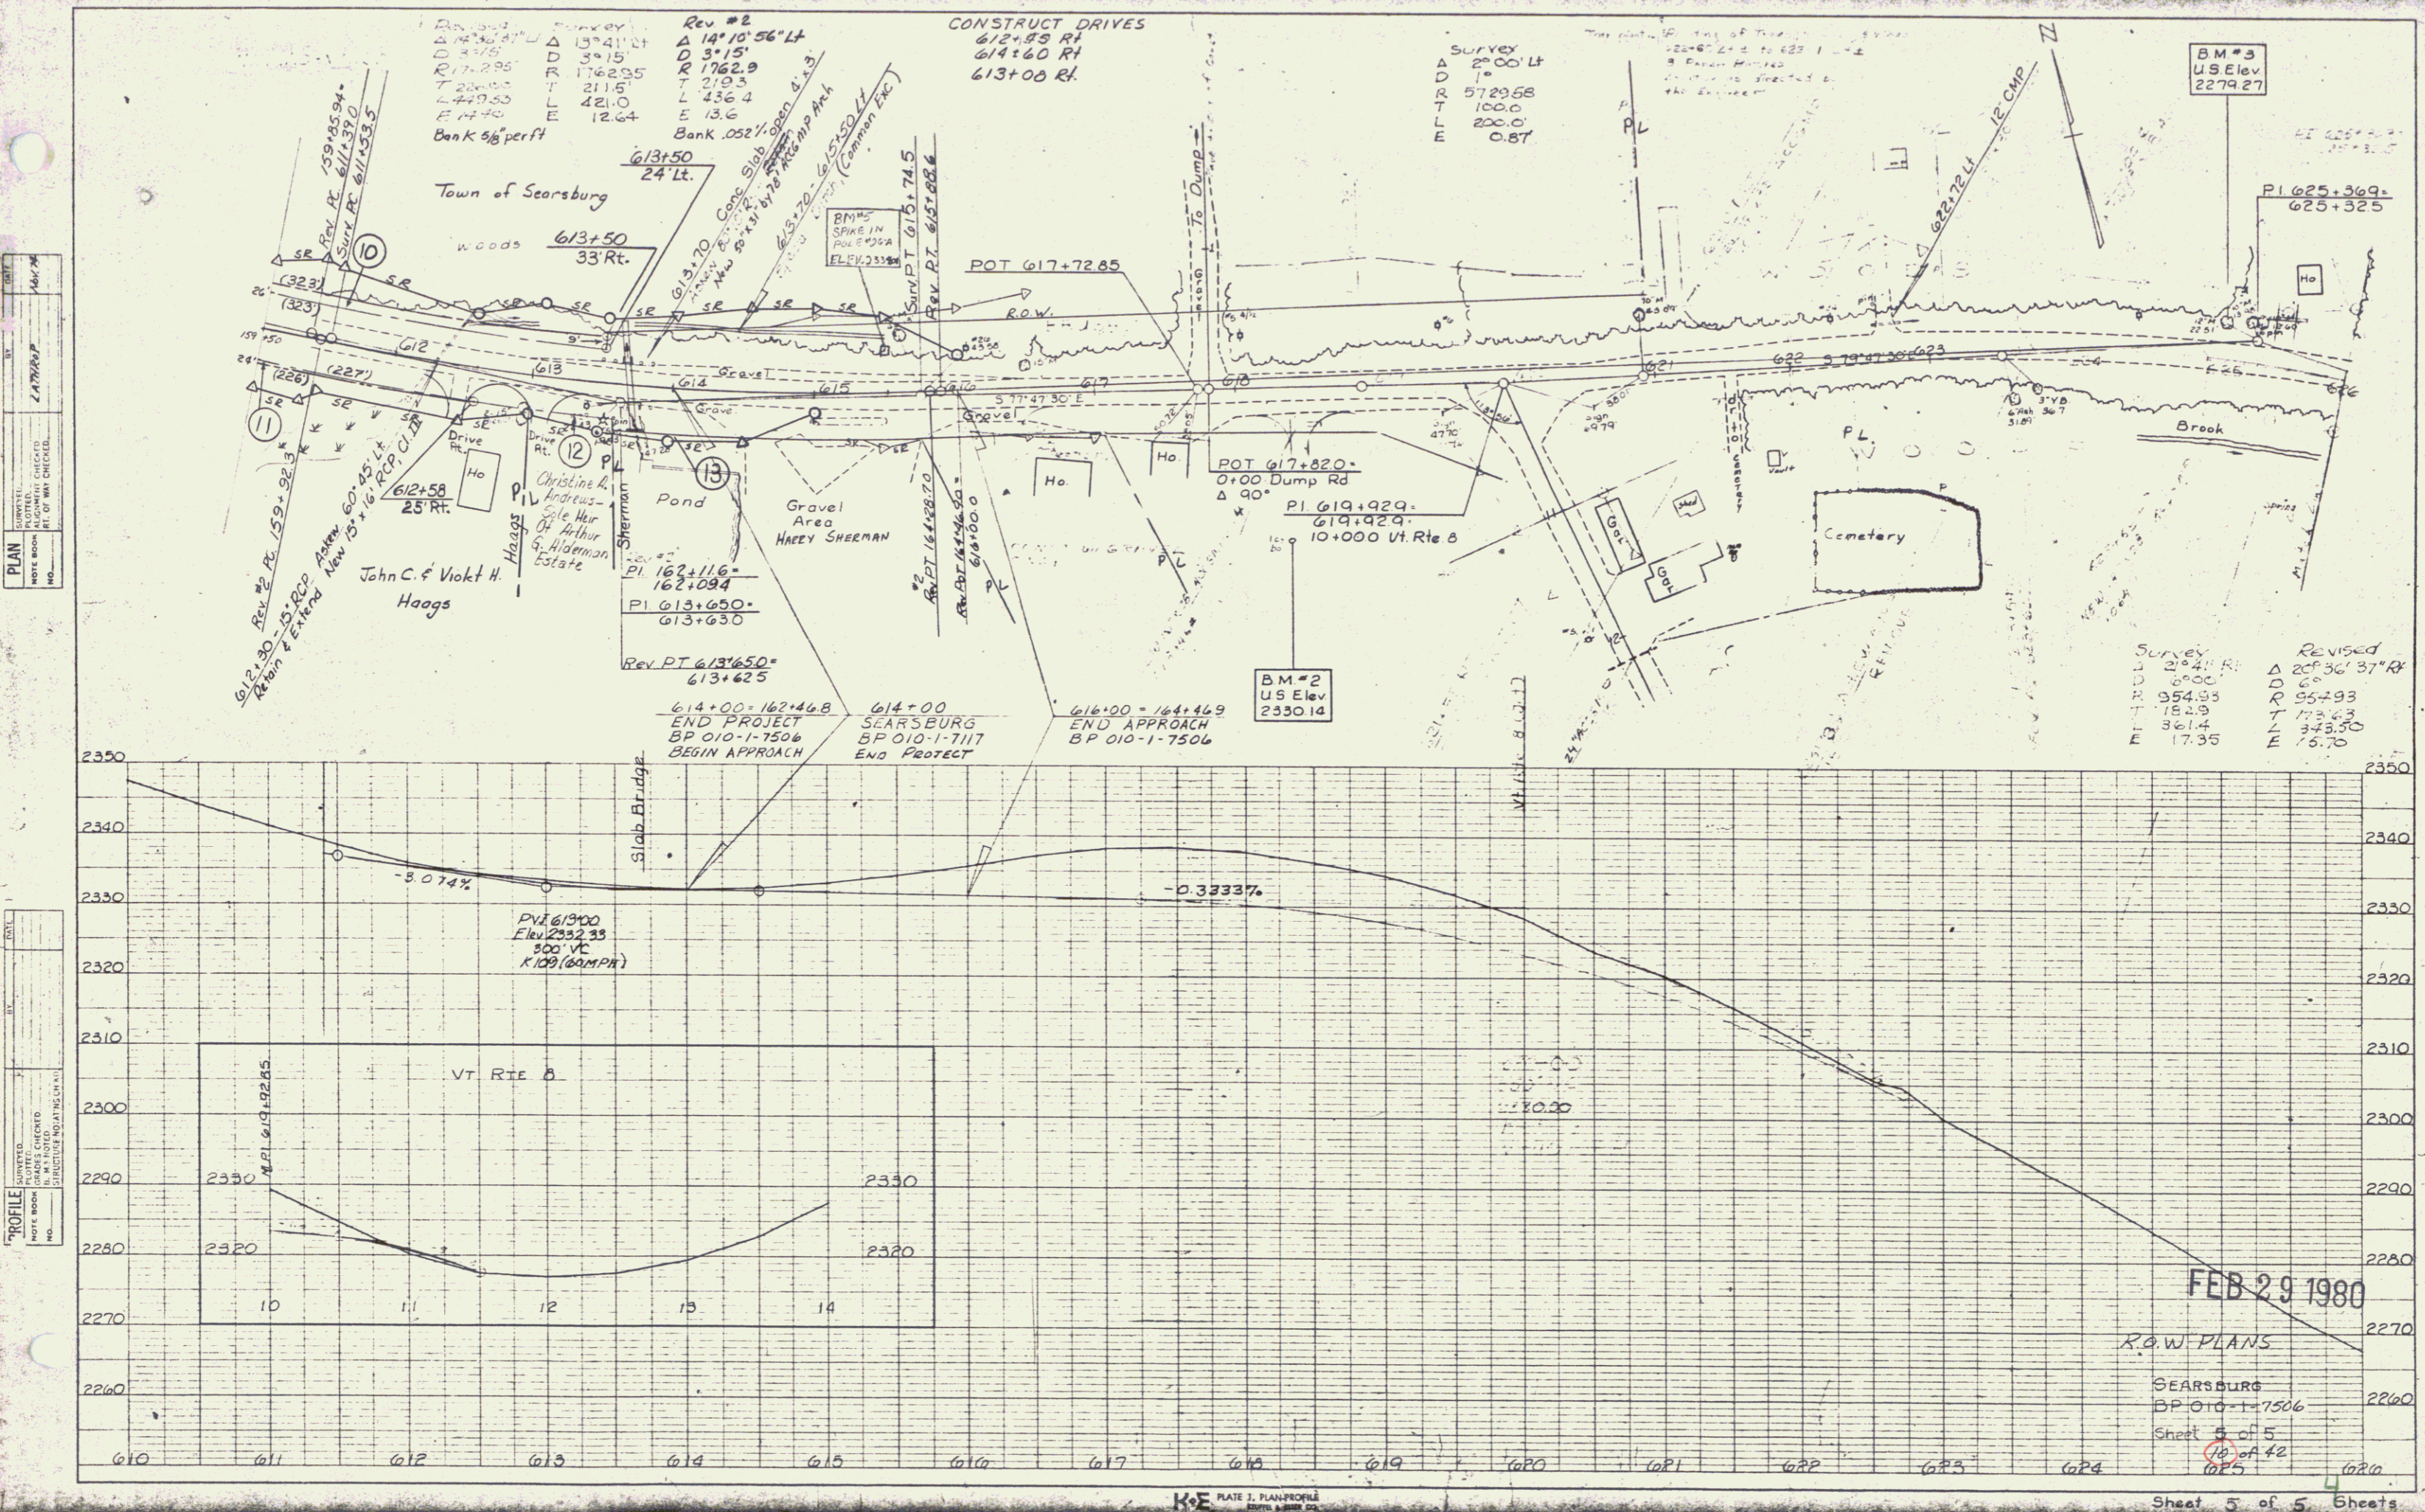

PLAN  

PROFILE  

FEB 29 1980

R.O.W. PLANS  
 SEARSBURG  
 BP 010-1-7506  
 Sheet 5 of 5  
 625

Sheet 5 of 5 Sheets

K&E PLATE 2: PLAN/PROFILE