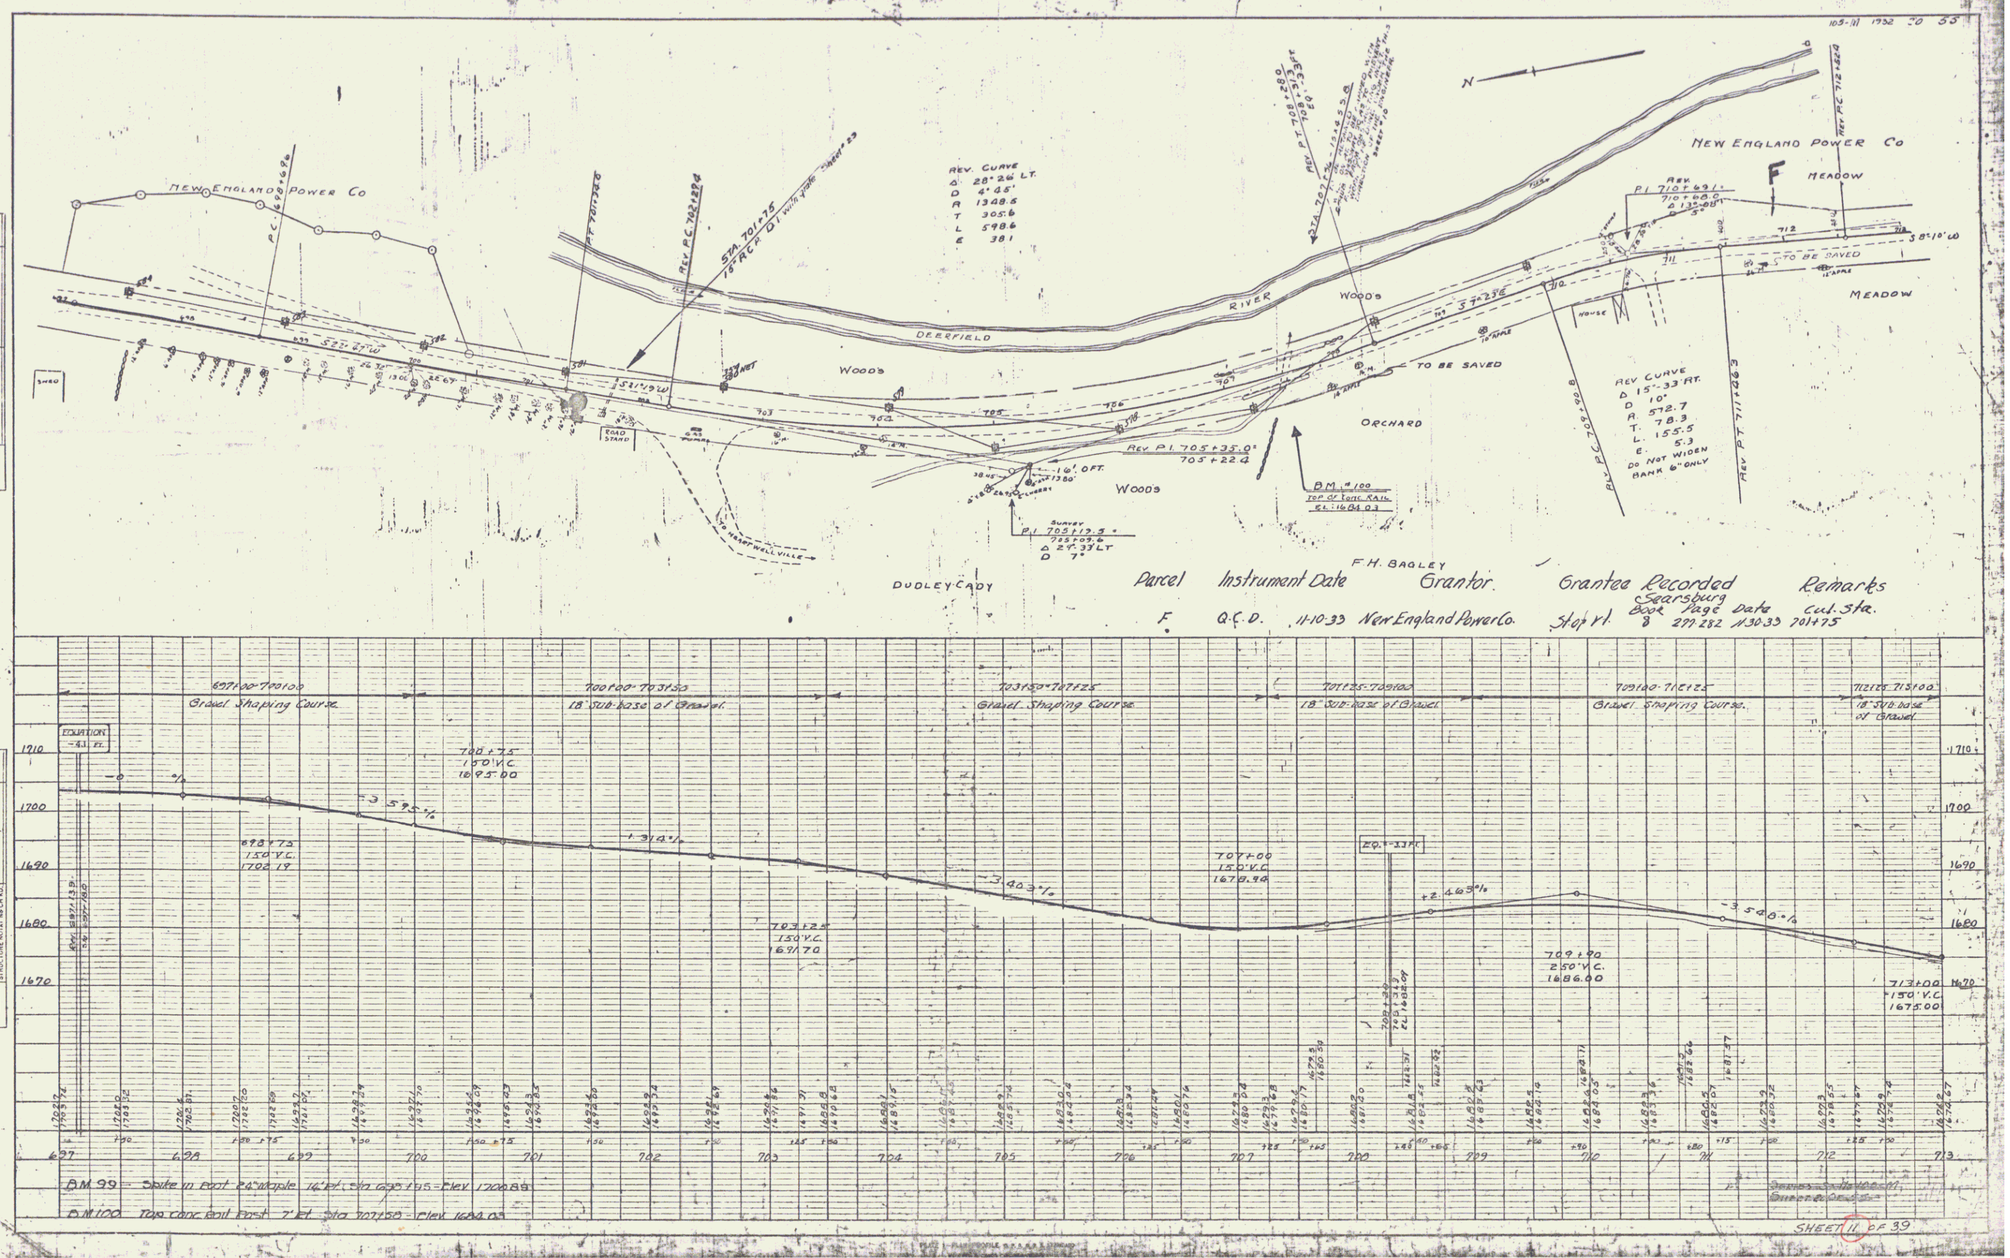

Parcel	Instrument	Date	Grantor	Grantee	Recorded Book	Recorded Page	Date	Remarks Cul. Sta.
F	Q.C.D.	11-10-33	New England Power Co.	Stop rt. Searsburg	8	277 282	11-30-33	701+75

10