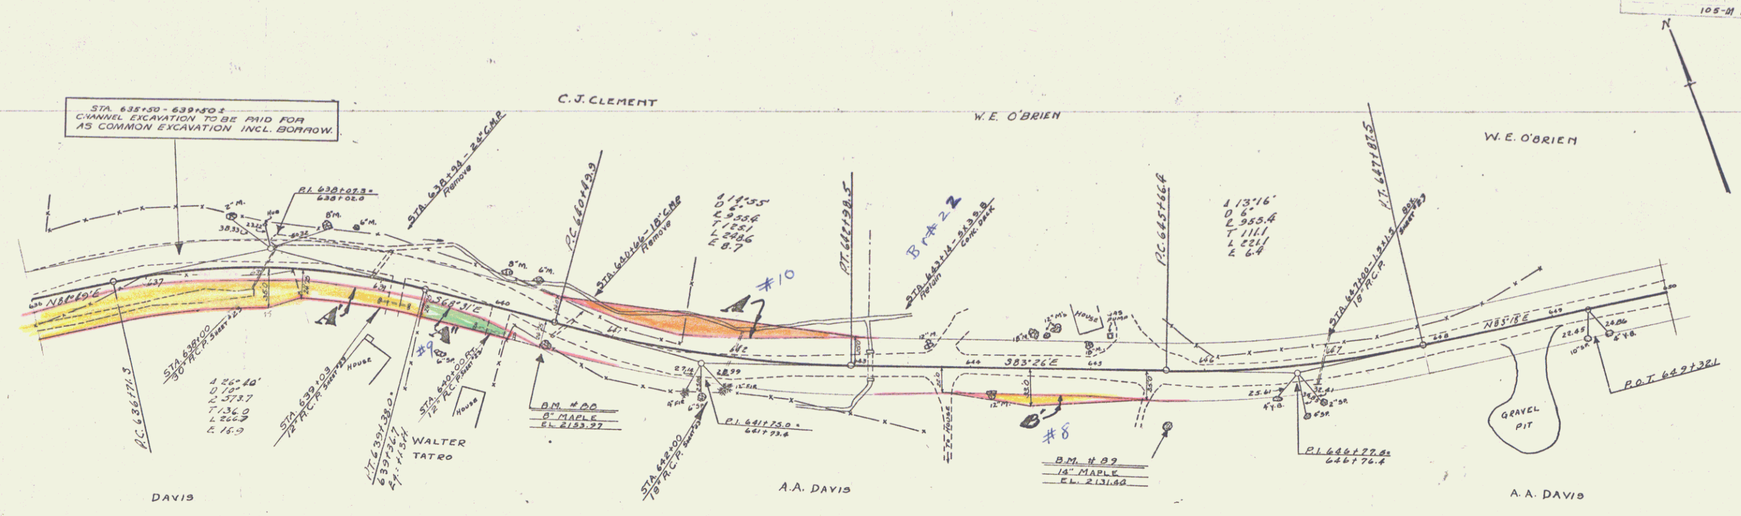

Parcel	Kind of Instrument	Date of Instrument	Grantor	Grantee	Recorded Jeffersburg Book	Page	Date	Remarks
#10 A'	Q.C.D.	9-14-32	C.J. & Jessie Clement	St. of Vt.	8	239	11-21-32	
#8 B'	Q.C.D.	9-14-32	Aida Davis	"	8	238	11-21-32	
#9 A''	Q.C.D.	9-14-32	W.W. & Viola Tatro	"	8	237	11-21-32	

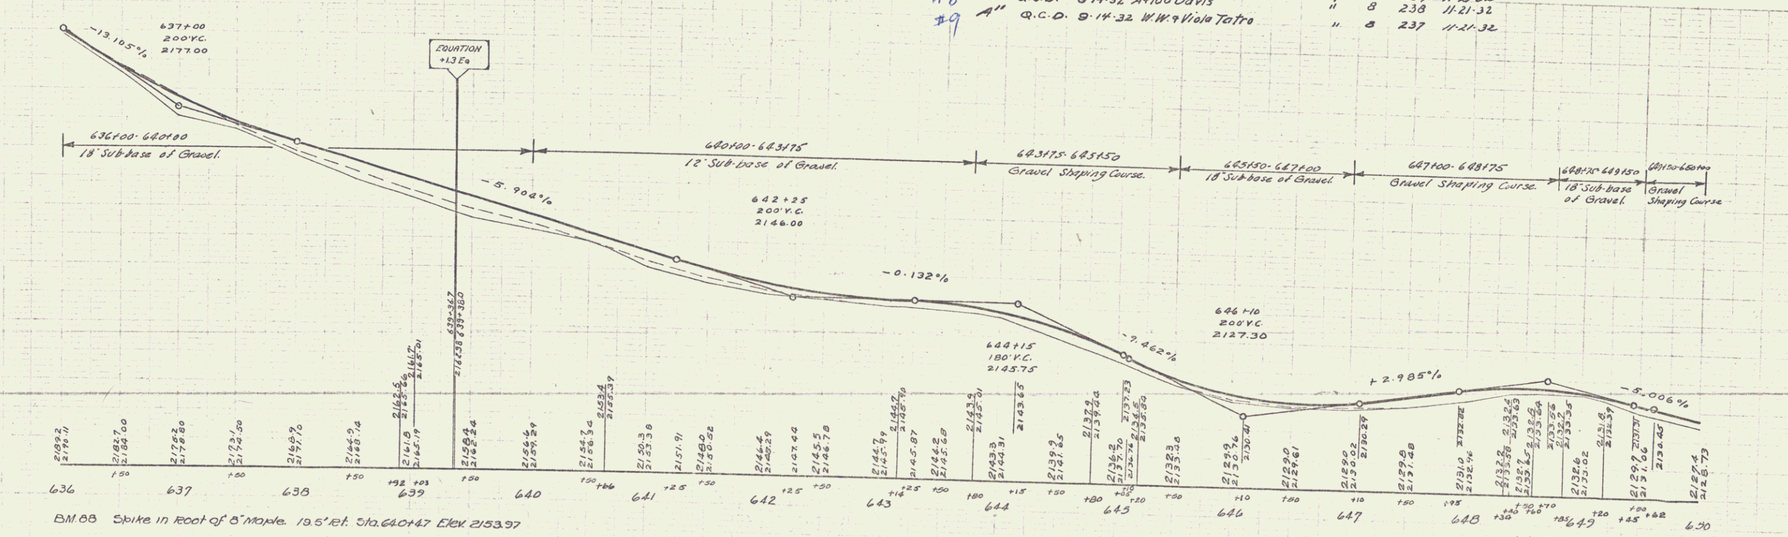

BM.88 Spike in root of 8" Maple. 19.5' Rt. Sta. 640+47 Elev. 2153.97

BM.89 Spike in root of 14" Maple 45.5' Rt. Sta. 645+67 Elev. 2131.44

Series S-No. 105-M
Sheet 15 of 55

15