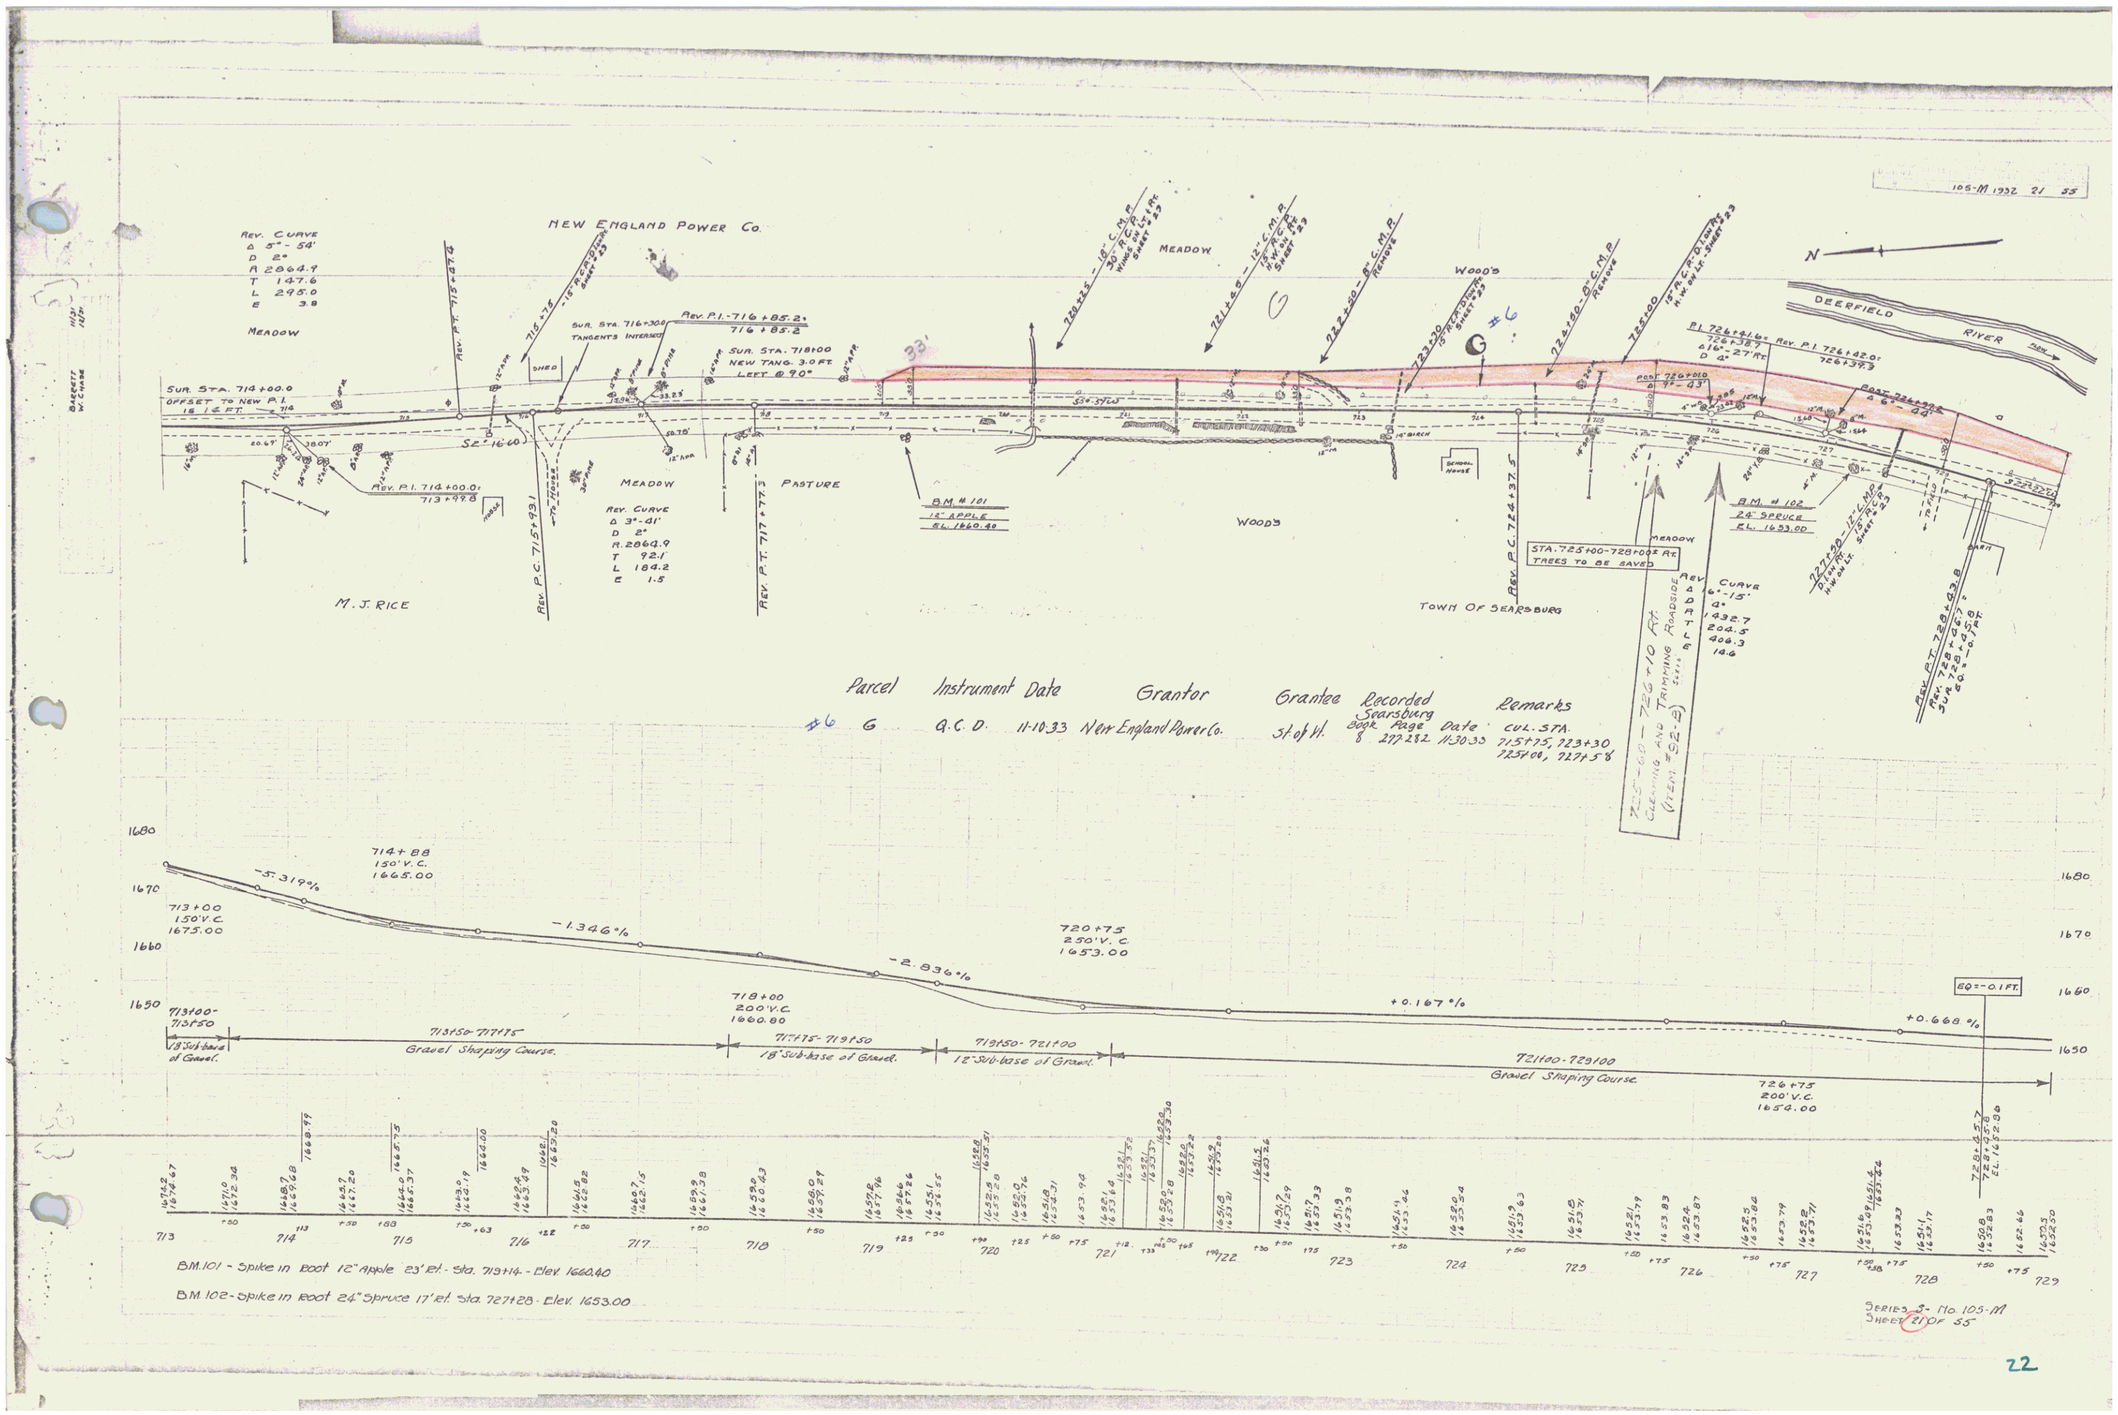
105-M 1932 21 55
NEW ENGLAND POWER Co.
MEADOW
WOODS
DEERFIELD RIVER
N
Rev. Curve
Δ 5°-54'
D 2°
R 2864.9
T 147.6
L 295.0
E 3.8
Sur. Sta. 714+00.0
Offset to New P.I.
18' LEFT
Rev. P.I. 714+00.0
713+99.8
Rev. P.C. 715+93.1
Rev. P.T. 717+77.5
Sur. Sta. 716+300
Tangents Intersect
Rev. P.I. 716+85.2
716+85.2
Sur. Sta. 718+00
New Tang. 3.0 FT
Left @ 90°
S2°-16'E
M. J. RICE
Rev. Curve
Δ 3°-41'
D 2°
R 2864.9
T 92.1
L 184.2
E 1.5
PASTURE
B.M. # 101
12" Apple
EL. 1660.40
Rev. P.C. 724+37.5
STA. 725+00-728+00± Rt.
TREES TO BE SAVED
TOWN OF SEARSBURG
B.M. # 102
24" Spruce
EL. 1653.00
Rev. Curve
Δ 6°-15'
D 4°
R 1432.7
T 206.5
L 406.3
E 14.6
Rev. P.T. 728+63.8
Rev. 728+45.7
Sur. 728+45.7
EQ=-0.1FT.
Parcel Instrument Date Grantor Grantee Recorded Remarks
#6 G Q.C.D. 11-10-33 New England Power Co. State of Vt. Searsburg Book 8 Page 277-282 Date 11-30-33 Cul. Sta. 715+75, 723+30, 725+00, 727+58
1680
1670
1660
1650
714+88
150' V.C.
1665.00
713+00
150' V.C.
1675.00
-5.319%
-1.346%
-2.836%
718+00
200' V.C.
1660.80
720+75
250' V.C.
1653.00
+0.167%
+0.668%
726+75
200' V.C.
1654.00
713+00-713+50
18" Sub-base of Gravel.
713+50-717+75
Gravel Shaping Course.
717+75-719+50
18" Sub-base of Gravel.
719+50-721+00
12" Sub-base of Gravel.
721+00-729+00
Gravel Shaping Course.
B.M. 101 - Spike in Root 12" Apple 23' Rt. - Sta. 719+14 - Elev. 1660.40
B.M. 102 - Spike in Root 24" Spruce 17' Rt. Sta. 727+28 - Elev. 1653.00
Series S - No. 105-M
Sheet 21 of 55

22