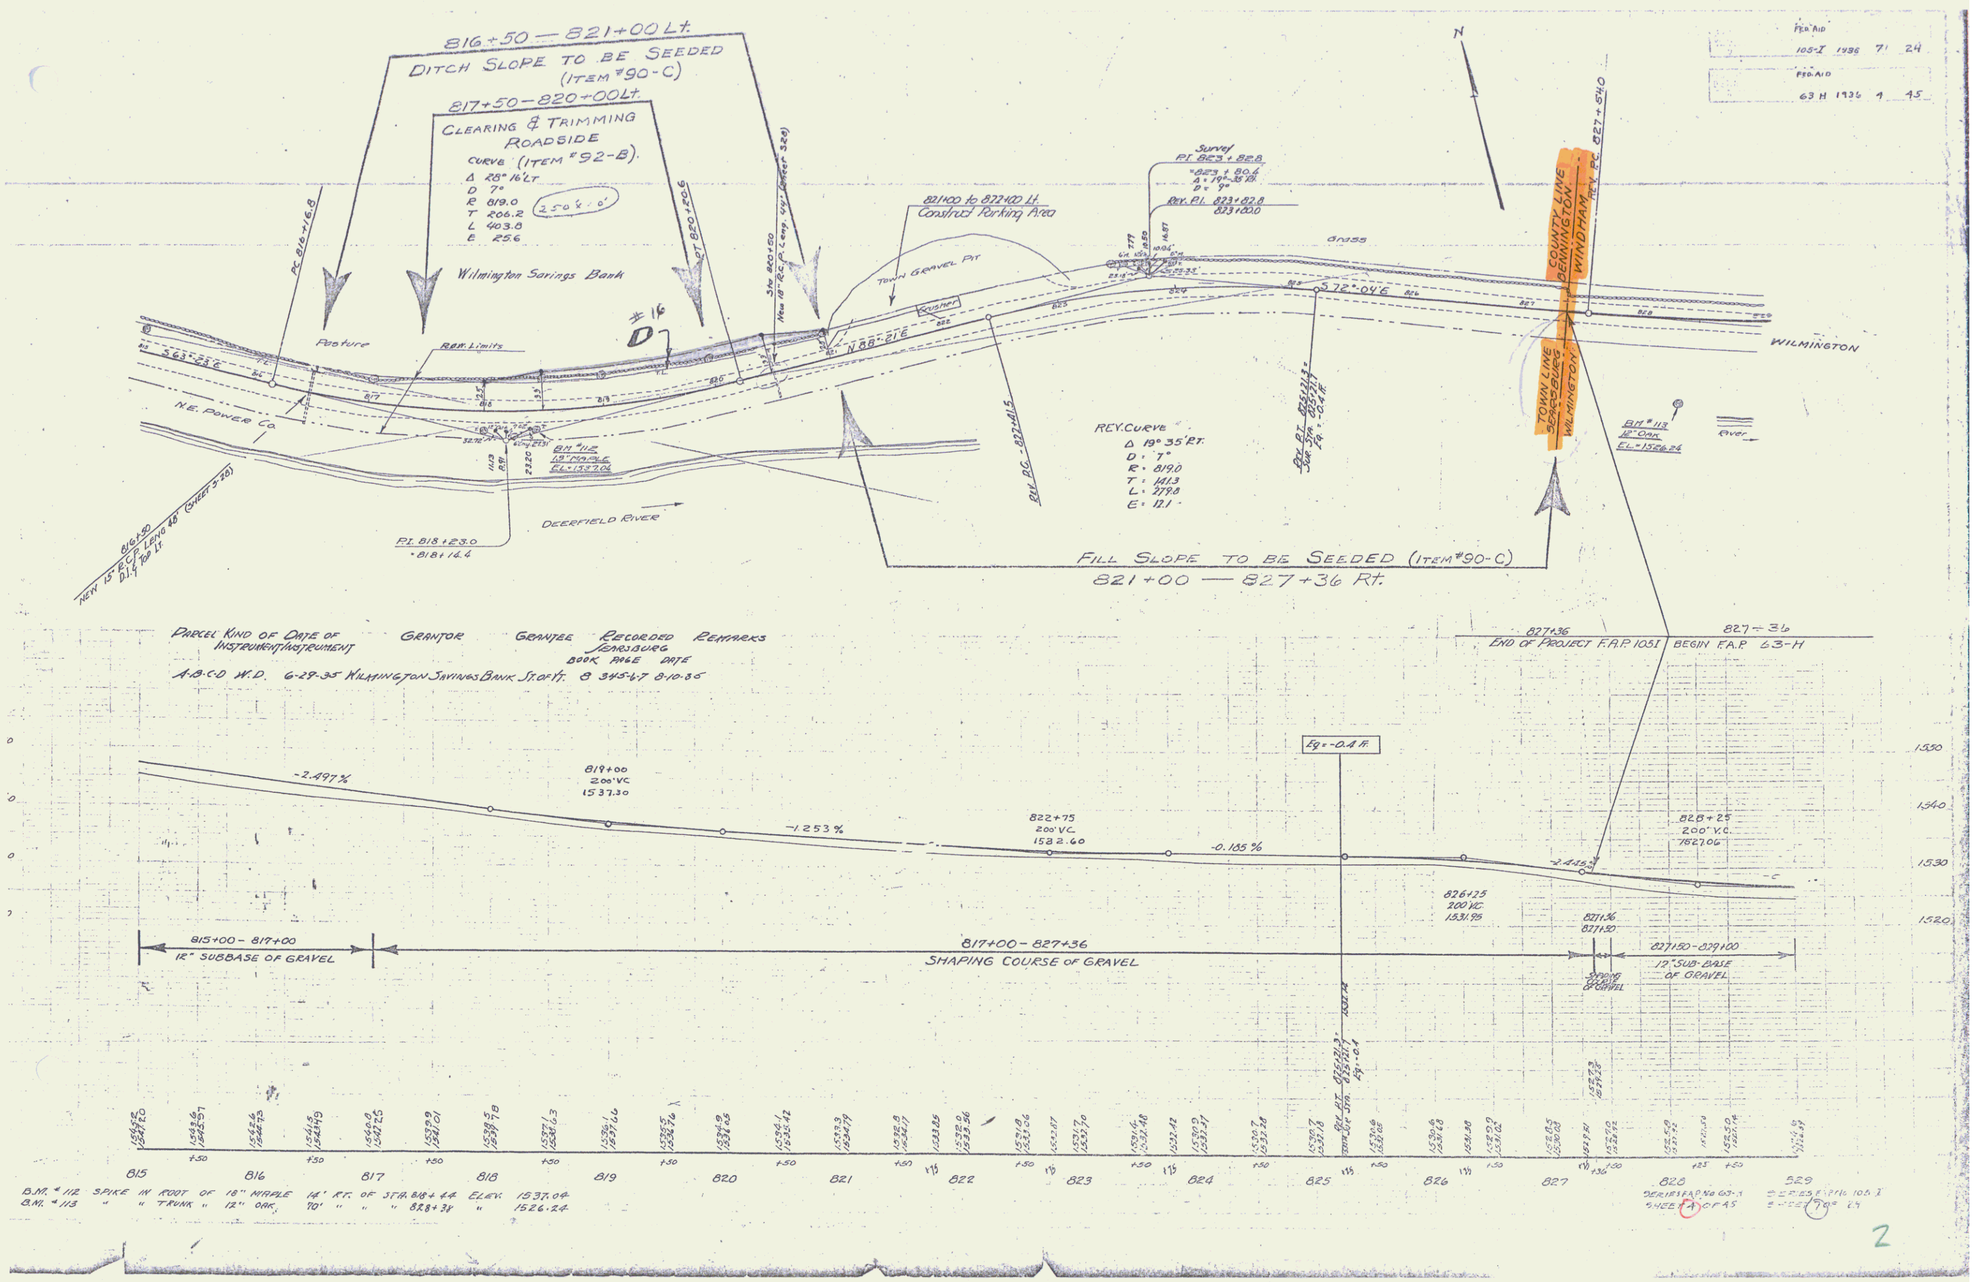
816+50 — 821+00 Lt.
DITCH SLOPE TO BE SEEDED
(ITEM #90-C)
817+50 — 820+00 Lt.
CLEARING & TRIMMING
ROADSIDE
CURVE (ITEM #92-B).
Δ 28° 16' Lt.
D 7°
R 819.0
T 206.2
L 403.8
E 25.6
Wilmington Savings Bank
PC 816+16.8
PT 820+20.6
Pasture
R.W. Limits
N.E. Power Co.
DEERFIELD RIVER
P.I. 818+23.0
818+16.4
821+00 to 827+00 Lt.
Construct Parking Area
TOWN GRAVEL PIT
N 88° 21' E
BVL PC - 821+41.5
REV. CURVE
Δ 19° 35' RT.
D 7°
R 819.0
T 141.3
L 279.8
E 12.1
FILL SLOPE TO BE SEEDED (ITEM #90-C)
821+00 — 827+36 Rt.
Survey
PT 822+82.8
Rev. P.I. 823+87.8
833+00.0
S 72° 04' E
GRASS
COUNTY LINE
WINDHAM
TOWN LINE
SEARSBURG
WILMINGTON
WILMINGTON
River
BM #113
12" OAK
EL. = 1526.24
N
FED. AID
105-I 1936 71 24
FED. AID
63 H 1936 1 45
827+36
END OF PROJECT F.A.P. 105I
827+36
BEGIN F.A.P. 63-H
PARCEL KIND OF INSTRUMENT DATE OF INSTRUMENT GRANTOR GRANTEE RECORDED BOOK PAGE DATE REMARKS
A.B.C.D. W.D. 6-29-35 Wilmington Savings Bank Jr. of Vt. SEARSBURG 8 345-6-7 8-10-35
-2.497 %
819+00
200' VC
1537.20
-1.253 %
822+75
200' VC
1532.60
-0.185 %
Eq = -0.4 ft.
826+25
200' VC
1531.25
828+25
200' VC
1527.06
827+36
827+50
827+50 - 829+00
12" SUB-BASE OF GRAVEL
815+00 - 817+00
12" SUBBASE OF GRAVEL
817+00 - 827+36
SHAPING COURSE OF GRAVEL
1,550
1,540
1,530
1,520
815
816
817
818
819
820
821
822
823
824
825
826
827
828
829
B.M. #112 SPIKE IN ROOT OF 18" MAPLE 14' R.R. OF STA. 818+44 ELEV. 1537.04
B.M. #113 " " TRUNK " 12" OAK 70' " " " 828+38 " 1526.24
SHEET 1 OF 45
2