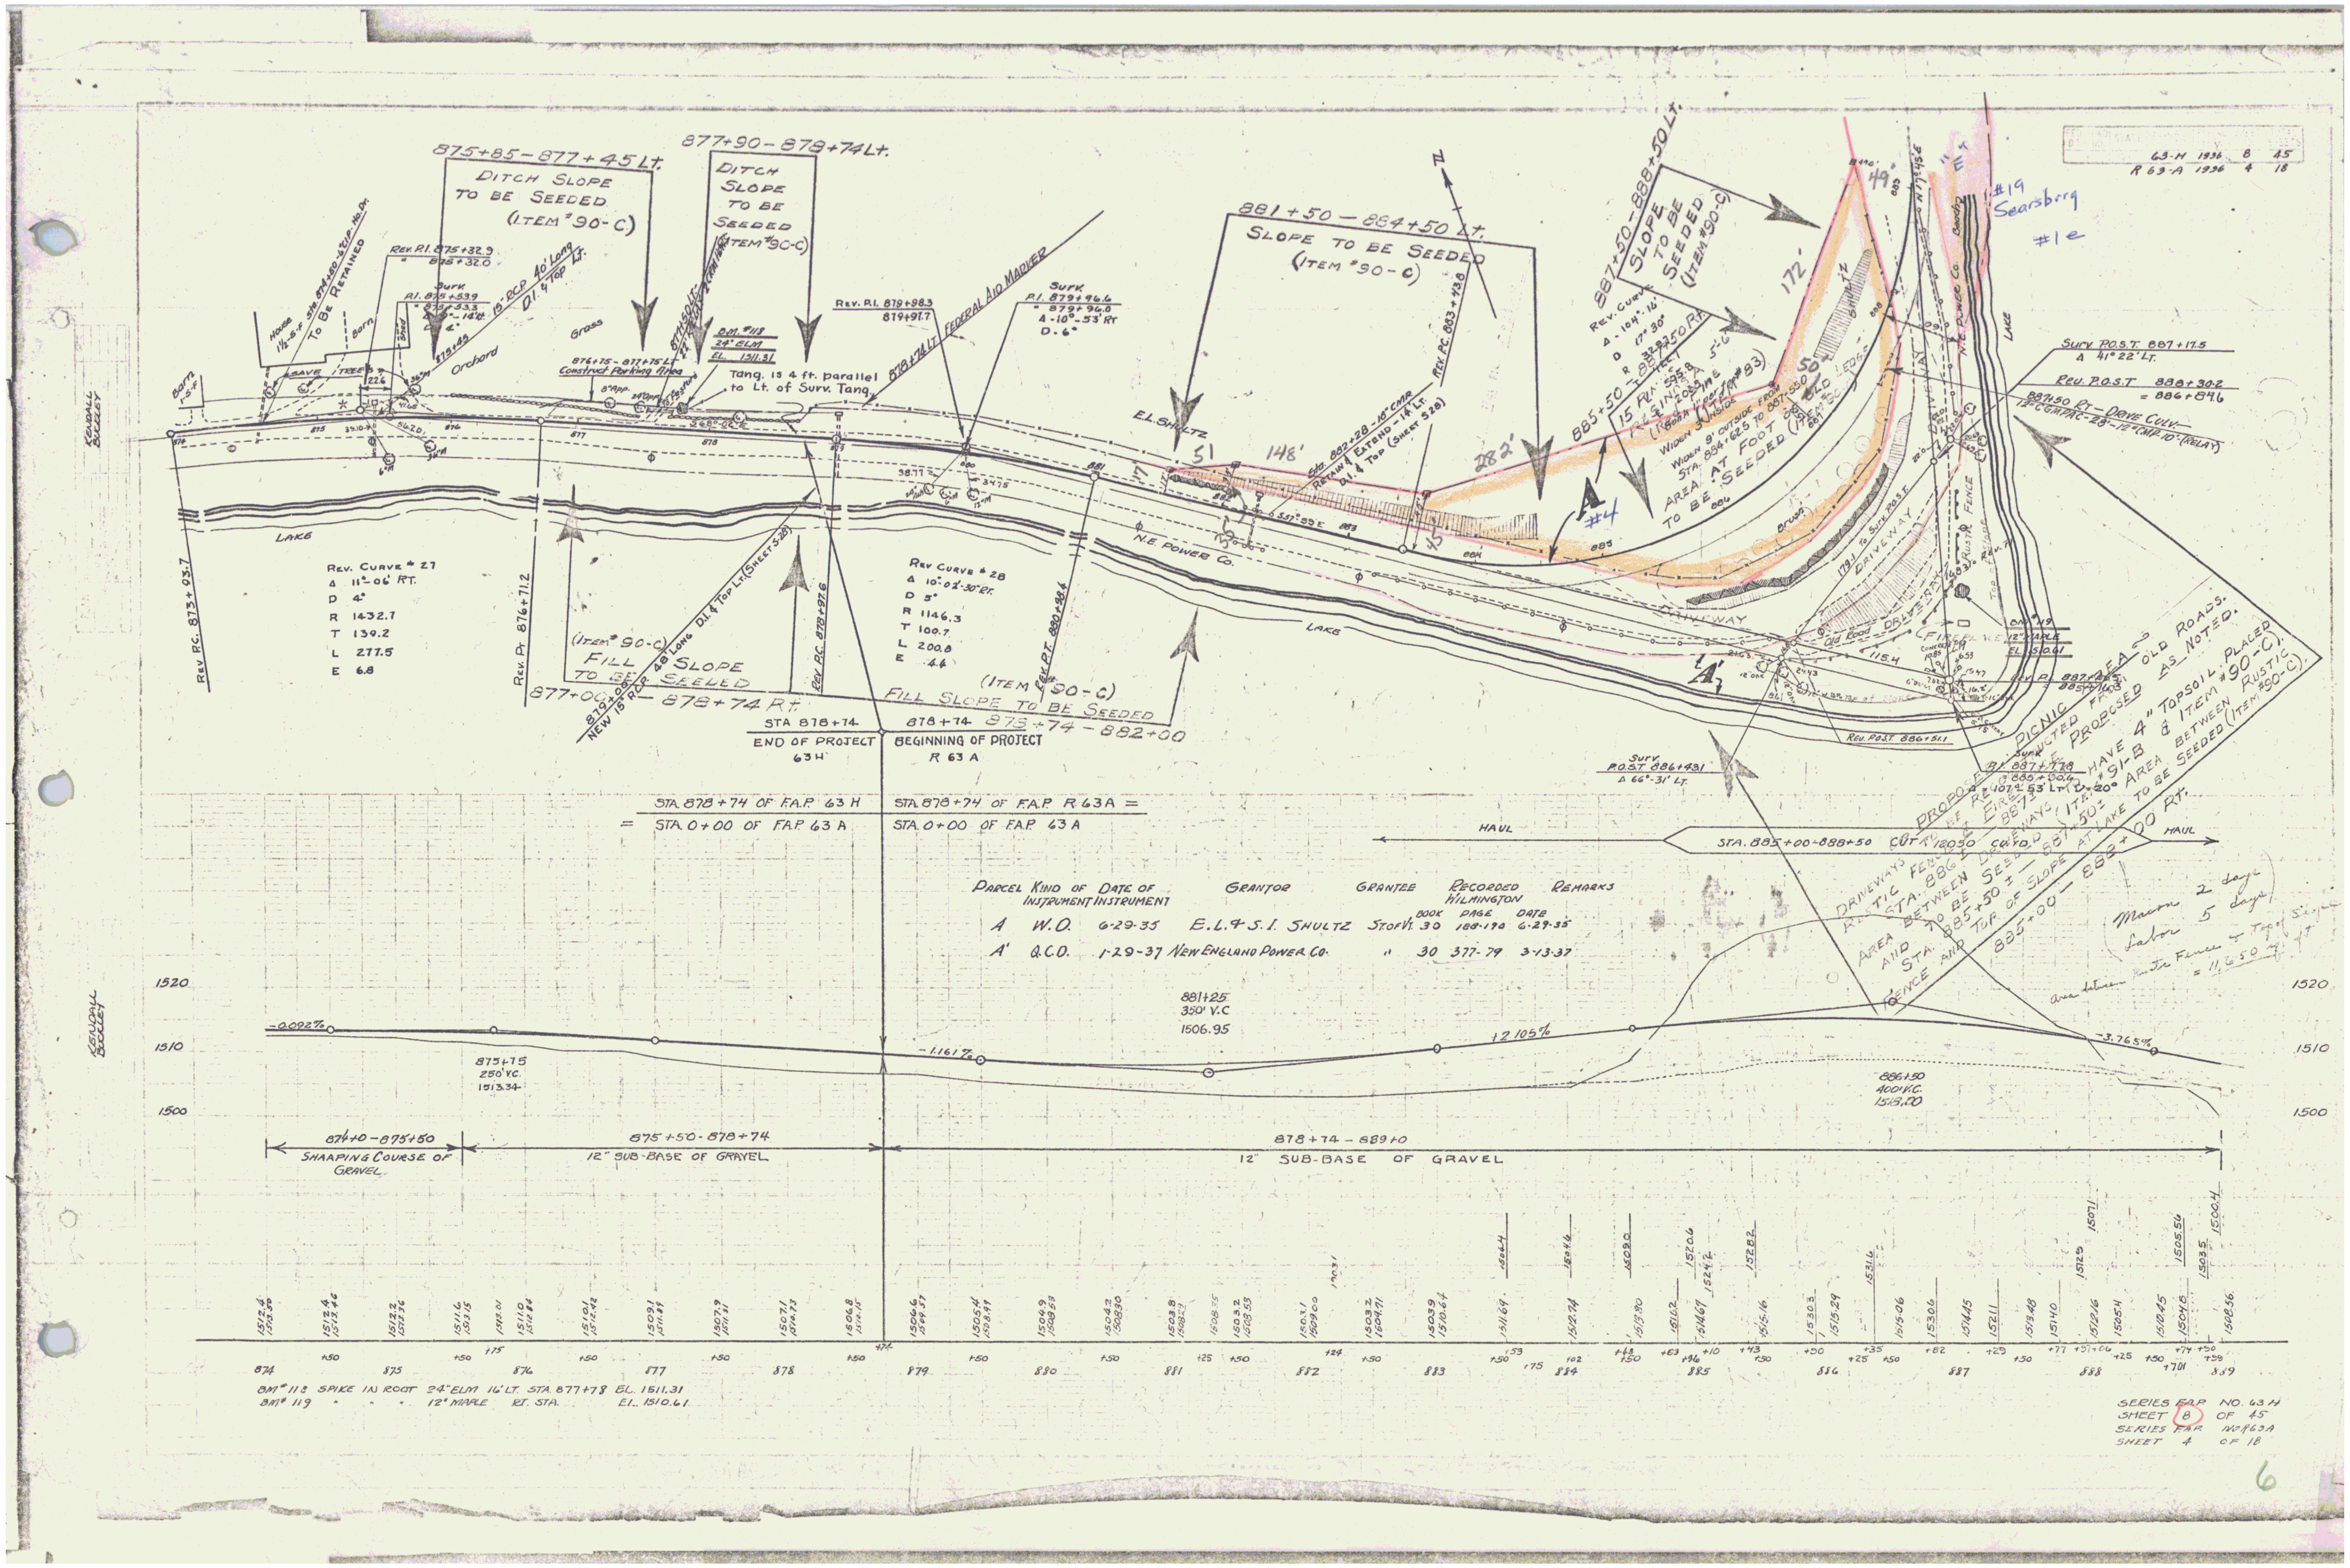

Parcel	Kind of Instrument	Date of Instrument	Grantor	Grantee	Recorded Wilmington Book	Page	Date	Remarks
A	W.D.	6-29-35	E.L. & S.I. Shultz	St. of Vt.	30	188-190	6-29-35	
A'	Q.C.D.	1-29-37	New England Power Co.	"	30	377-79	3-13-37	

63-H	1936	8	45
R 63-A	1936	4	18

SERIES F.A.P. NO. 63 H
SHEET 8 OF 45
SERIES F.A.P. NO. R63A
SHEET 4 OF 18

6