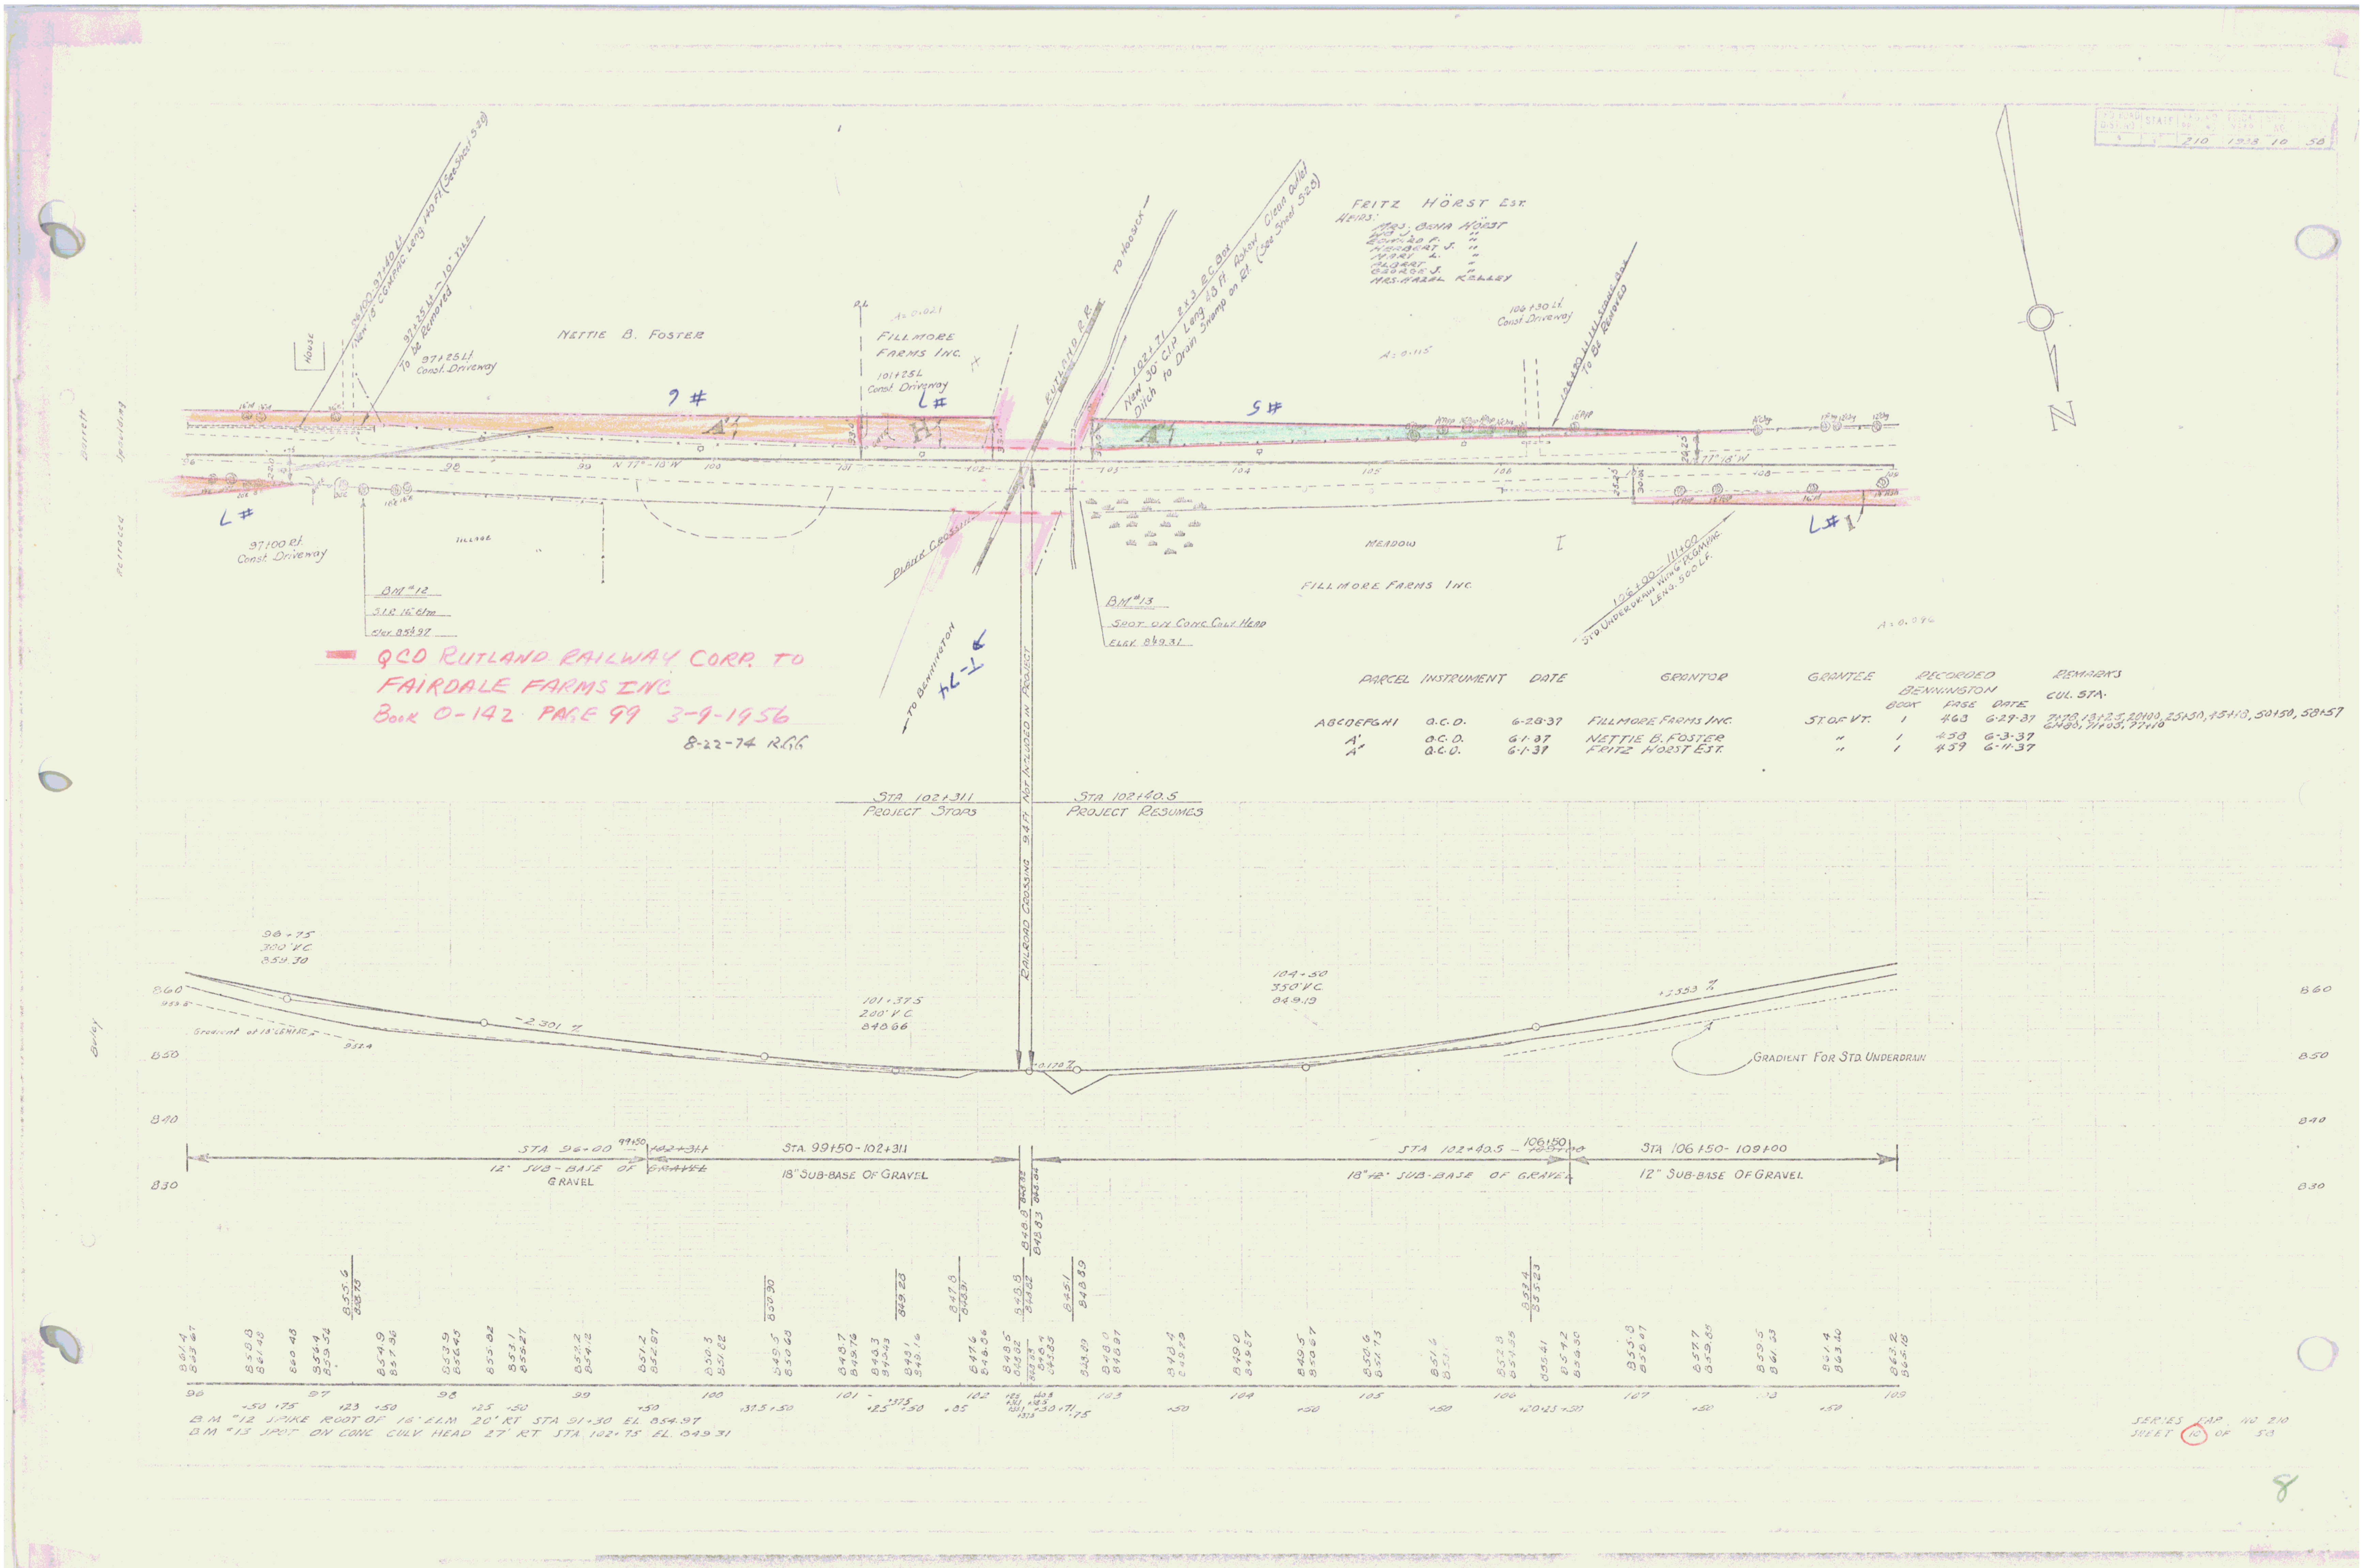
NETTIE B. FOSTER
FILLMORE FARMS INC.
FRITZ HÖRST Est.
MEADOW
FILLMORE FARMS INC.
TILLAGE
97+00 Rt. Const. Driveway
BM #12
S.I.R. 16" Elm
Elev 854.97
BM #13
SPOT ON CONC CULV HEAD
ELEV 849.31
QCD RUTLAND RAILWAY CORP. TO
FAIRDALE FARMS INC
Book O-142 PAGE 99 3-9-1956
8-22-74 R.G.G.
106+00 — 111+00 STD. UNDERDRAIN WITH 6" P.C.G.M.P. LENG. 500 L.F.
A = 0.096
PARCEL INSTRUMENT DATE GRANTOR GRANTEE RECORDED BENNINGTON BOOK PAGE DATE REMARKS CUL. STA.
ABCDEFGHI Q.C.D. 6-28-37 FILLMORE FARMS INC. ST. OF VT. 1 468 6-29-37 7+78, 13+25, 20+00, 25+50, 45+18, 50+50, 58+57 64+80, 71+05, 77+10
A' Q.C.D. 6-1-37 NETTIE B. FOSTER " 1 458 6-3-37
A" Q.C.D. 6-1-37 FRITZ HORST EST. " 1 459 6-11-37
STA 102+31 PROJECT STOPS
STA 102+60.5 PROJECT RESUMES
GRADIENT FOR STD. UNDERDRAIN
12" SUB-BASE OF GRAVEL
18" SUB-BASE OF GRAVEL
12" SUB-BASE OF GRAVEL