POOR ORIGINAL COPY

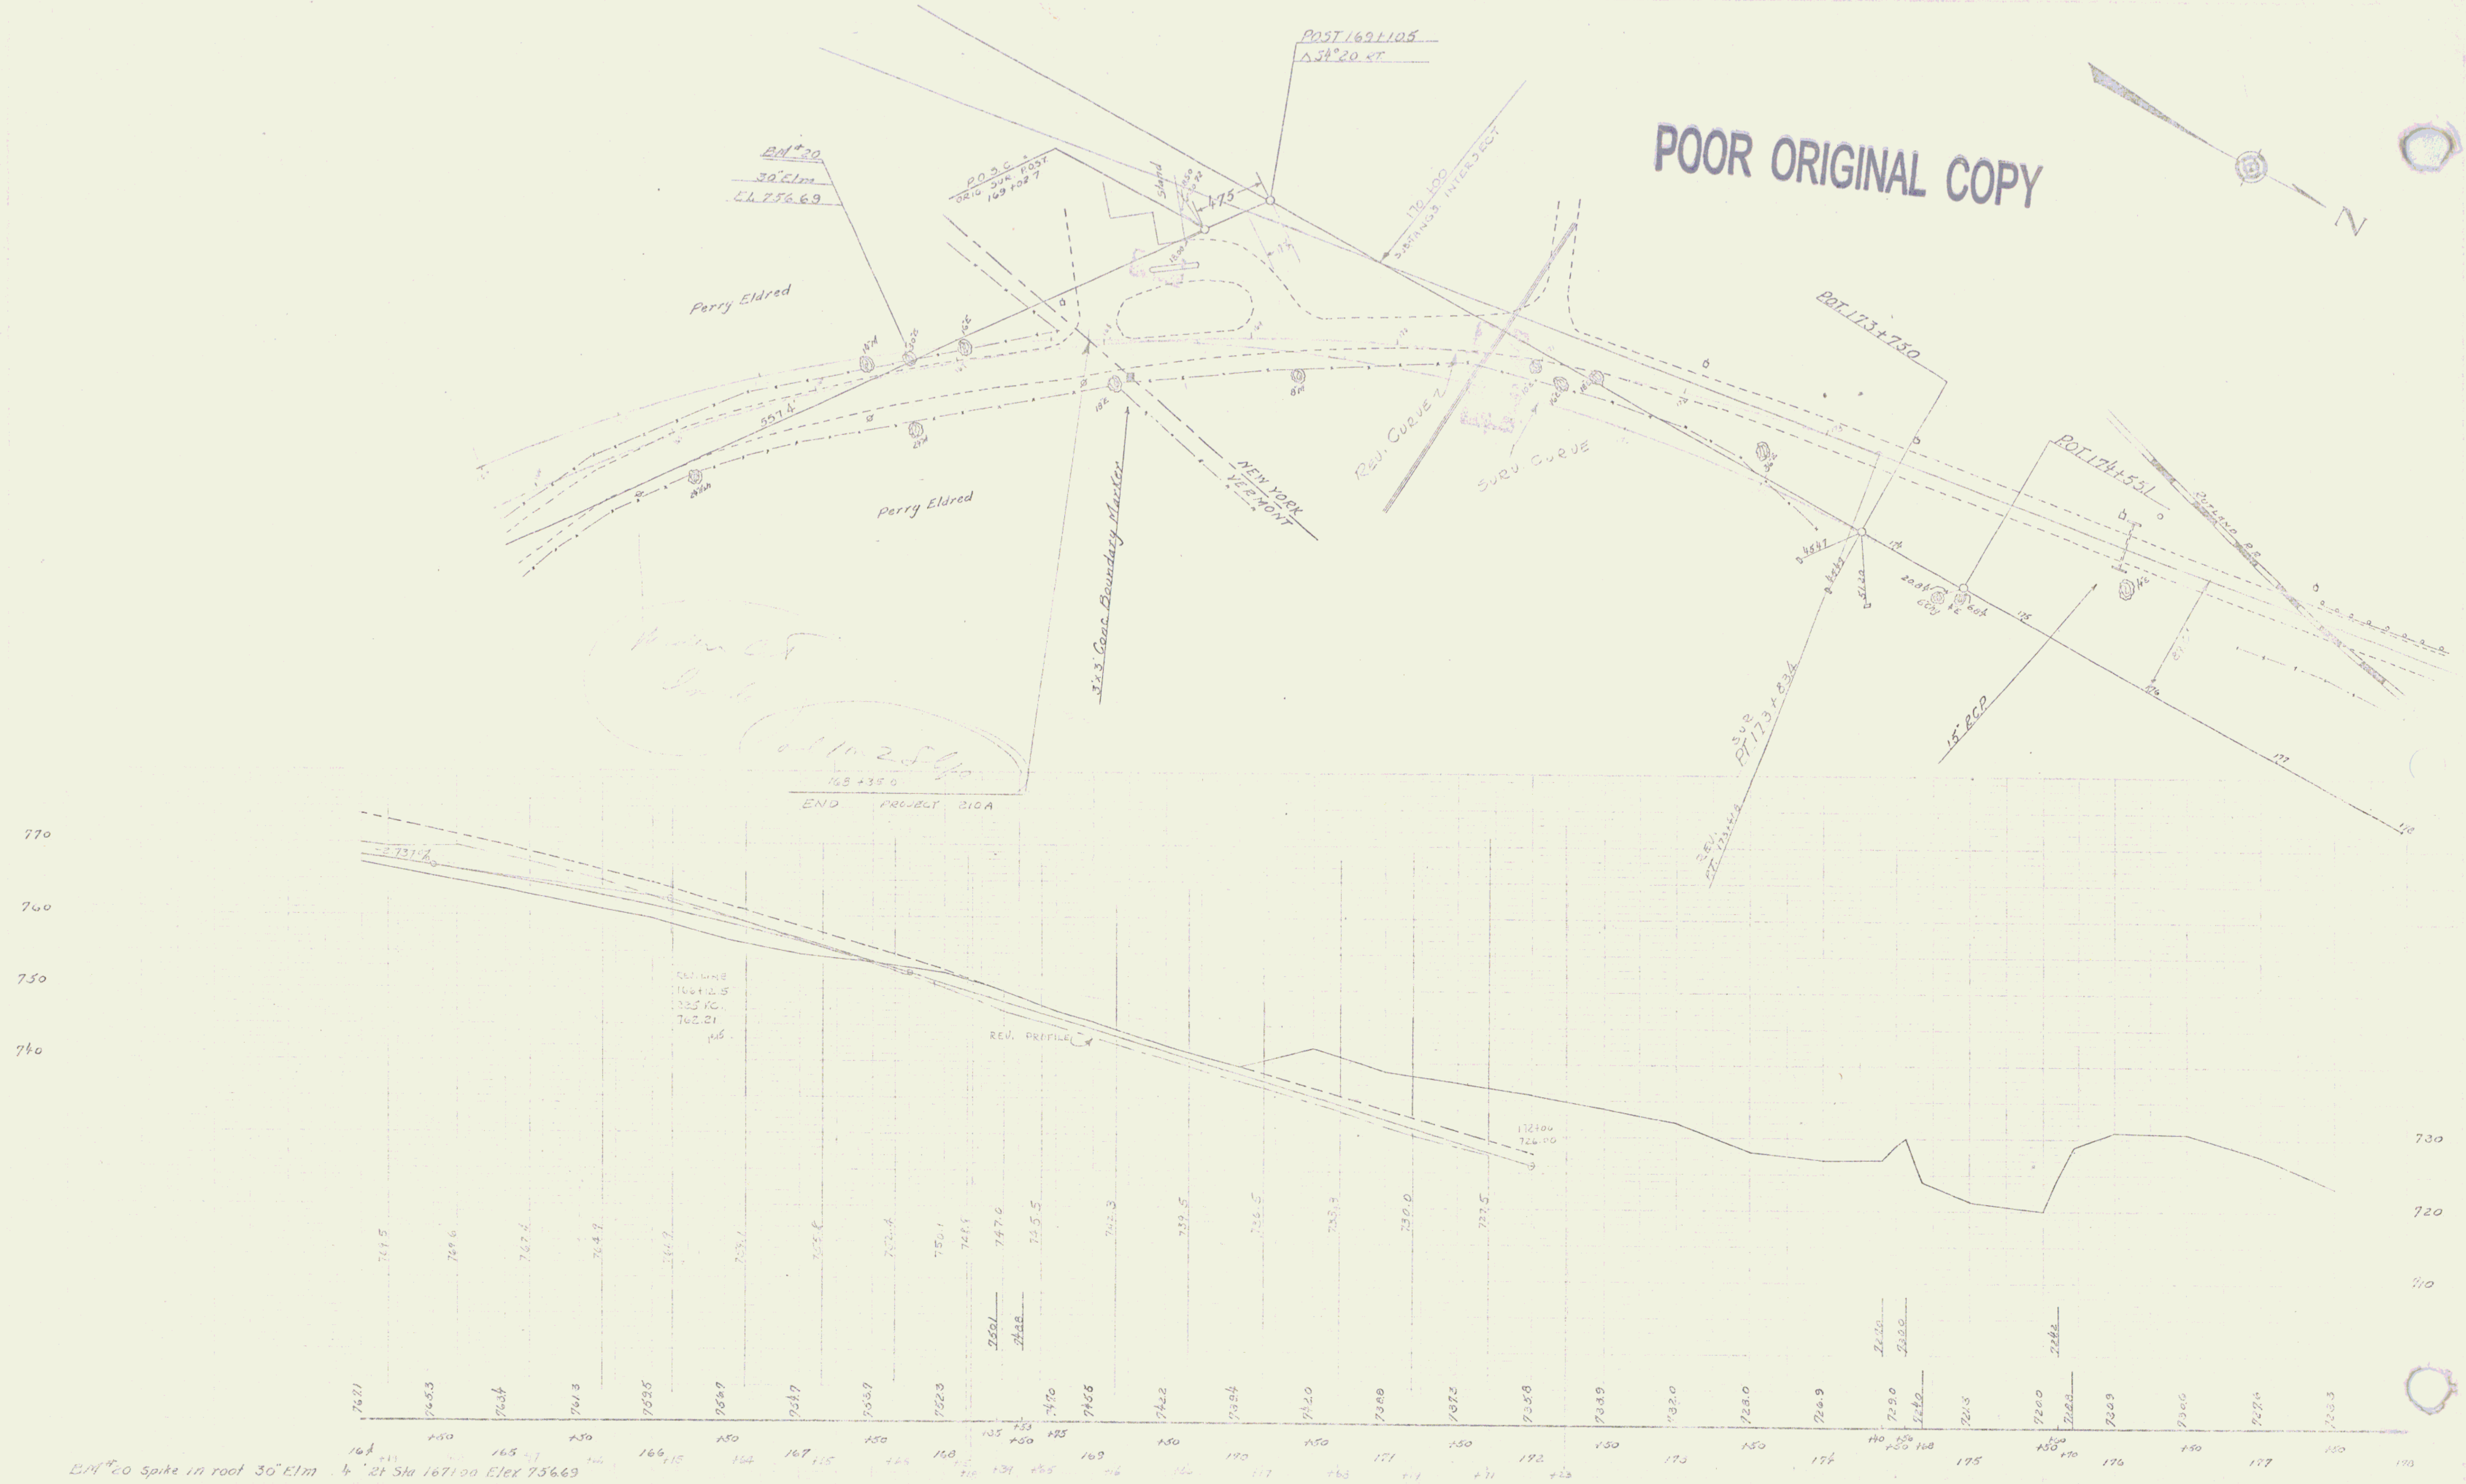

BM #20 Spike in root 30" Elm 4' Rt Sta 167+00 Elev 756.69

Sheet 15B

15