FED. ROAD DIST. NO.	STATE	FED. AID PROJ. NO.	FISCAL YEAR	SHEET NO.	TOTAL SHEETS
9	VT.	105C(1)	1940	5	41

NOTE – C.R.M. WALL

Existing masonry wall on the left of Sta. 114+80 to 117+50± is to be removed. This work is to be paid for as Solid Rock Excavation Item 10.

A new stone masonry wall, to be paid for as Cement Rubble Masonry, Item 45, is to be built on the left of Sta. 114+80 to 117+50±. This wall is to be at the location shown on the cross-sections and is to be built to the same general dimensions as the present wall. The stone as used in the construction of the new wall shall be such as to give a wall of the same general surface appearance as the present wall. The stones in the present wall may, if satisfactory to the Engineer, be salvaged and used in the new construction.

The granite slabs on top of the present gate posts shall be removed and reset on top of the new wall posts. If damaged by the Contractor, they shall be replaced at the Contractor's own expense. The removal and resetting of these granite slabs shall be paid for as Cement Rubble Masonry for the yardage in said slabs.

The iron gates at Sta. 115+40± shall be removed, stored and reset in the new gate posts in a manner approved by the Engineer. The cost of this work shall be included in the bid price for Cement Rubble Masonry.

The approach on the left of Sta. 115+40± is to be graded to meet the requirements of the Engineer and 12" of Sub-base of Gravel is to be used on this approach. The fill slopes on either side of the approach are to be covered with 12" of borrow or excavation suitable for growing grass.

TYPICAL SECTION OF C.R.M. WALL STA. 114+80-117+50± L.T.

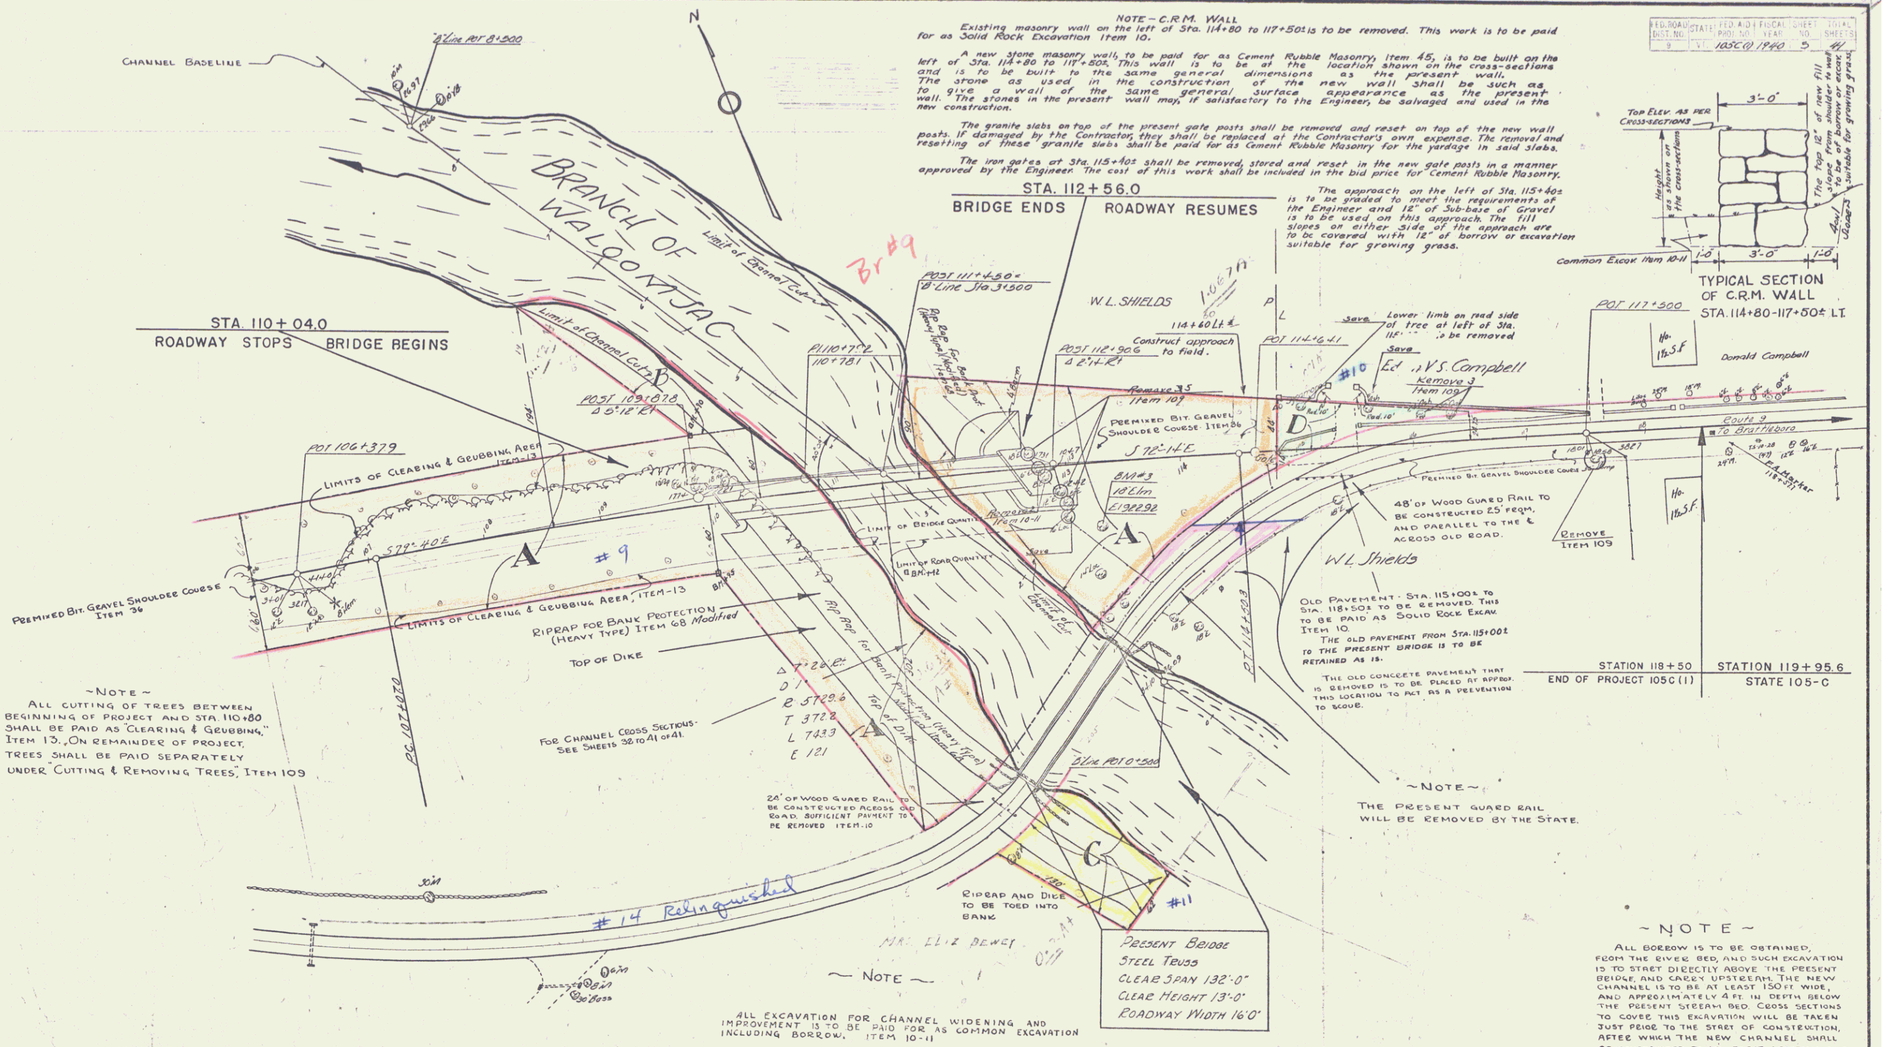

	PARCEL	INSTRUMENT	DATE	GRANTOR	GRANTEE	RECORDED BOOK	RECORDED PAGE	RECORDED DATE	REMARKS
#9	A & B	W.D.O.E.	7-6-40	W.L. SHIELDS & ANNA T. SHIELDS	ST. OF VT.	1	542	7-6-40	
#11	C	W.D.O.E.	7-15-40	MRS. ELIZABETH D. DEWEY	ST. OF VT.	1	549	7-18-40	
#10	D	W.D.O.E.	7-6-40	DONALD A. CAMPBELL AND EDITH V.S. CAMPBELL	ST. OF VT.	1	544	7-6-40	

ESTIMATED QUANTITIES

Surveyed by Borell, Lane
Designed by
Drawn by L. Lovin
Traced by L. Lovin
Checked by
Series F.A.P. No. 105C(1) Filed
Sheet 5 of 41 Sheets

3