FED. ROAD DIST. NO.	STATE	STATE FOR. NO.	FISCAL YEAR	SHEET NO.	TO AL SHEETS
1	VT		FR8A 1929	3	48

WOOD GUARD RAIL REQUIRED

ON LEFT
STA.-3+63 – STA.-5+87 LENGTH 24 FT.
ON RIGHT
STA.-3+63 – STA.-3+87 LENGTH 24 FT.
TOTAL FOR SHEET LENGTH 48 FT.

NEW CULVERTS REQUIRED

STA.-3+73 ± 24" Cast Iron Pipe Length 40 Ft.
Concrete Class A (1:2:4) 4.8 Cu Yds.
Reinforcing Steel 58 Lbs.

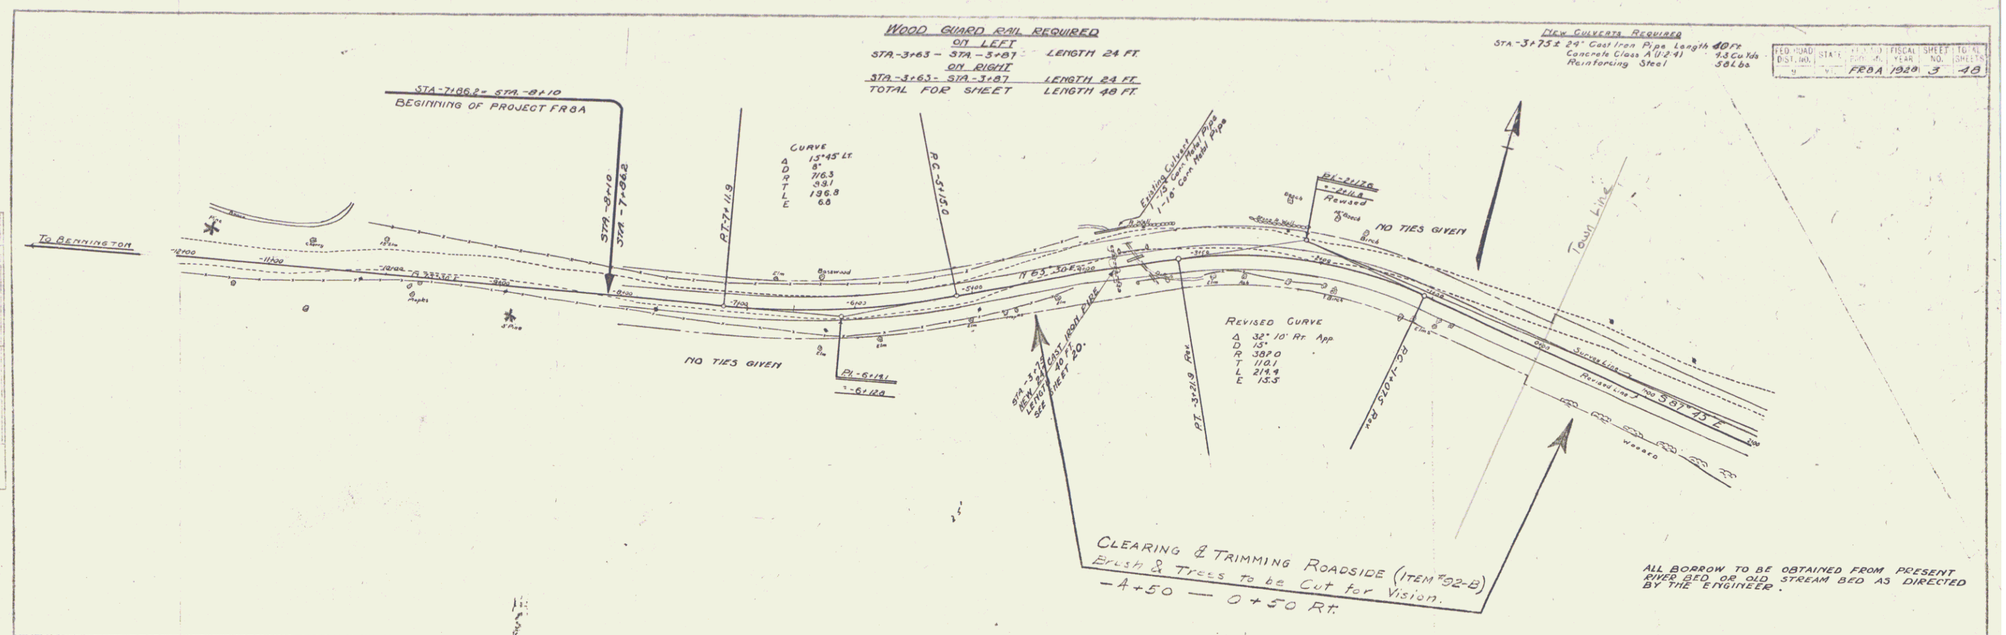

ALL BORROW TO BE OBTAINED FROM PRESENT RIVER BED OR OLD STREAM BED AS DIRECTED BY THE ENGINEER.

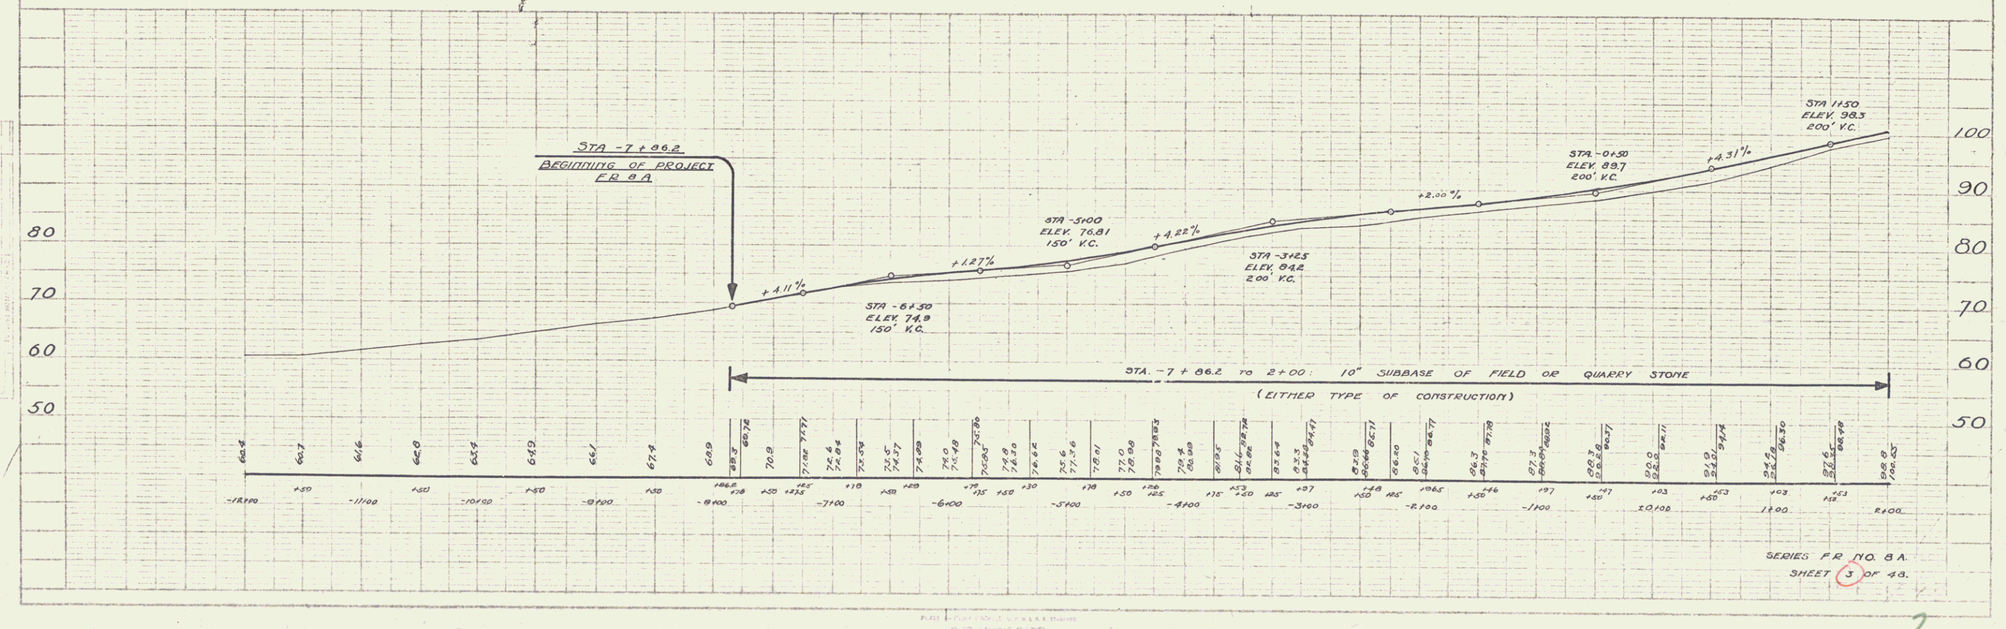

2