


PARCEL	INSTRUMENT	DATE	GRANTOR	GRANTEE	RECORDED	REMARKS
7	C.D.	W.D.	10-11-40	T.J. MALLORY	ST. OF W.	761-55 10-28-40
8	A.	W.D.	10-10-40	HARRIET E TWITCHELL	ST. OF W.	752-53 10-28-40
9	A.	W.D.	10-12-40	ADVENT CHRISTIAN CHURCH	ST. OF W.	746-46 10-16-40
10	A.	W.D.	10-10-40	KARL T SPOFFORD	ST. OF W.	756-36 10-28-40
11	A.	W.D.	10-12-40	T.J. MALLORY	TOWN OF WOODFORD	760-61 11-2-40
12	A.	W.D.	10-12-40	WILLIAM D BISHOP	TOWN OF WOODFORD	759 11-2-40
13	A.	W.D.	10-12-40	ADVENT CHRISTIAN CHURCH	TOWN OF WOODFORD	761-63 11-2-40

RD. ROAD STATE FED. AID FISCAL SHEET TOTAL
 DIST. NO. STATE DIST. NO. SHEET NO. SHEETS
 9 1 1 2 8 1939 7 57
 WOODFORD

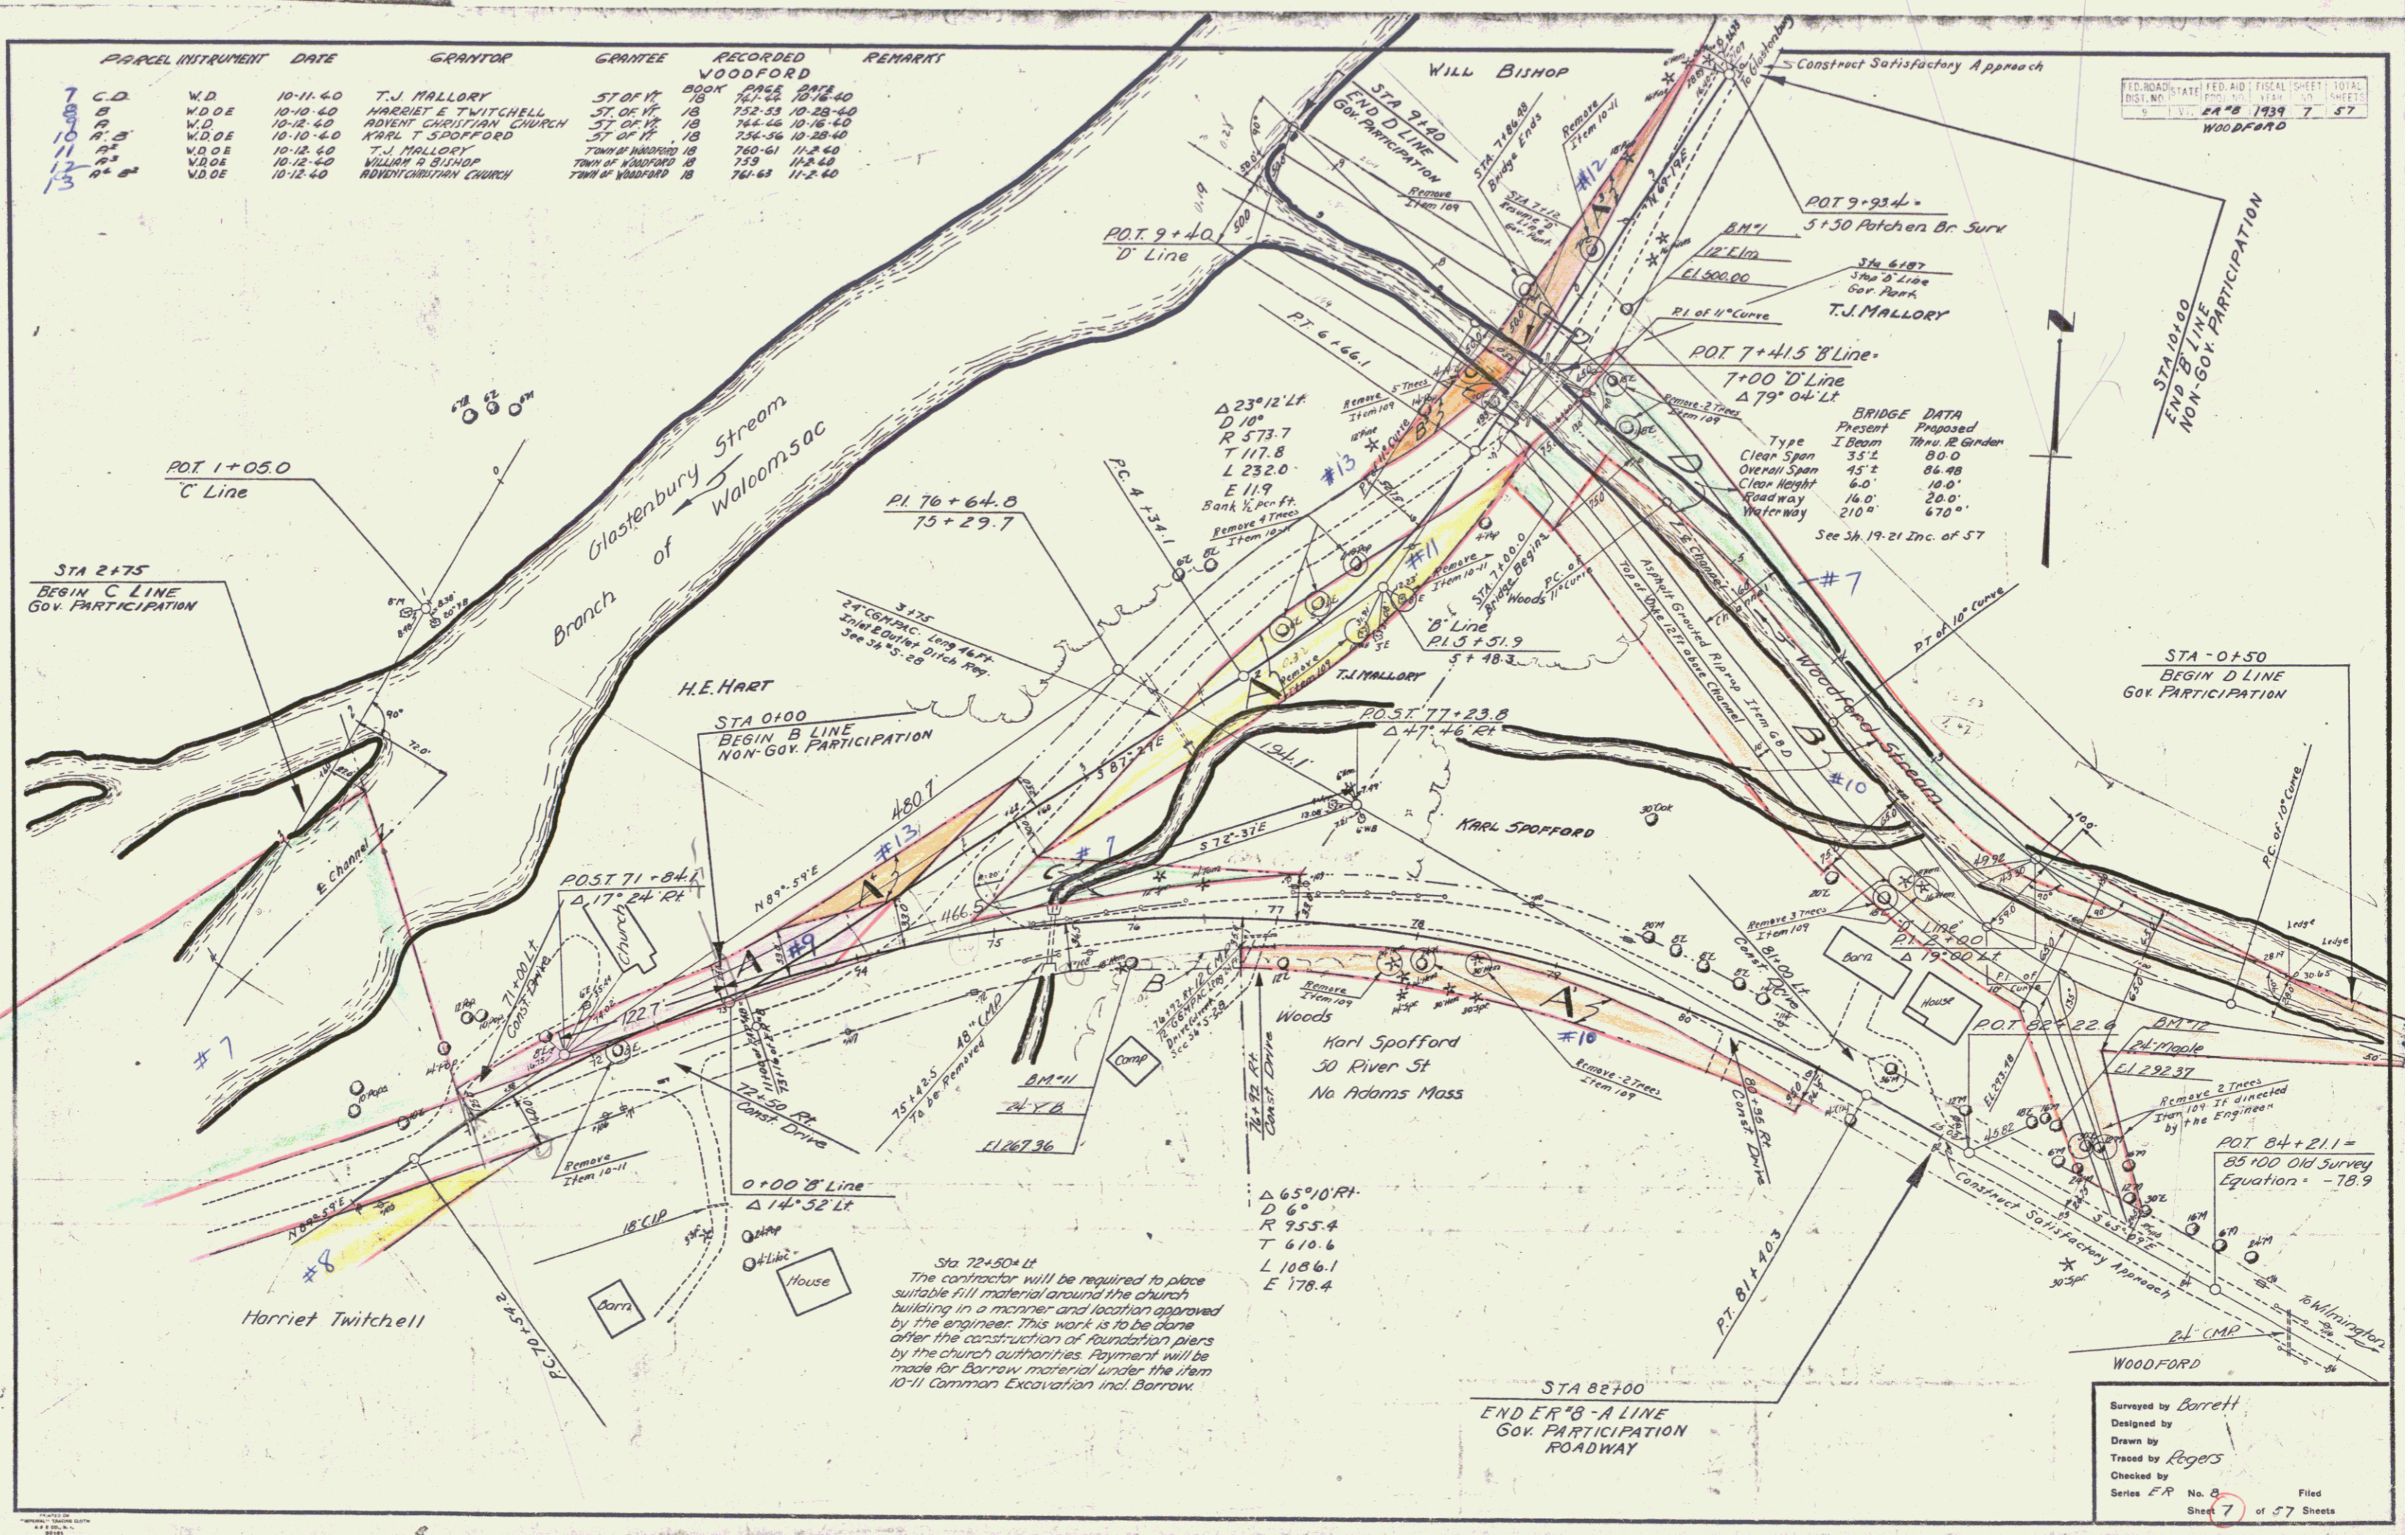

Surveyed by Barrett
 Designed by
 Drawn by
 Traced by Rogers
 Checked by
 Series E.P. No. 5 Filed
 Sheet 7 of 57 Sheets