NEW REINF. CONC. PIPE REQUIRED					
Sta.	Dia.	Leng.	Conc. Class A	Steel	C.R.M.
269+70	18"	48 Ft.	1.5 cu.yds.	73 lbs	
281+30	18"	48 "			1.7 cu.yds.
283+50	18"	48 "	1.8	75	

NEW REIN. CONC. BOX CULV. REQUIRED				
Sta.	Size	Conc. Class A.	Steel	
279+24	3'x3'	29.0 cu.yds	2,000 lbs.	

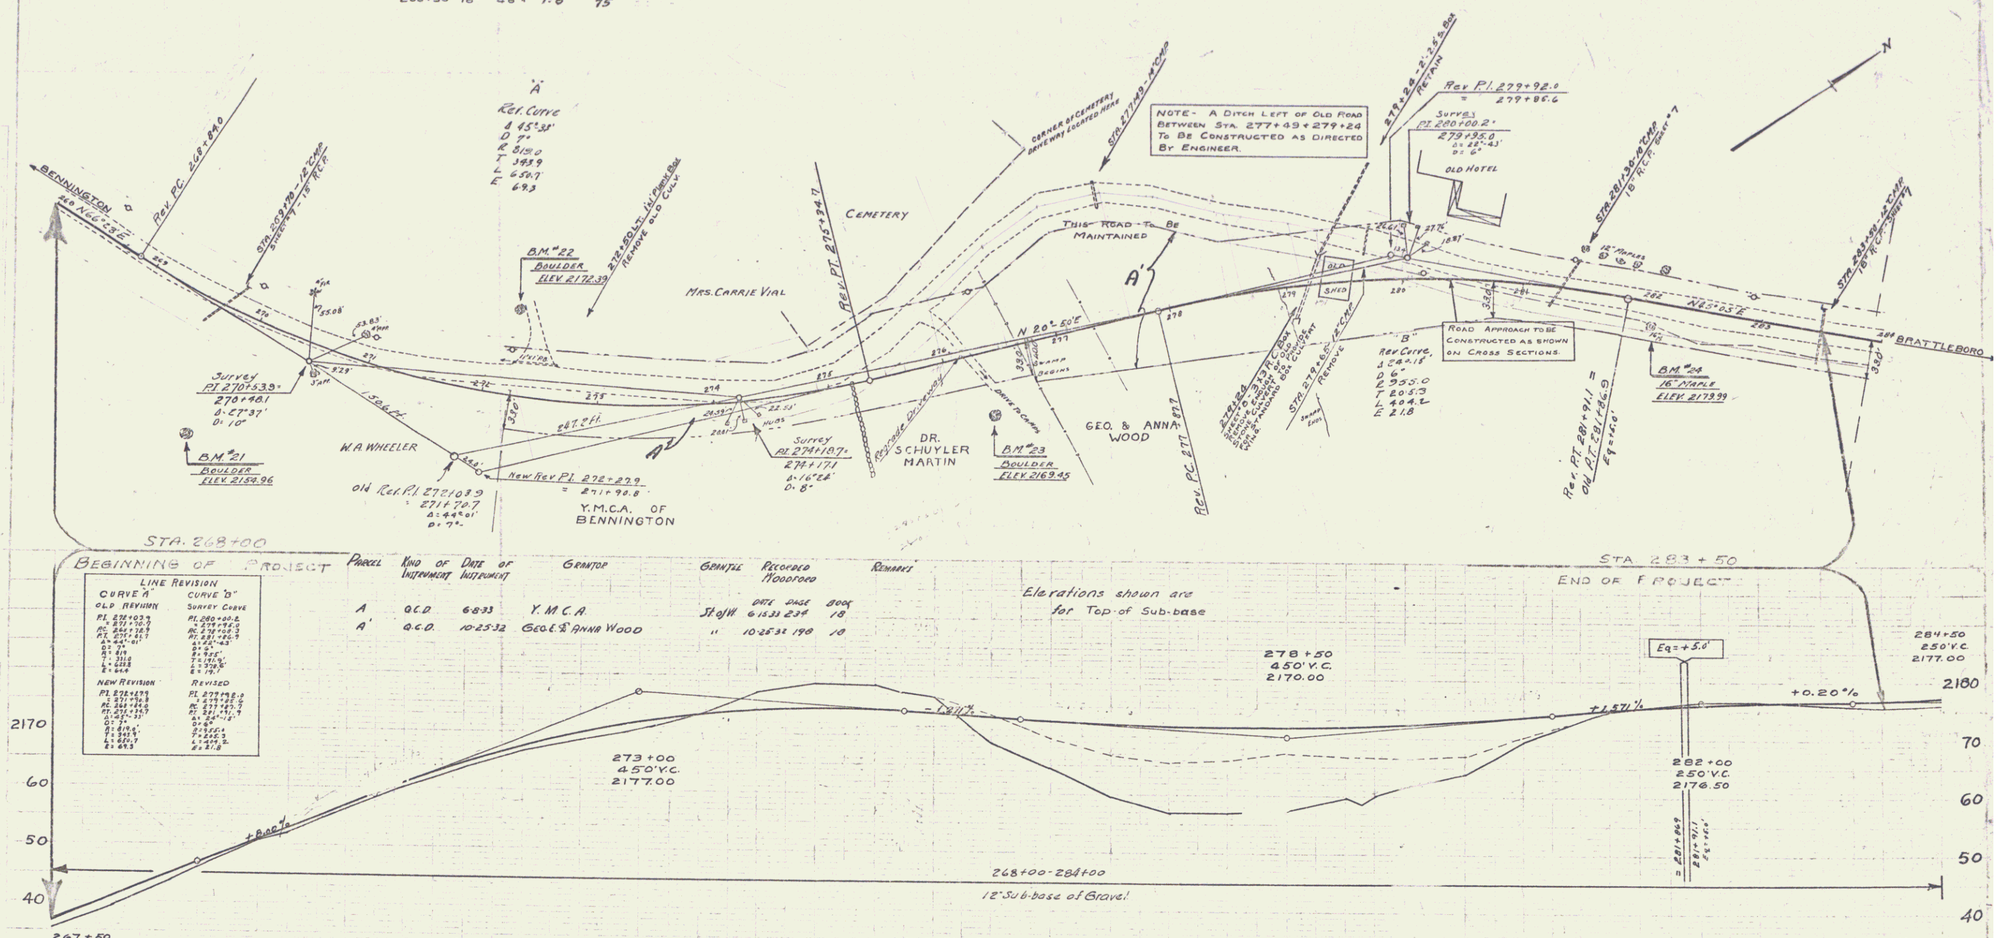

Parcel	Kind of Instrument	Date of Instrument	Grantor	Grantee	Recorded Book	Page	Date	Remarks
A	Q.C.D.	6-8-33	Y.M.C.A.	St. of Vt.	61	533	234	10
A'	Q.C.D.	10-25-32	Geo. & Anna Wood	"	10	25	32	190 10

Elevations shown are for Top of Sub-base

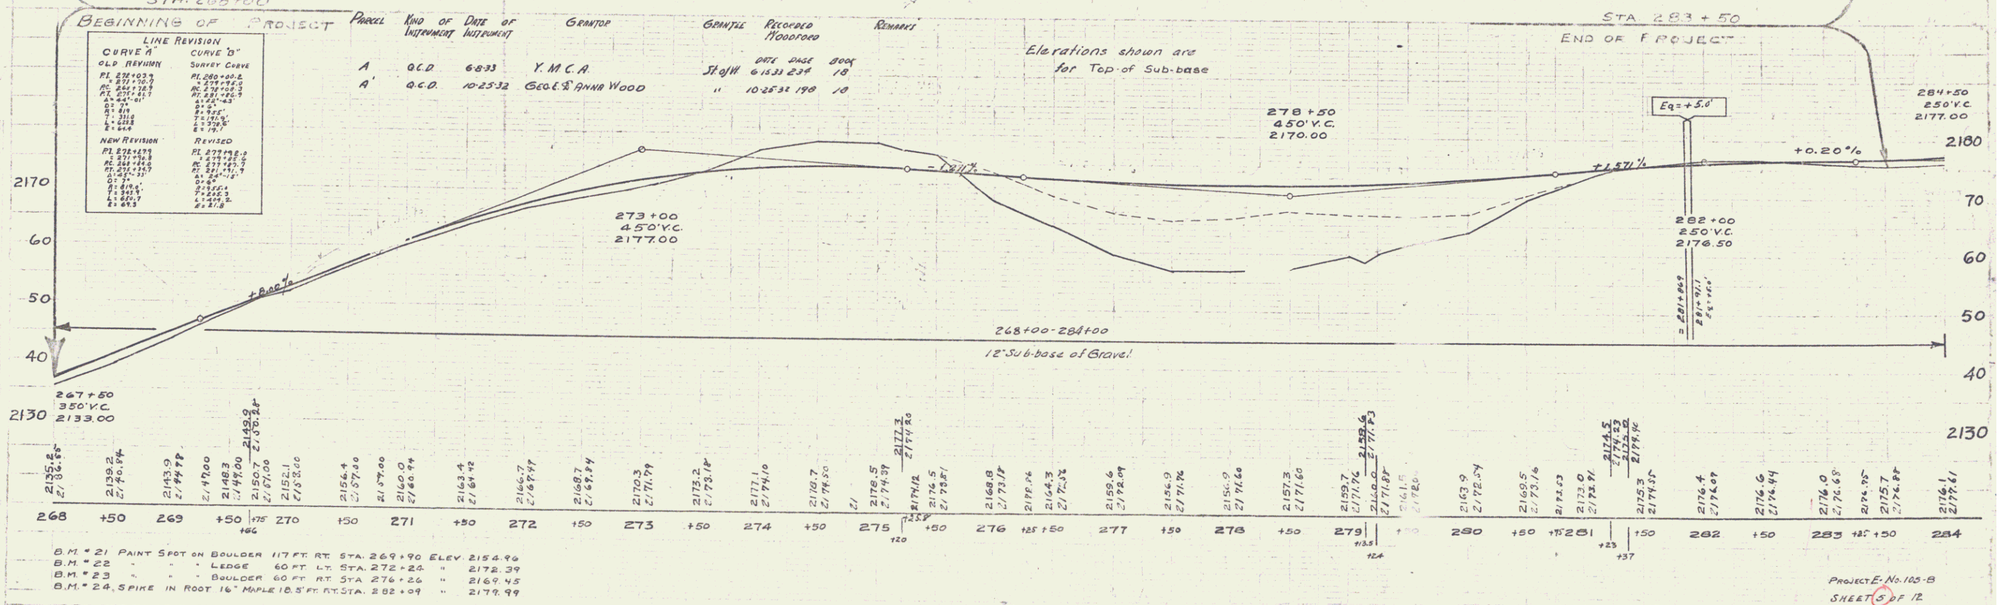

B.M. #21 PAINT SPOT ON BOULDER 117 FT. RT. STA. 269+90 ELEV. 2154.96
B.M. #22 " " LEDGE 60 FT. LT. STA. 272+24 " 2172.39
B.M. #23 " " BOULDER 60 FT. RT. STA. 276+26 " 2169.45
B.M. #24 SPIKE IN ROOT 16" MAPLE 18.5 FT. RT. STA. 282+09 " 2179.99

PROJECT E-No. 105-B
SHEET 5 OF 12

2