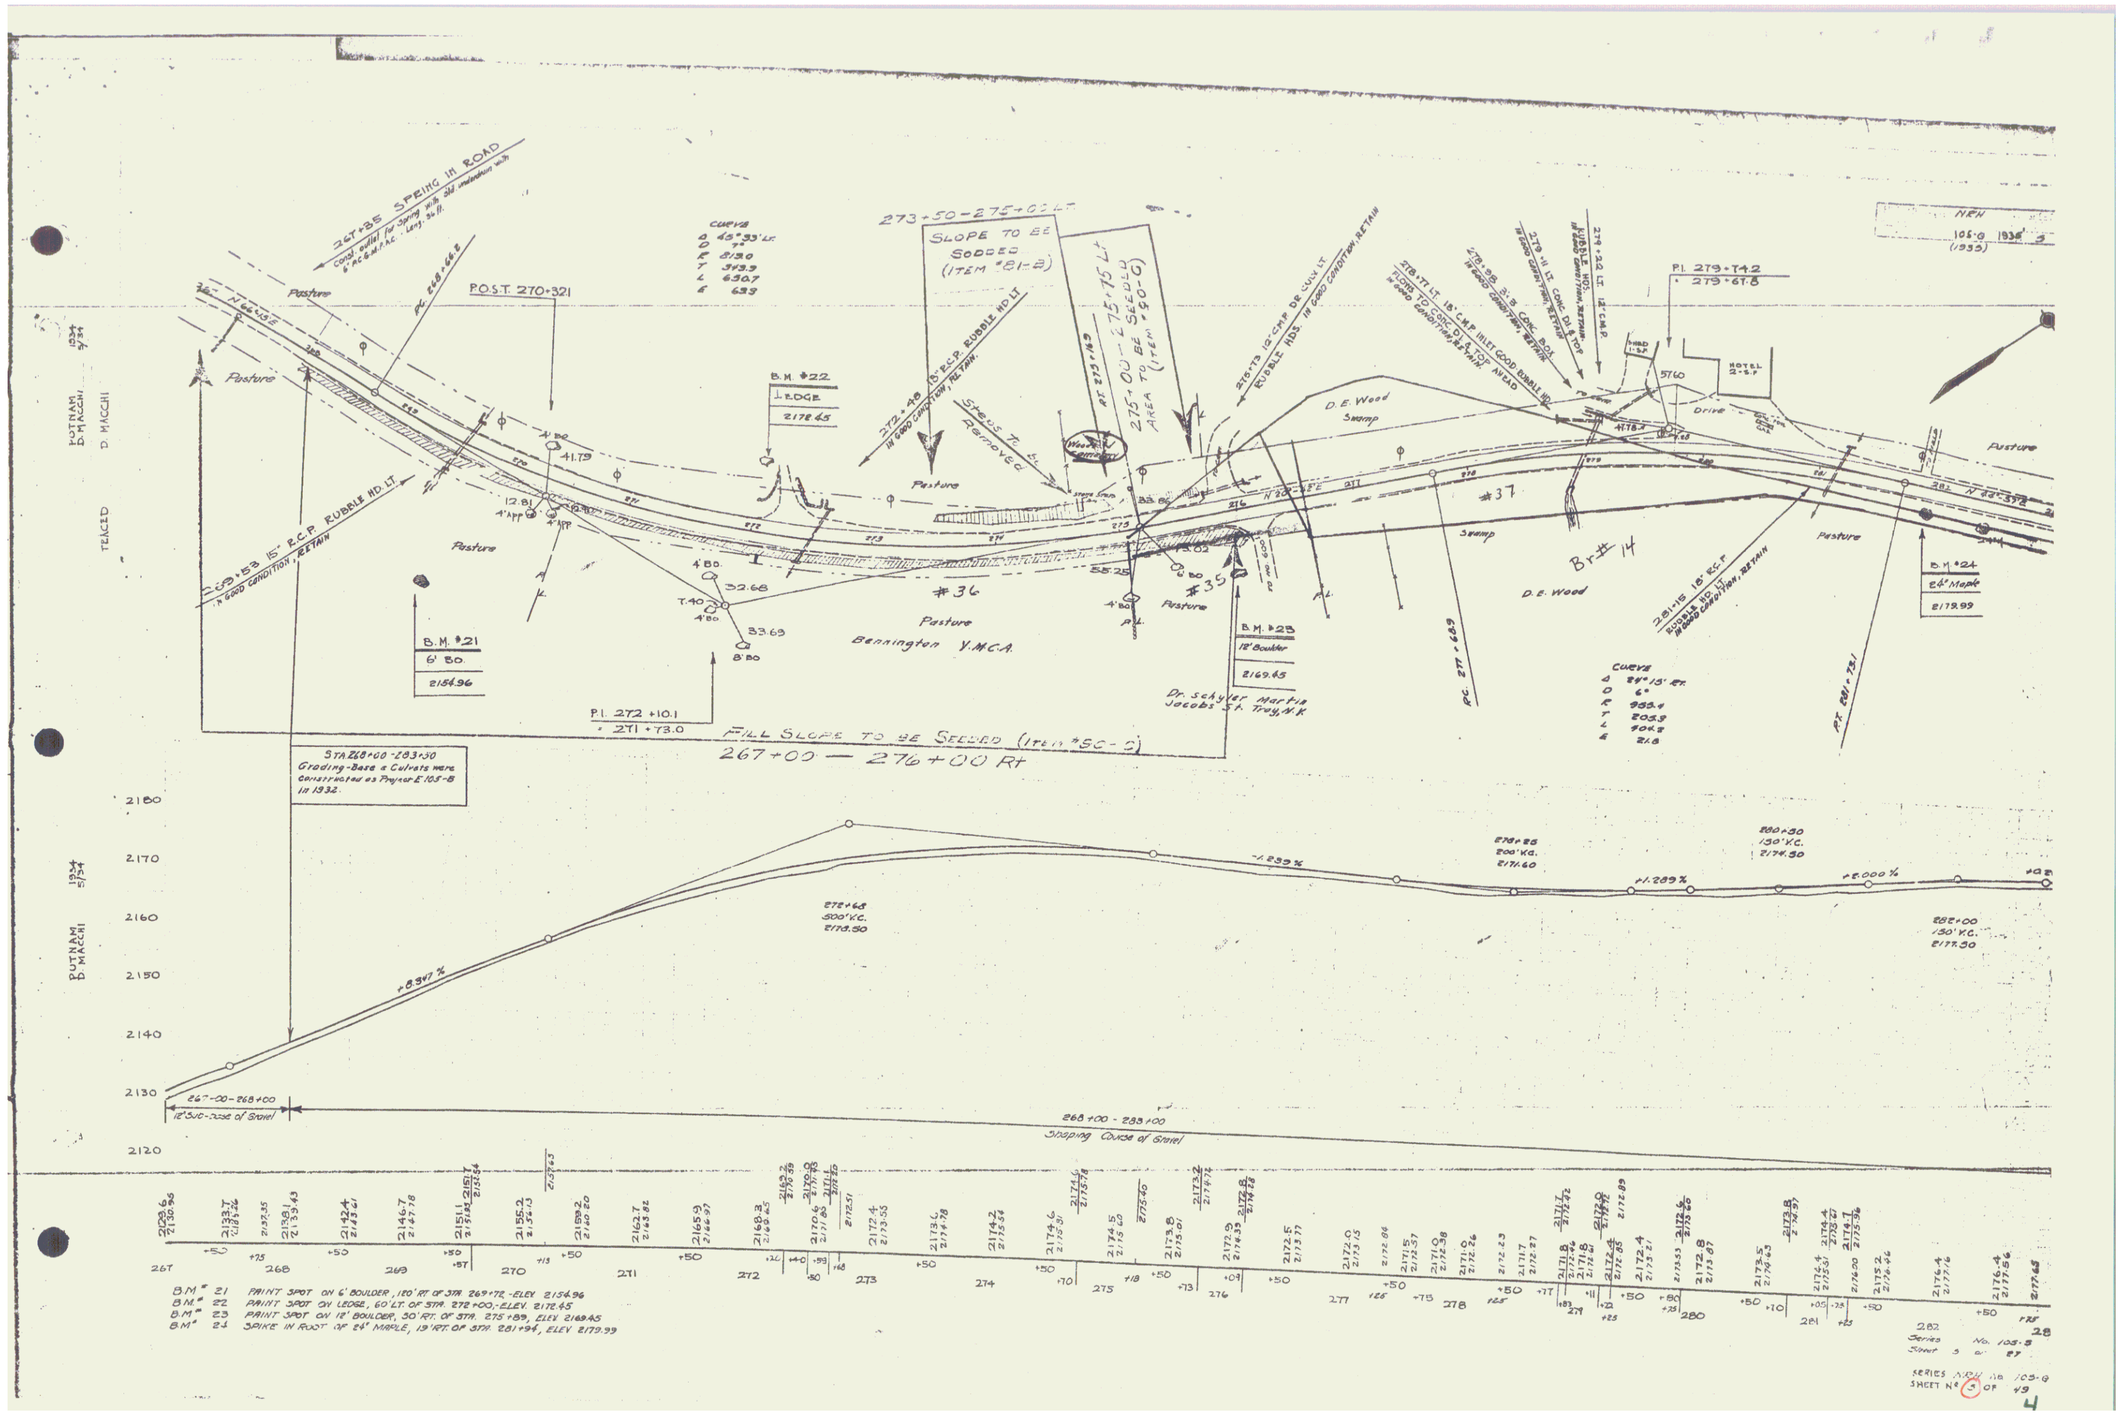
267+85 SPRING IN ROAD
Cond. outlet for spring with old culvert below with 6" RCMP Lat. Leg. to it.
P.O.S.T. 270+321
PC. 268+66.5
Pasture
Swamp
D.E. Wood
Br# 14
#36
#37
#35
Bennington Y.M.C.A.
Pr. Schuyler Martin Jacobs Sr. Troy, N.Y.
Hotel 2-S.P.
Drive
P.I. 273+74.2
+ 273+67.8
P.I. 272+10.1
+ 271+73.0
B.M. #21
6' Bo.
2154.96
B.M. #22
⊥ Edge
2178.45
B.M. #23
18" Boulder
2169.45
B.M. #24
24" Maple
2179.99
273+50 - 275+00 LT
SLOPE TO BE SODDED (ITEM #81-2)
275+00 - 275+75 LT
AREA TO BE SEEDED (ITEM #90-0)
FILL SLOPE TO BE SEEDED (ITEM #50-0)
267+00 — 276+00 Rt
STA. 268+00 - 283+30
Grading - Base & Culverts were Constructed as Project E.105-B in 1932.
267+00 - 268+00
12" Sub-base of Gravel
268+00 - 283+00
Stoping Course of Gravel
+8.947 %
-1.239 %
+1.289 %
+5.000 %
272+68
500' V.C.
2173.50
278+25
200' V.C.
2177.60
280+30
130' V.C.
2174.50
282+00
130' V.C.
2177.50
BM # 21 PAINT SPOT ON 6' BOULDER, 120' RT. OF STA. 269+72 - ELEV. 2154.96
BM # 22 PAINT SPOT ON LEDGE, 60' LT. OF STA. 272+00; - ELEV. 2172.45
BM # 23 PAINT SPOT ON 18" BOULDER, 30' RT. OF STA. 275+89, ELEV. 2169.45
BM # 24 SPIKE IN ROOT OF 24" MAPLE, 19' RT. OF STA. 281+96, ELEV. 2179.99
SERIES NO. 105-B
SHEET No. 4 OF 49