BRIDGE MAINTENANCE

TOWN OF ANDOVER
COUNTY OF WINDSOR
VT. RTE. 11 BR. NO. 37
OVER WILLIAMS RIVER

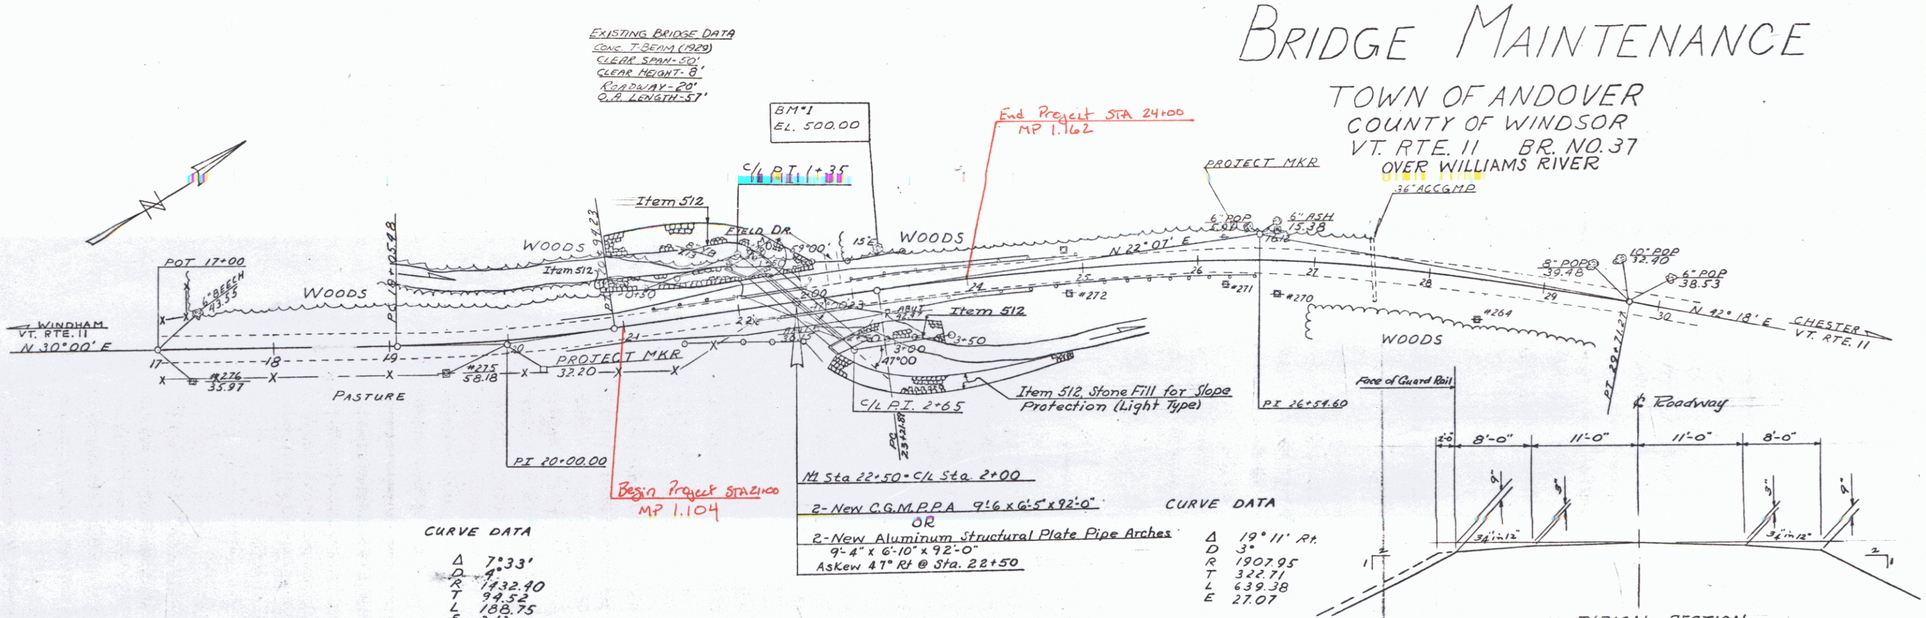

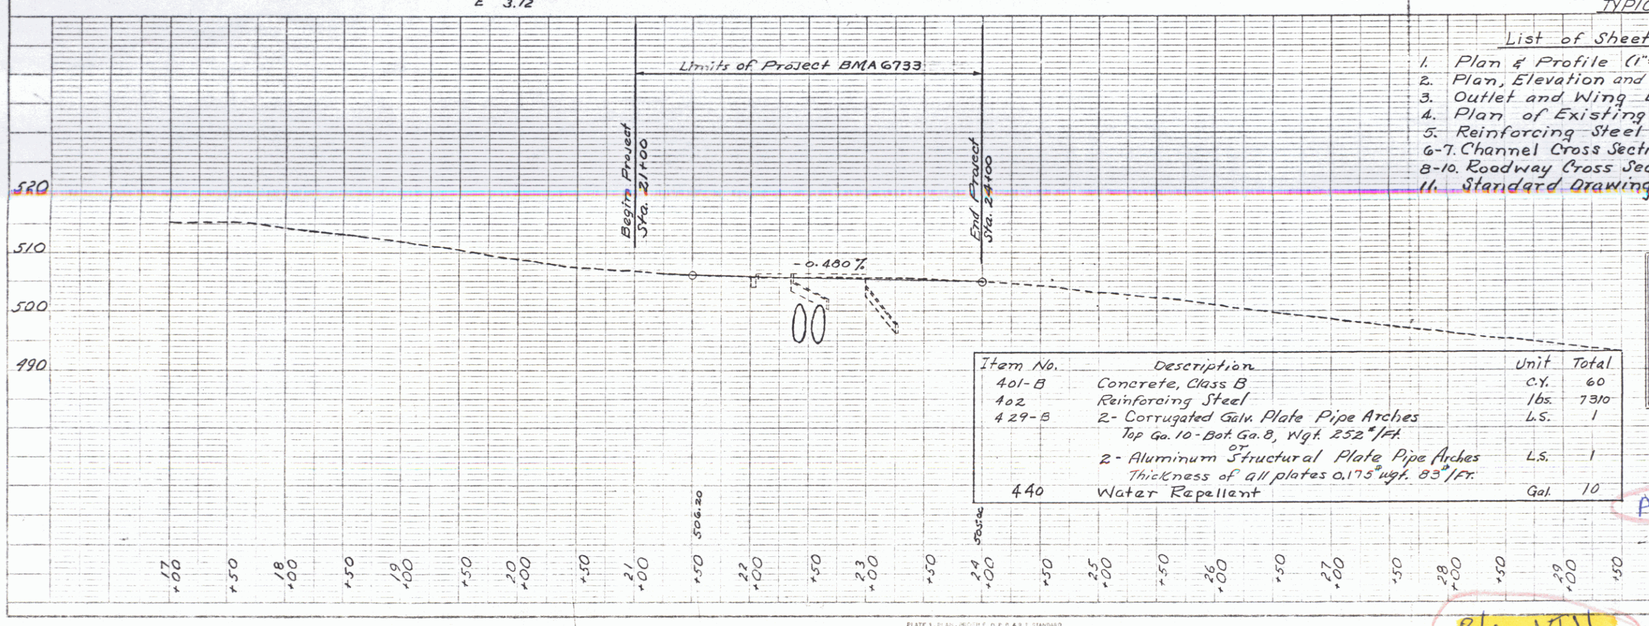

List of Sheets

1. Plan & Profile (1" = 50')
2. Plan, Elevation and Inlet Details
3. Outlet and Wing Details
4. Plan of Existing Structure
5. Reinforcing Steel Schedule
6-7. Channel Cross Sections (0+50 - 3+50)
8-10. Roadway Cross Sections (18+00 - 25+50)
11. Standard Drawing SCB-D6-67, Detail B 1-24-68

Item No.	Description	Unit	Total
401-B	Concrete, Class B	C.Y.	60
402	Reinforcing Steel	lbs.	7310
429-B	2- Corrugated Galv. Plate Pipe Arches Top Ga. 10 - Bot. Ga. 8, Wgt. 252#/Ft.	L.S.	1
	or 2- Aluminum Structural Plate Pipe Arches Thickness of all plates 0.175" wgt. 83#/Ft.	L.S.	1
440	Water Repellant	Gal.	10

RECOMMENDED FOR APPROVAL	R.O. Mann, DISTRICT ENGINEER	10-3-68 DATE
RECOMMENDED FOR APPROVAL	Lyle Lyon, BRIDGE ENGINEER	8/7/68 DATE
RECOMMENDED FOR APPROVAL	ASSISTANT CHIEF ENGINEER	DATE
APPROVED BY	CHIEF ENGINEER	DATE

1/1/70

ANDOVER

PIN# 99R823

Rte. VT11

SHEET 1 OF 11

PLATE 1 PLAN, PROFILE, O.P.R. & N.T. STANDARD
NEWTON & HUSER CO., NEW YORK

PLAN — FAIRFORD — 6-68

PROFILE — FAIRFORD — 6-68