FED. ROAD DIST. NO.	STATE	FED. NO. PROJ. NO.	FISCAL YEAR	SHEET NO.	TOTAL SHEETS
3	VT	105-D	1931	7	47

Wood Guard Rail Required

Curb Sta.	Left	Right
512+77	28'	28'

New Cast Iron Pipe Culverts Required

Sta.	Diam.	Leng.	Concr.	Steel
512+90	30	36'	41	186'

New C.G.M. Driveway Pipes Required

Sta.	Diam.	Leng.	Conc. Kind.	Mat.
513+00 Rt.	15	28'	F.S.C.T.	

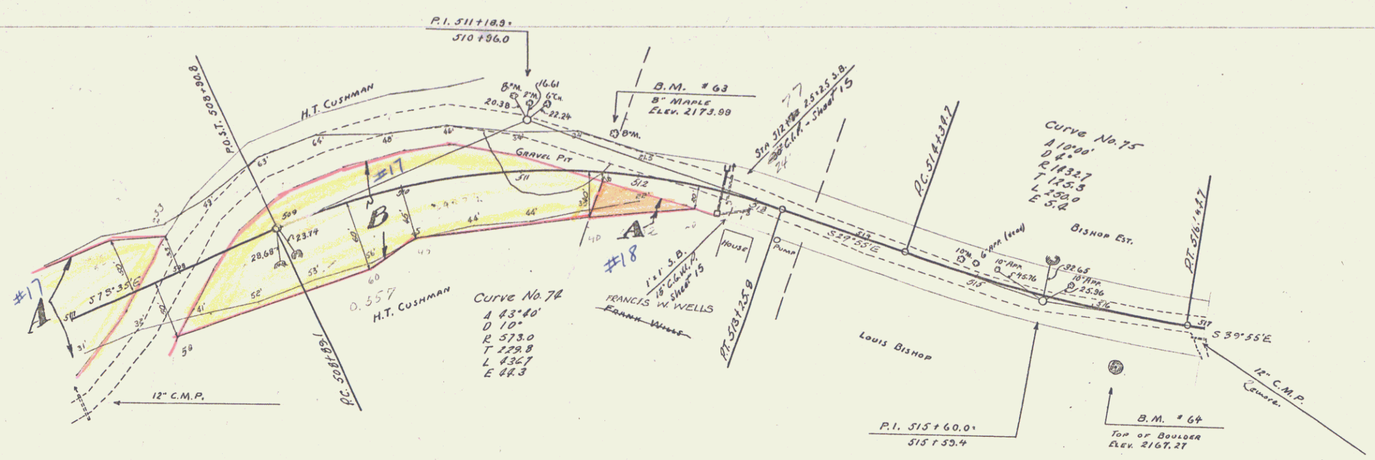

Parcel	Instrument	Date	Grantor	Grantee	Recorded Woodford Book	Page	Date	Remarks
A-B	Q.C.D.	8-29-31	H.T. Cushman Mfg. Co. Inc.	St. of Vt.	18	145-6	1-9-32	
A'	Q.C.D.	8-24-31	Francis W. Wells	"	18	142	1-9-32	

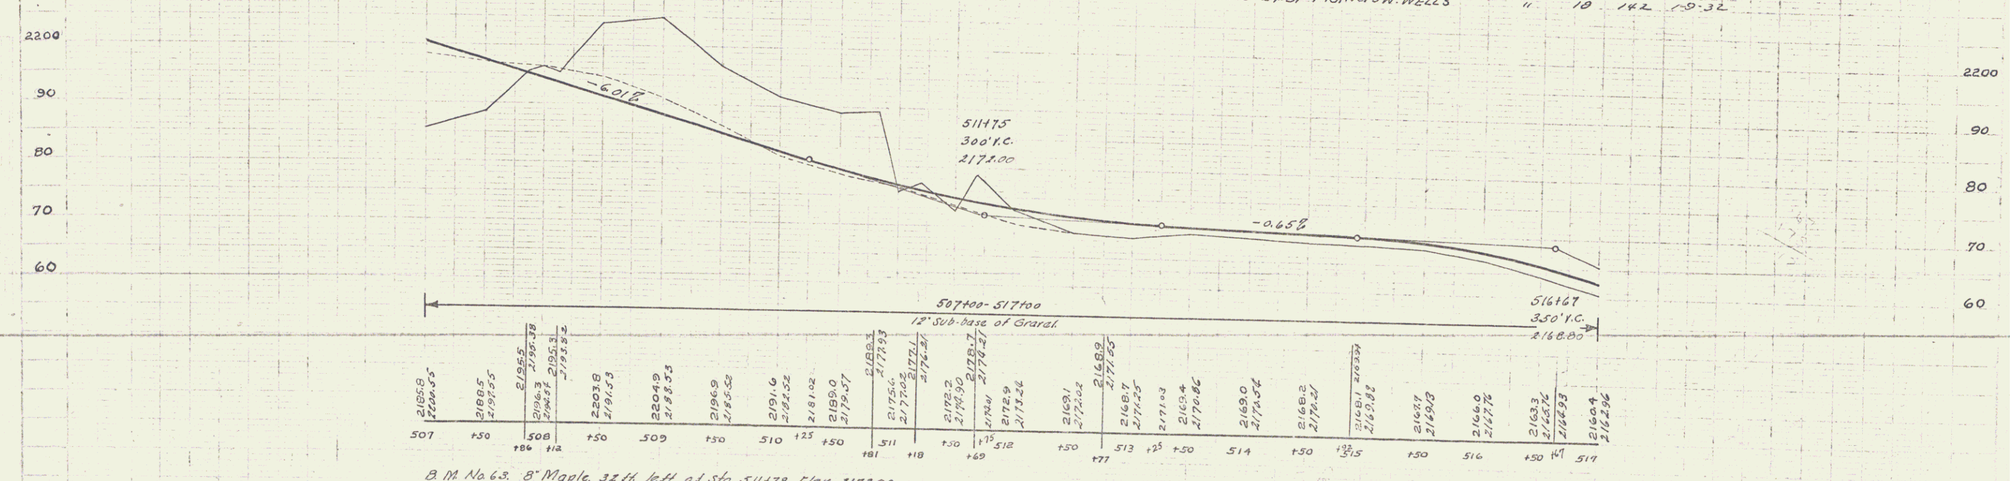

B.M. No. 63. 8" Maple, 32 ft. left of Sta. 511+78. Elev. 2173.99
B.M. No. 64. Top of boulder. 47 ft. right of Sta. 516+31. Elev. 2167.27

Series F-No. 105-D
Sheet 7 of 47

5