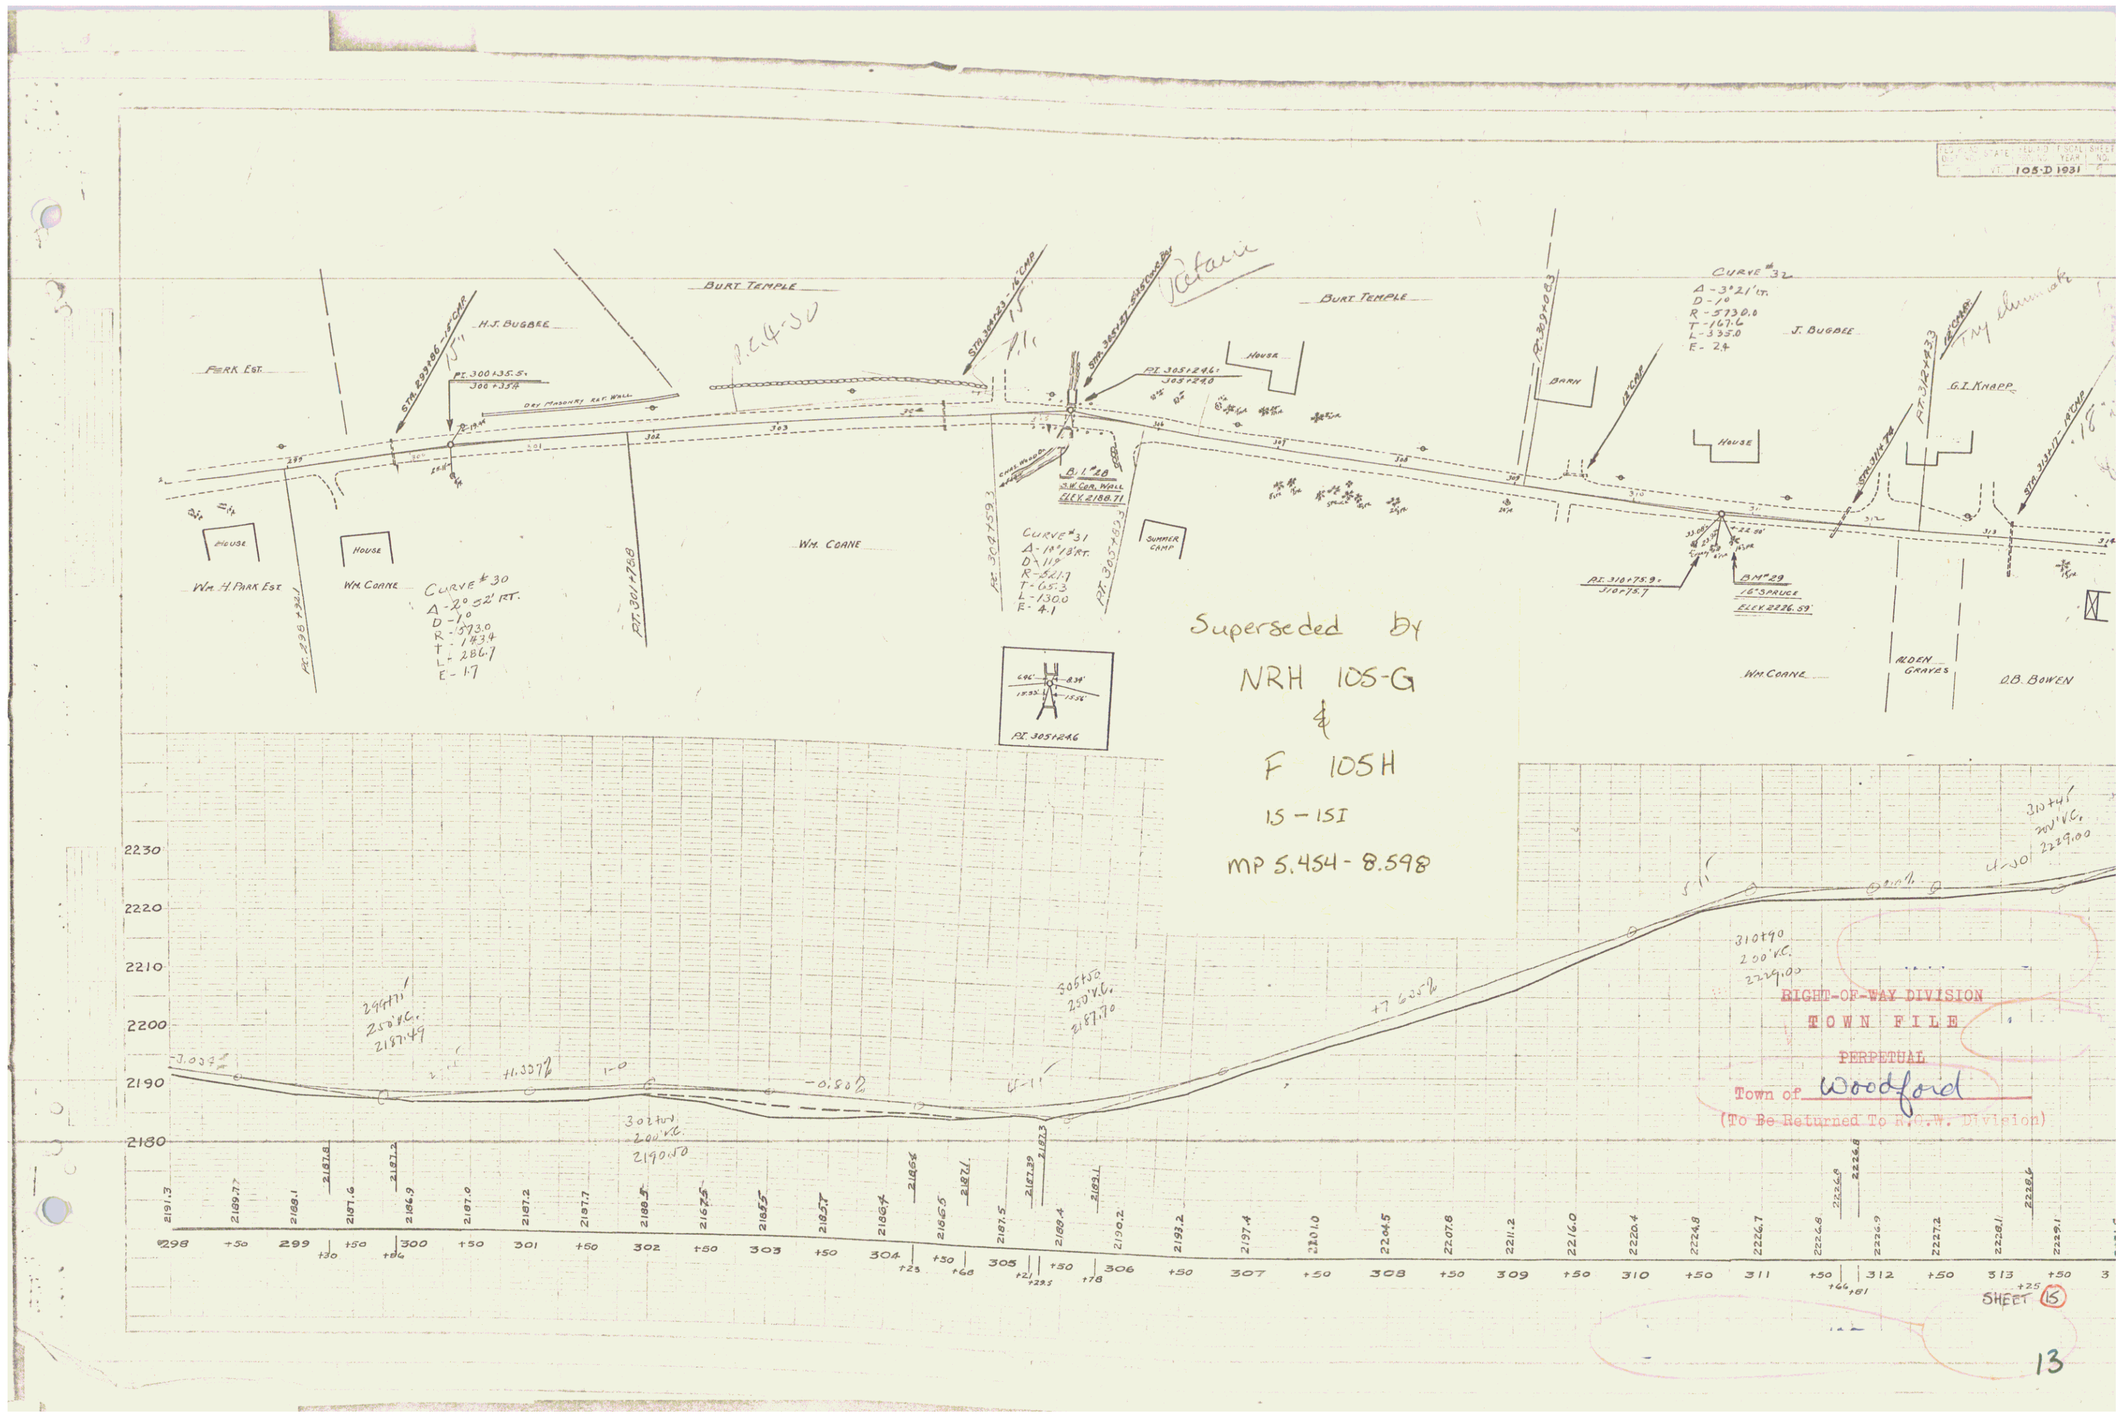
105-D 1931
PARK EST.
H.J. BUGBEE
BURT TEMPLE
BURT TEMPLE
HOUSE
BARN
J. BUGBEE
G.I. KNAPP
WM. H. PARK EST.
WM. COANE
WM. COANE
WM. COANE
ALDEN GRAVES
D.B. BOWEN
SUMMER CAMP
CURVE #30
CURVE #31
CURVE #32
Superseded by
NRH 105-G
&
F 105H
15 – 15I
MP 5.454 - 8.598
RIGHT-OF-WAY DIVISION
TOWN FILE
PERPETUAL
Town of Woodford
(To Be Returned To R.O.W. Division)
SHEET 15
13