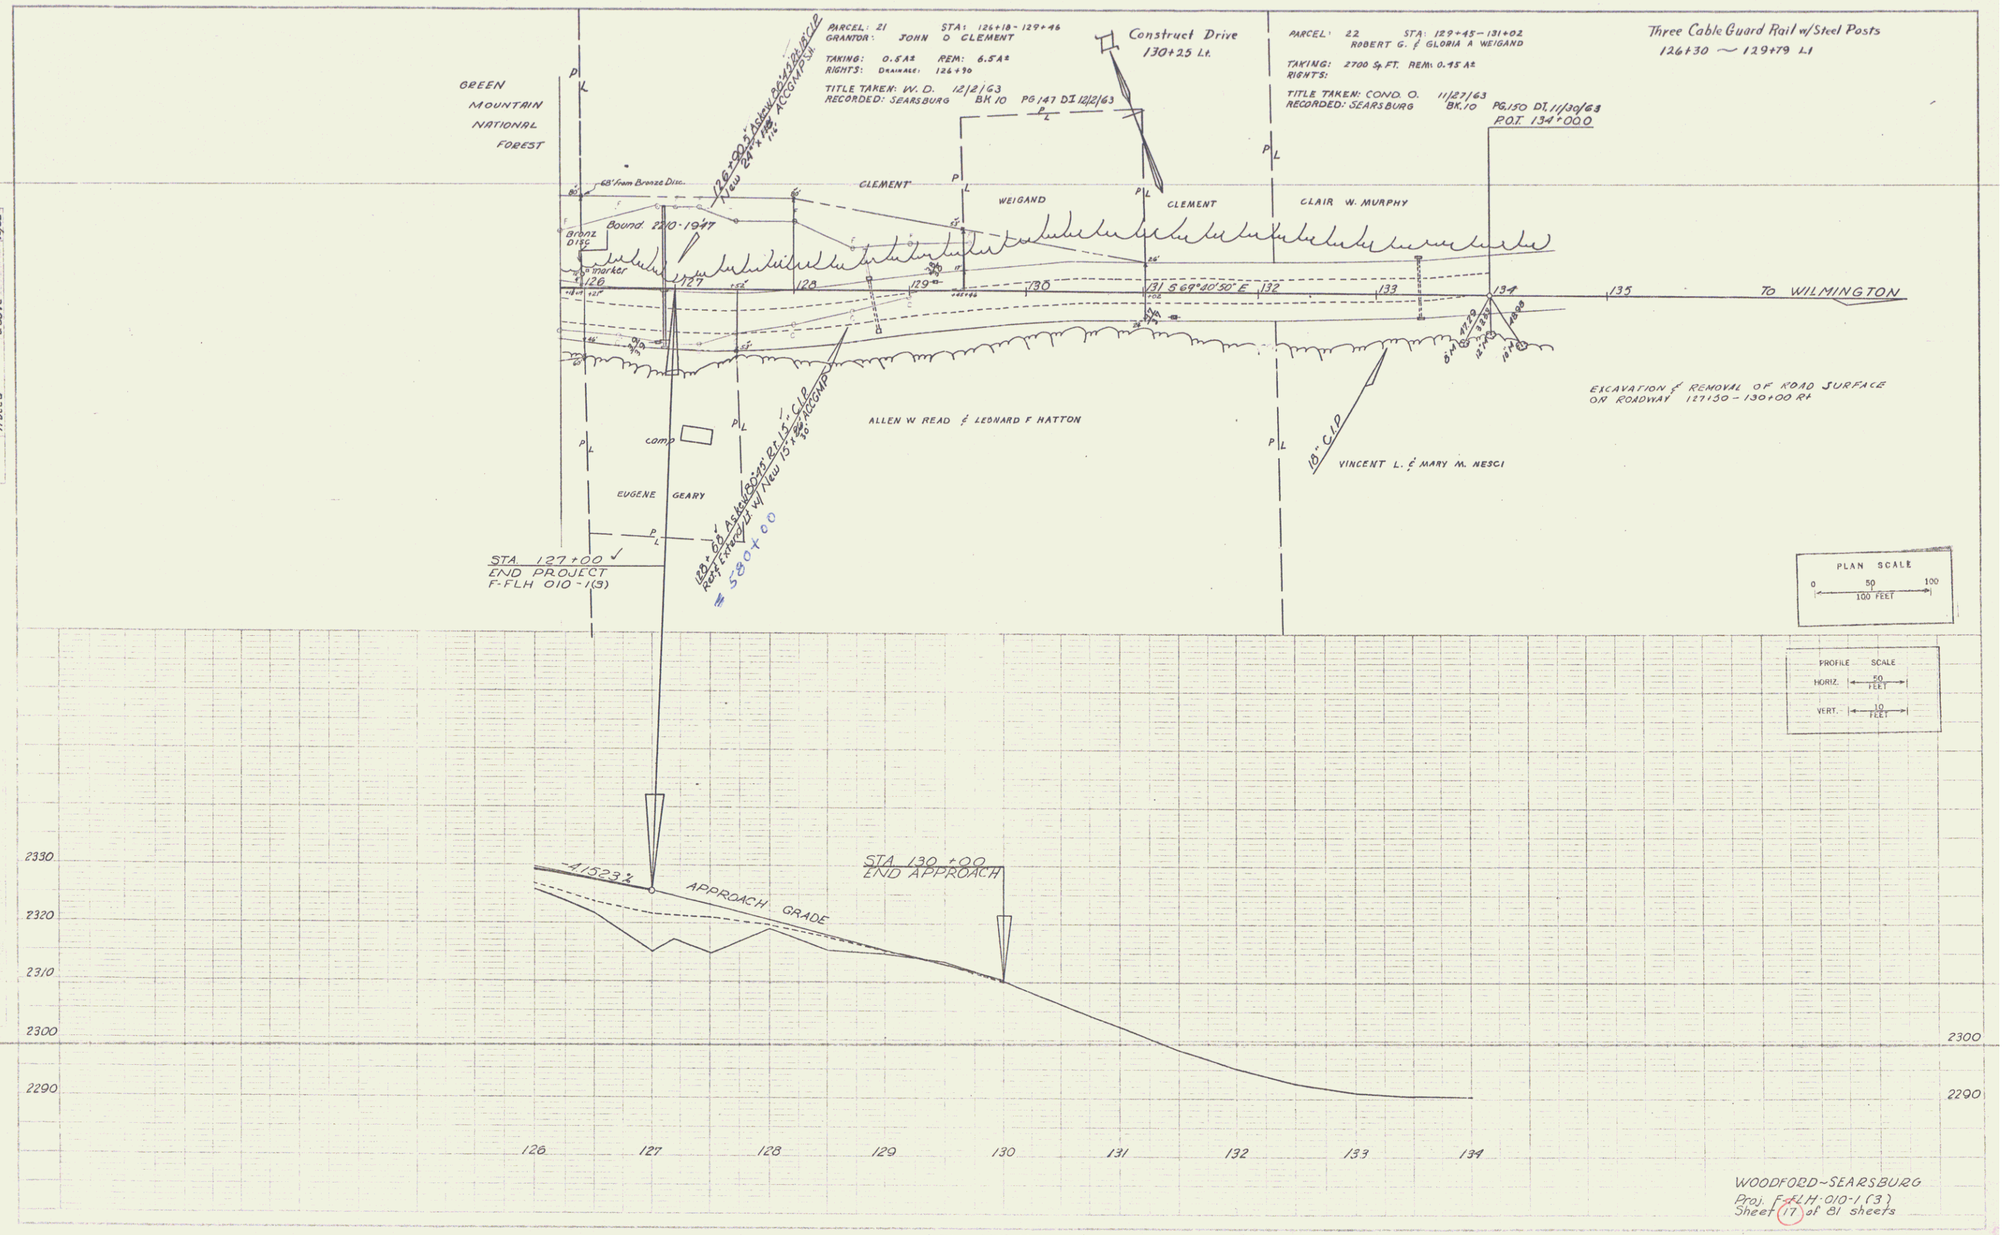

WOODFORD-SEARSBURG
Proj. F-FLH 010-1(3)
Sheet 17 of 81 sheets

10