




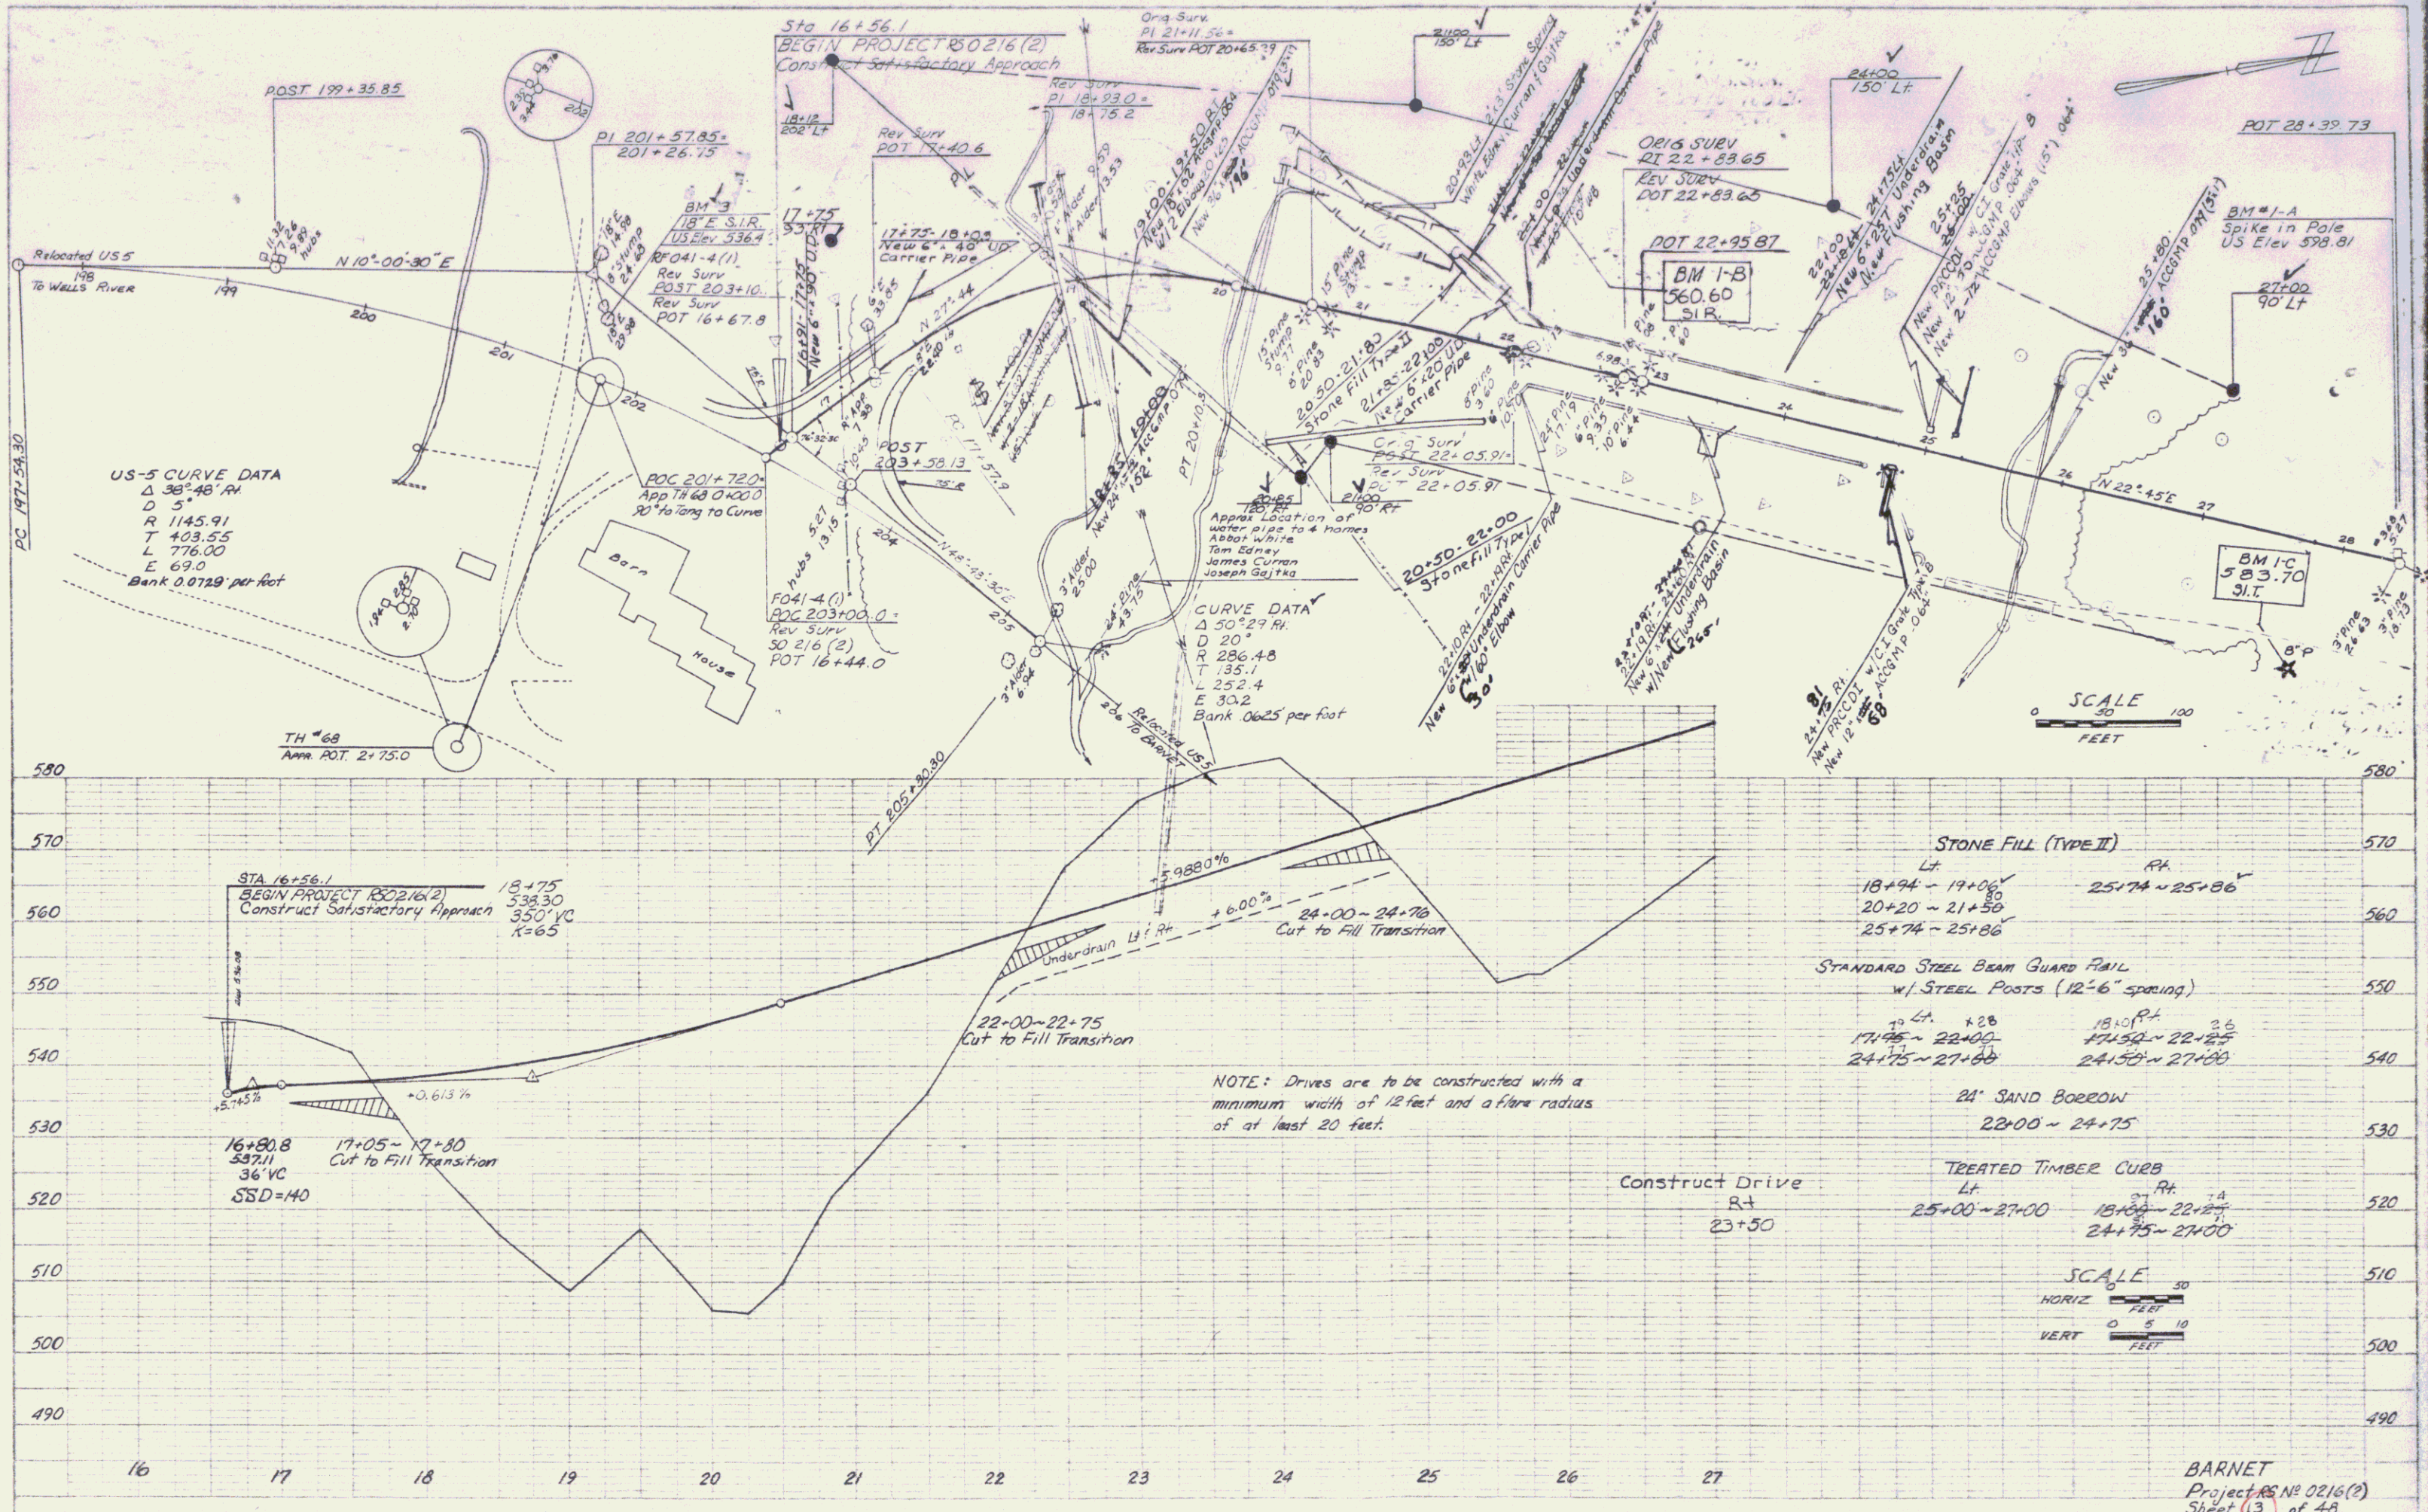

BARNETT
 Project No. 0216(2)
 Sheet 13 of 48