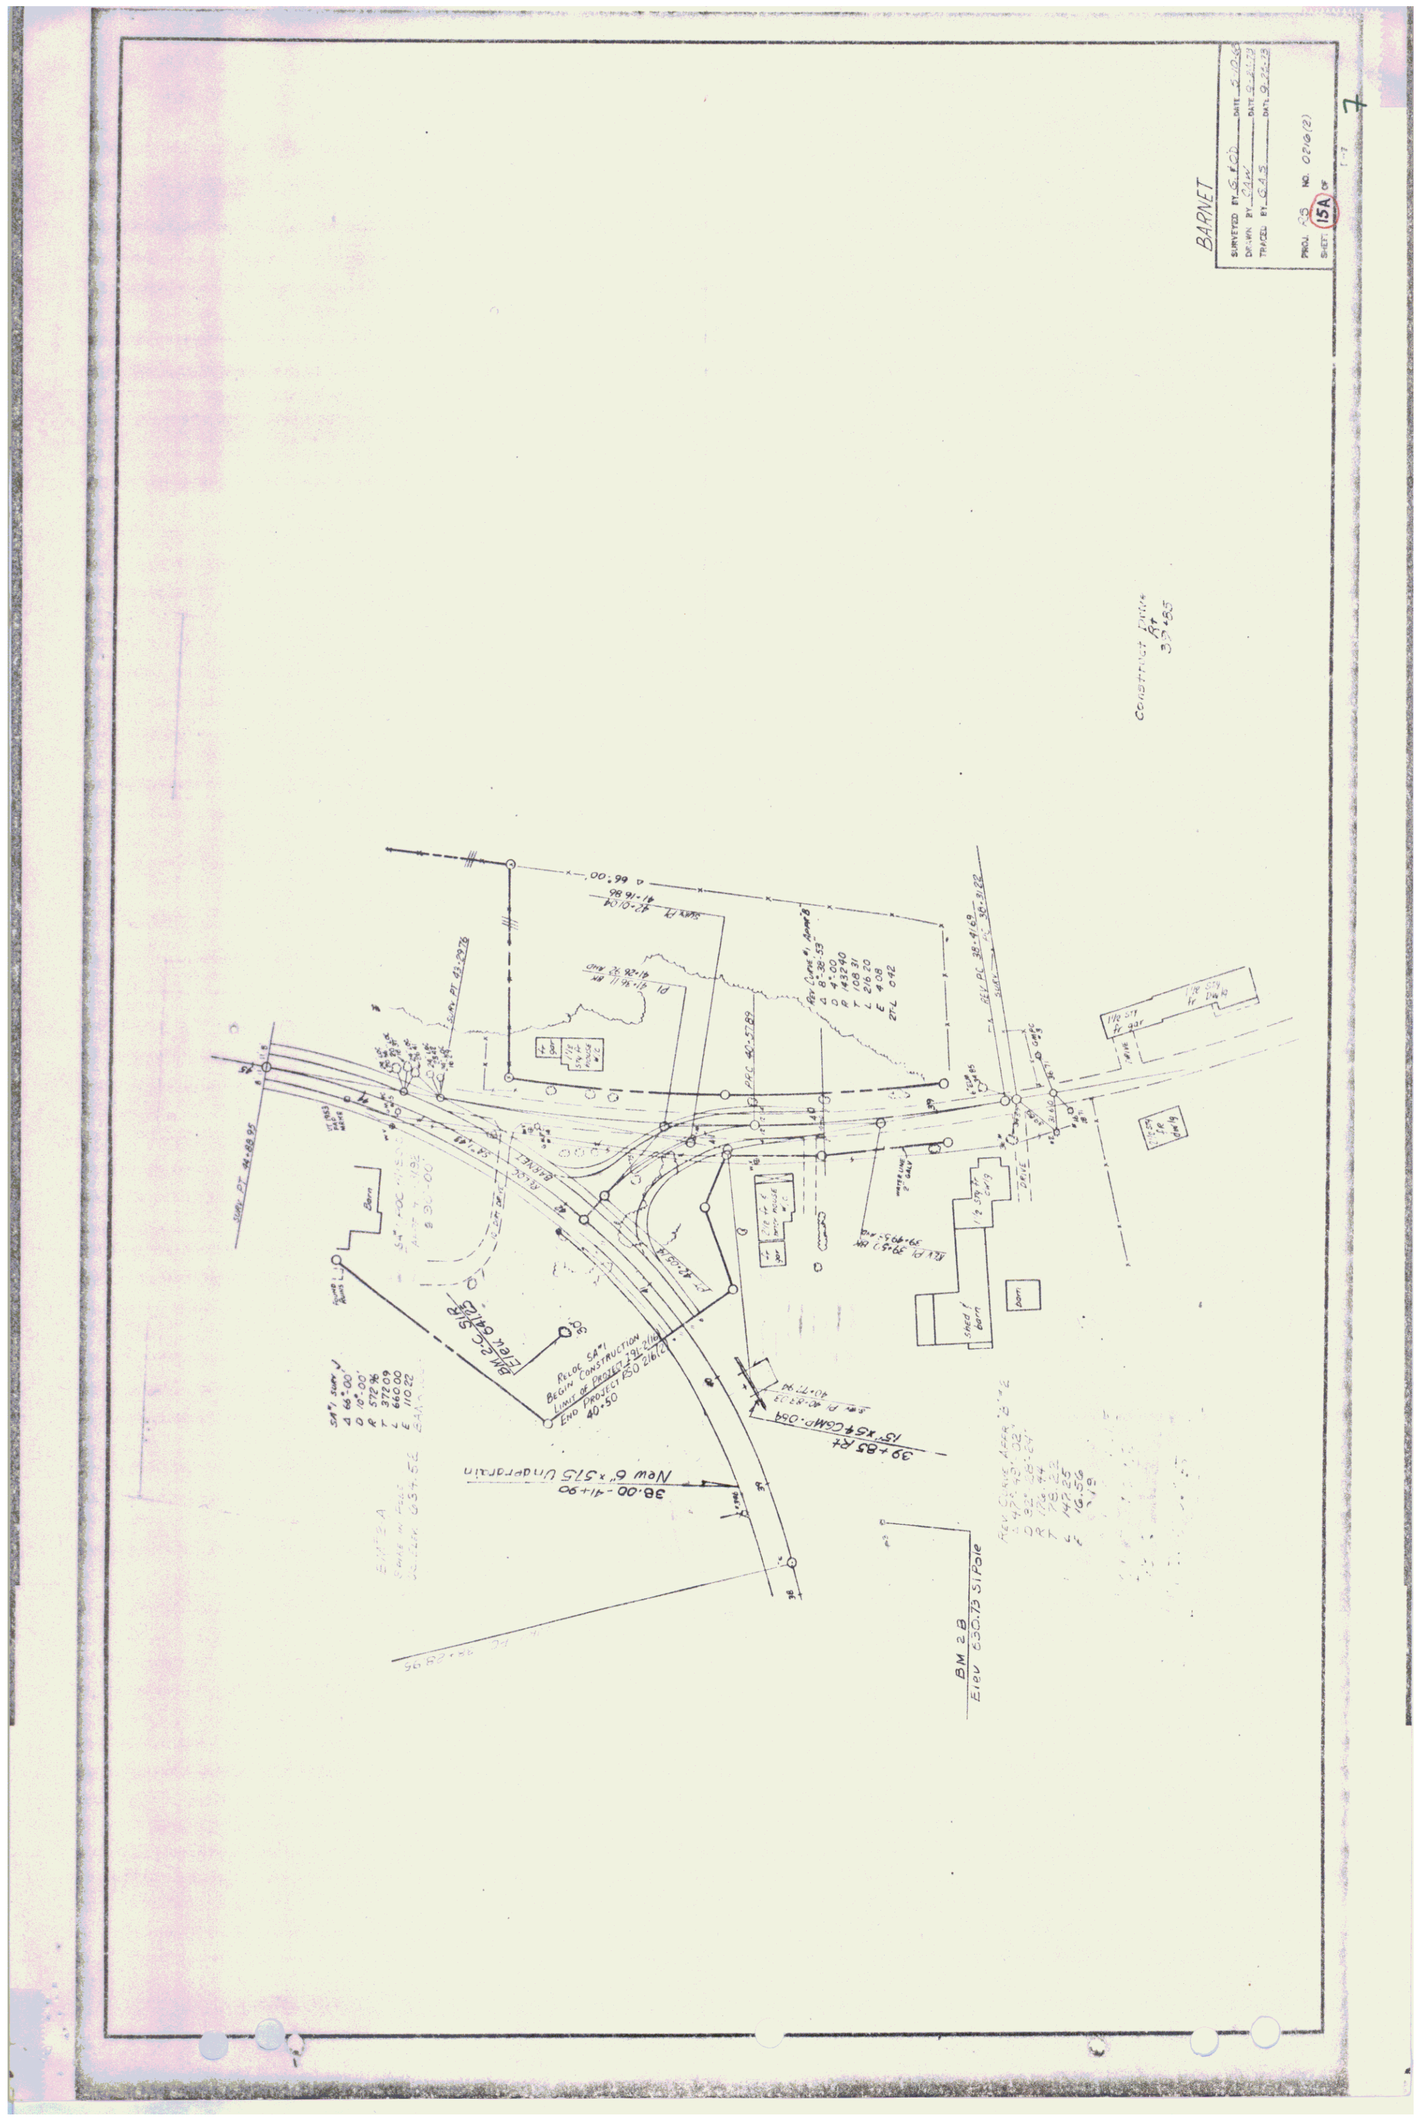
BARNET
SURVEYED BY
DRAWN BY
TRACED BY
PROJ. NO. 0716(2)
SHEET 15A OF
Shed / Barn
Barn
Begin Construction
Limit of Project
End Project
