CHANNEL RELOCATION STA. 821+75 – 828+90
Stream is to be relocated as shown on the layout and crossections. The excavations for this work is to be paid for as channel excavation. (Item 14). The excavated material is to be used in the construction of embankments. Toe of slope is to be protected with boulders and rock from roadway or stream excavation as shown on the cross sections.

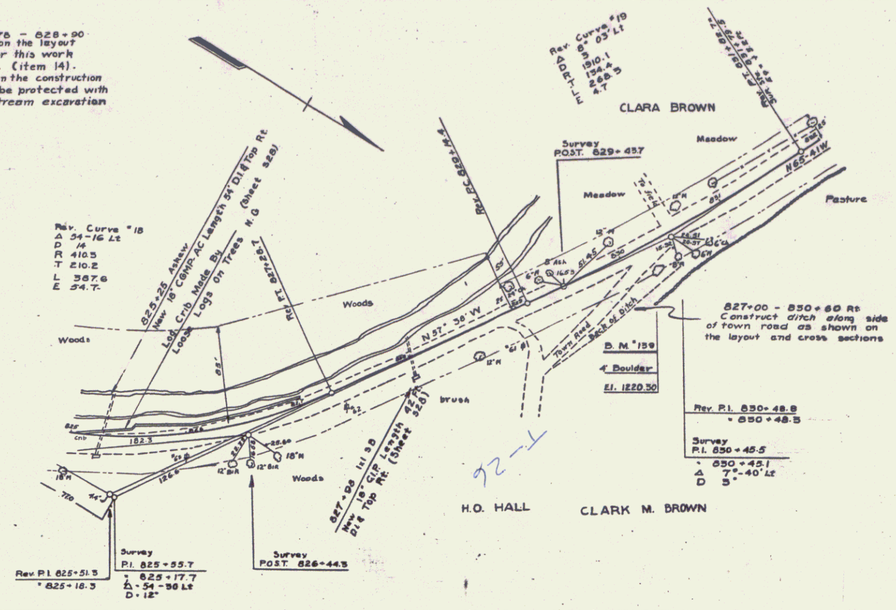

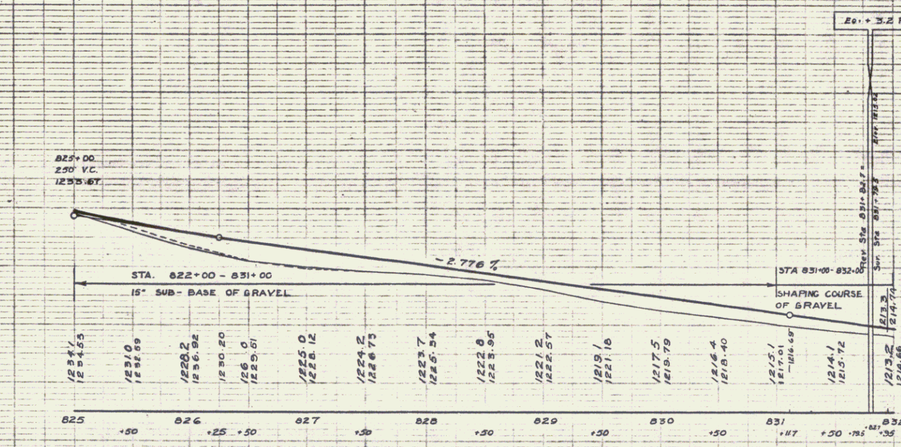

SERIES FA.P. N63 D
SHEET 5A OF 6

5