FEDERAL AID PROJECT	STATE	FISCAL YEAR	SHEET No.	TOTAL SHEETS
9	VT.	NRH 63-G(1935) 1935	4	49

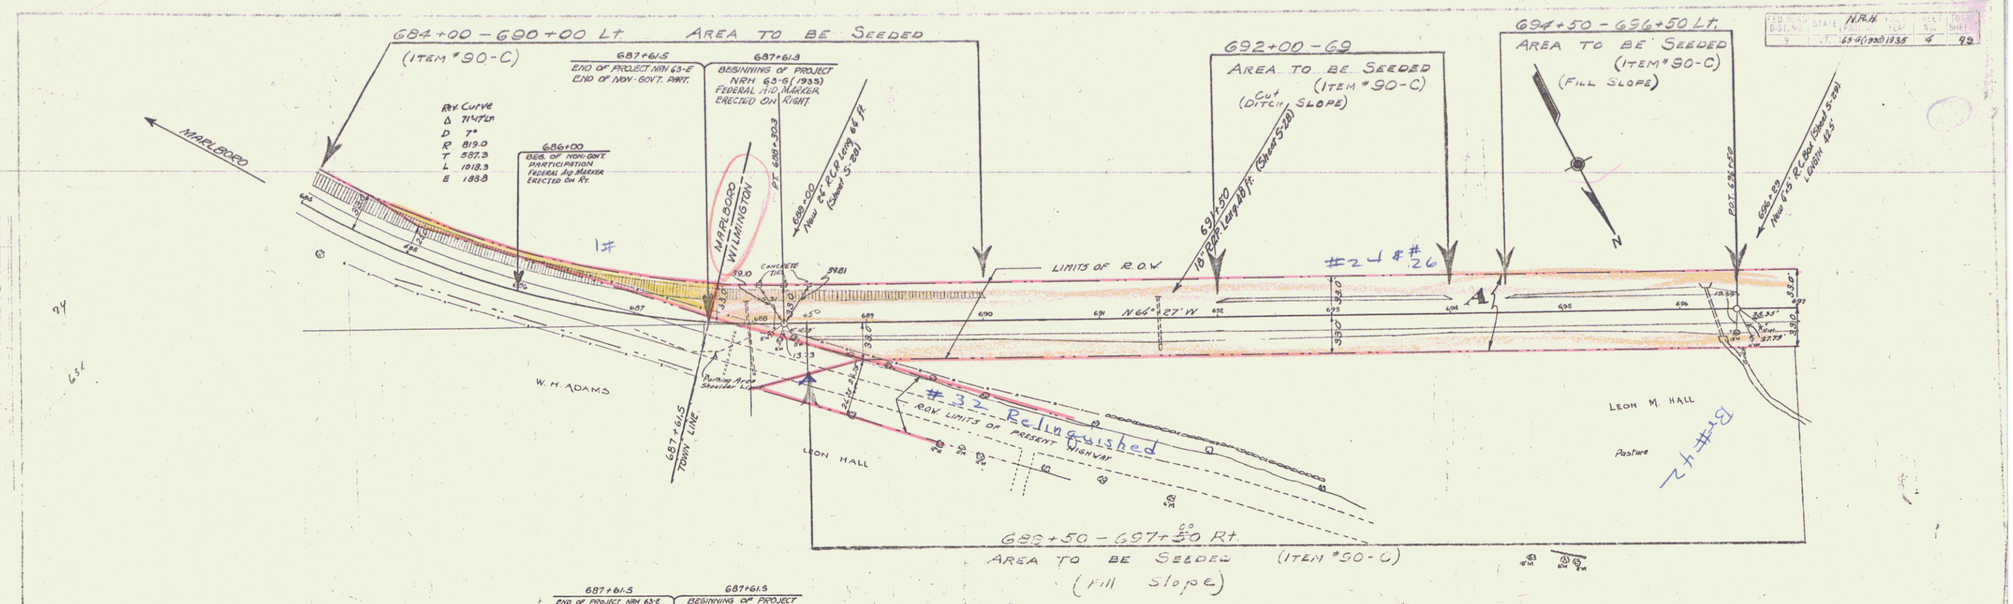

Parcel	Kind of Instrument	Date of Instrument	Grantor	Grantee	Recorded Wilmington Book	Page	Date	Remarks
A	W.D.	1-15-35	Leon M. & Marie Y. Hall	State of Vt.	30	77+73	1-21-35	

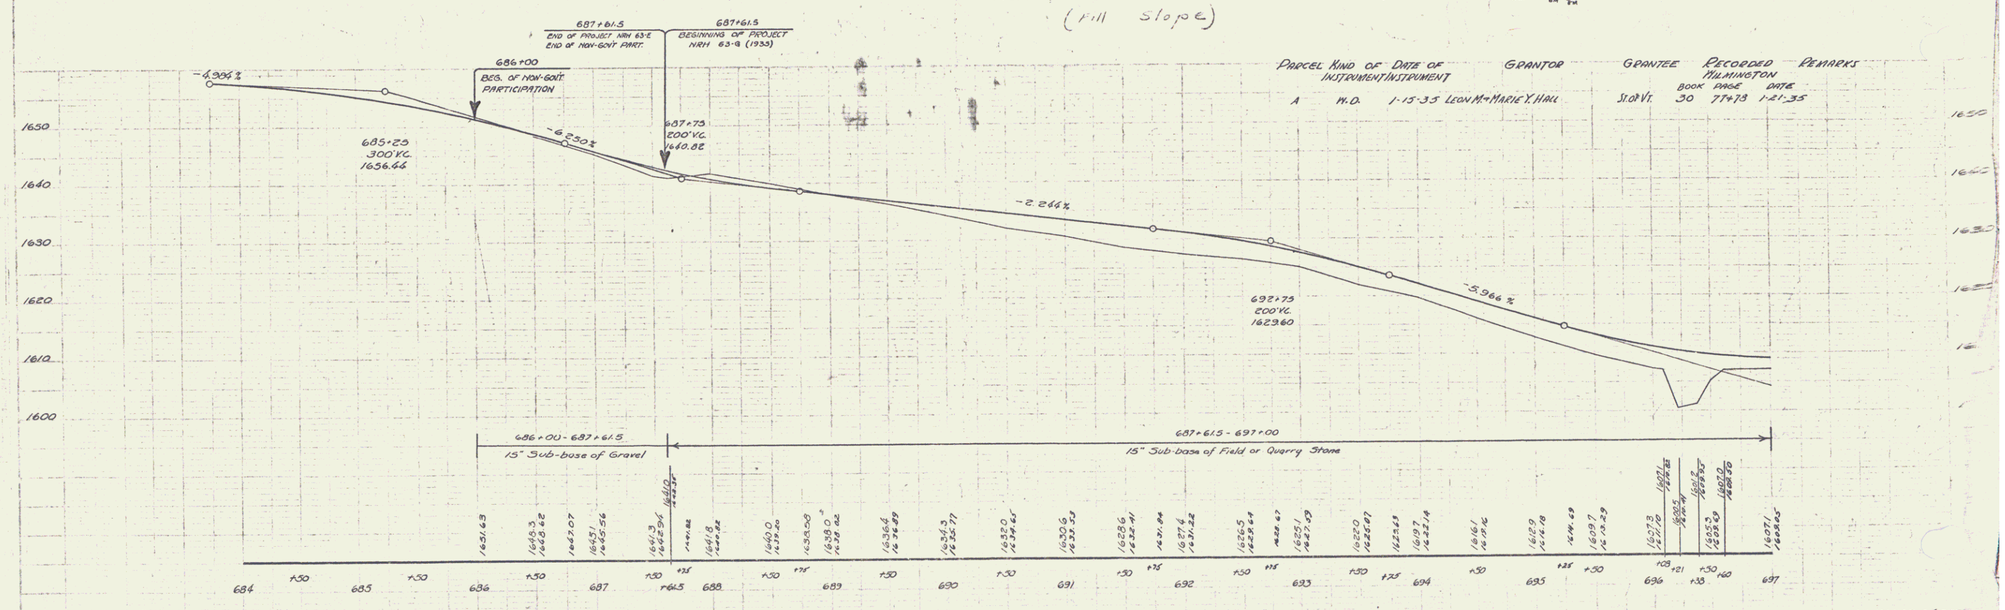

SERIES NRH No. 63-G (1935)
SHEET 3 OF 49

2