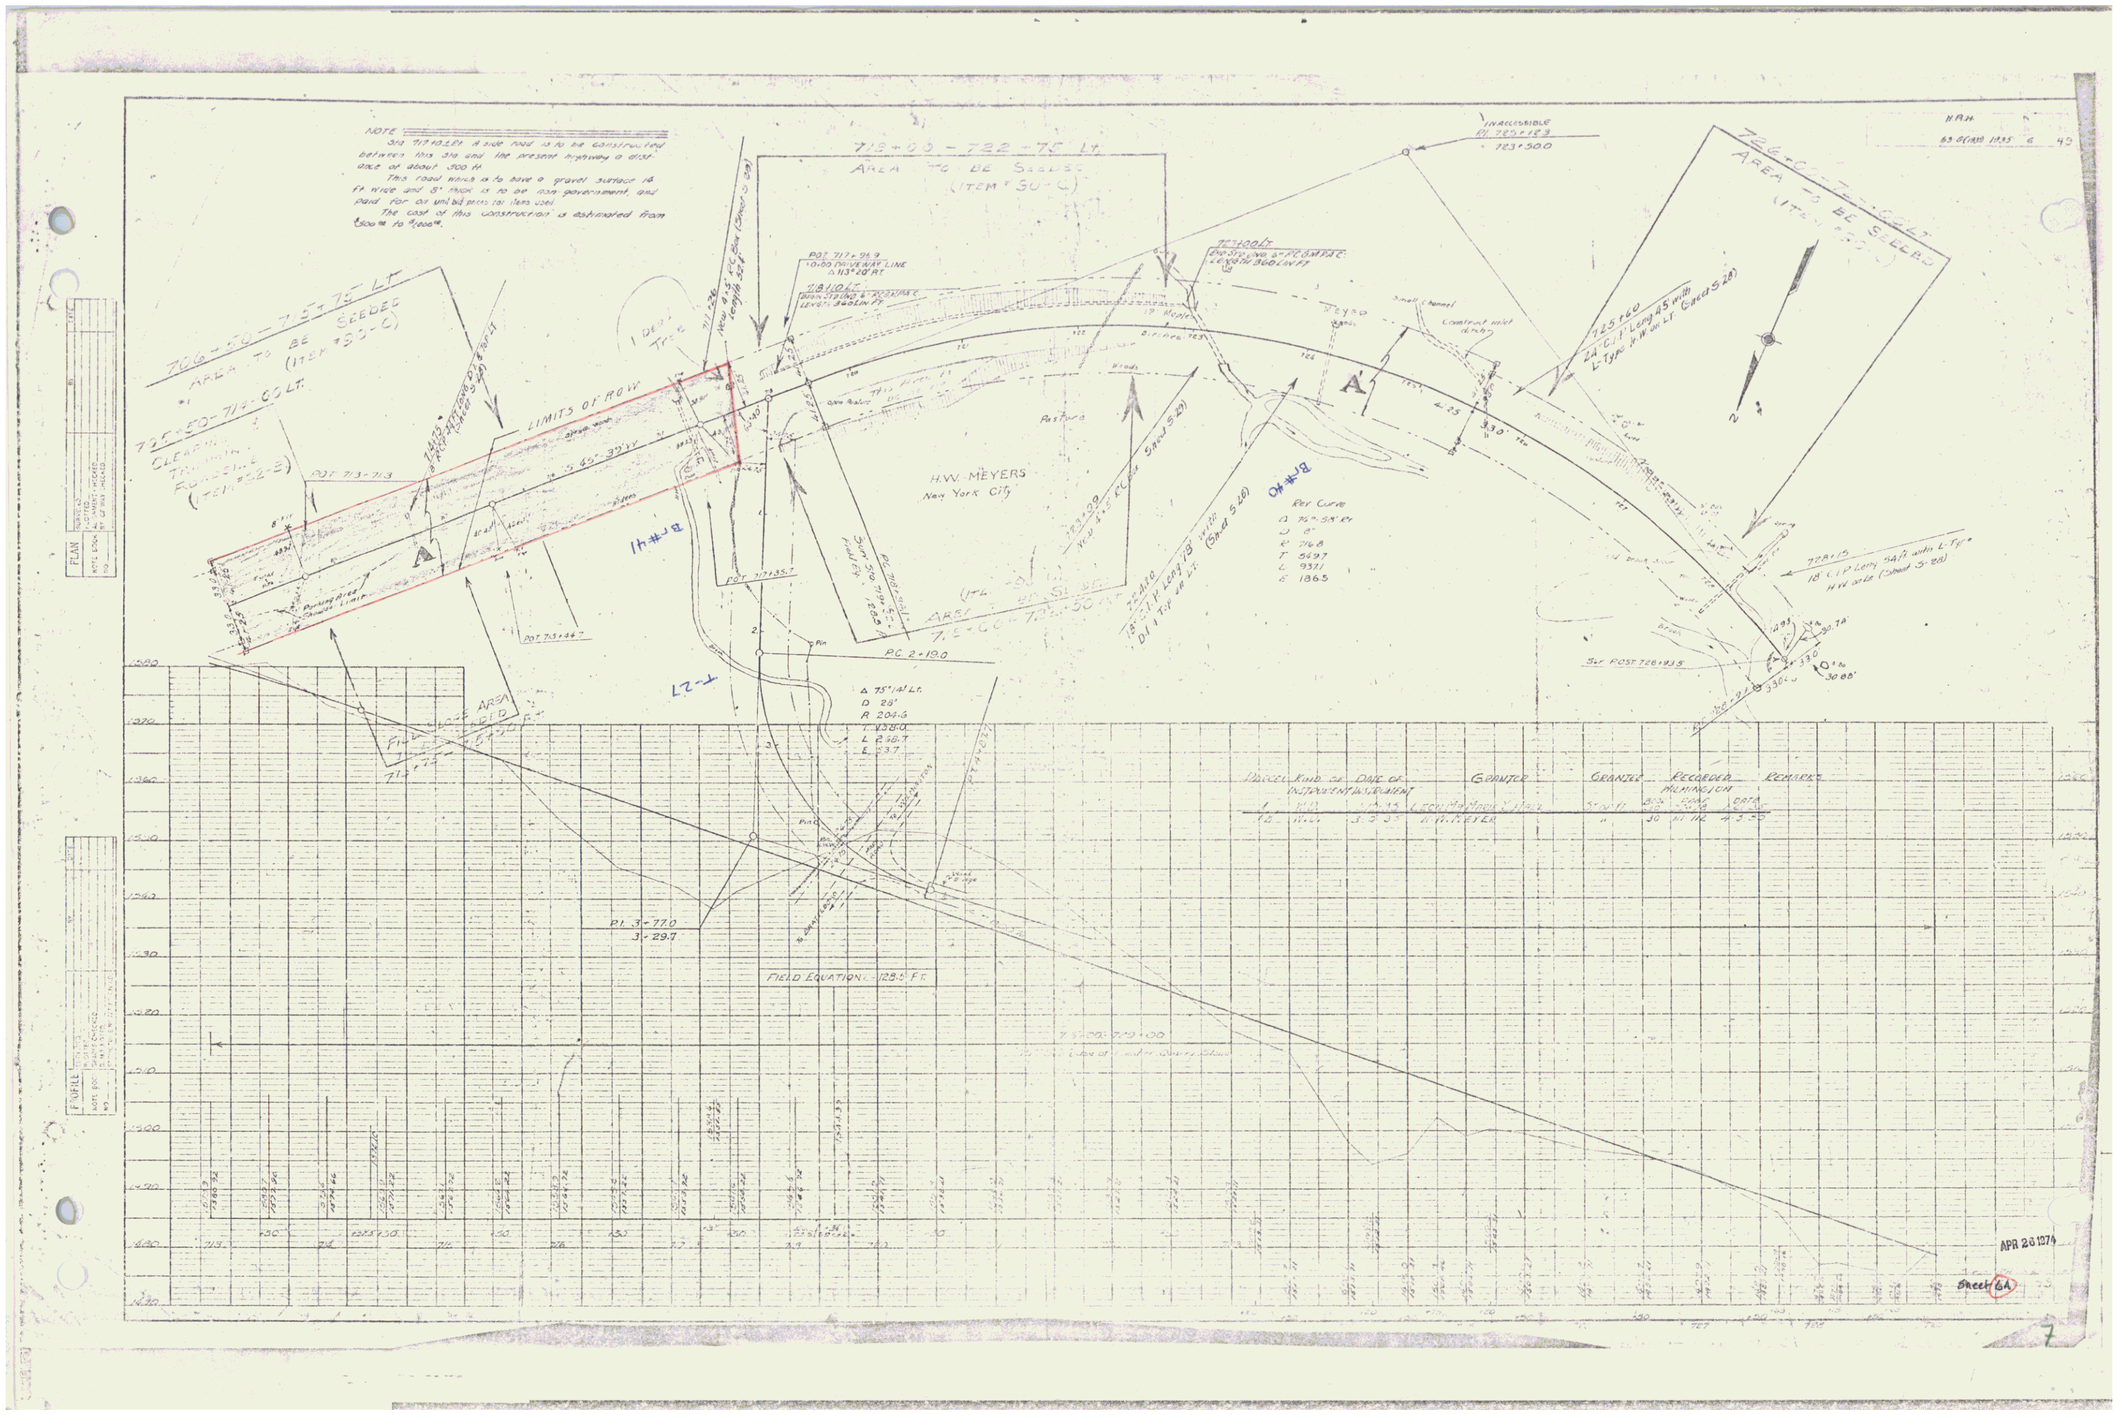
NOTE
Sta 717+00±Lt A side road is to be constructed between this sta and the present highway a distance of about 300 ft.
This road width is to have a gravel surface 16 ft wide and 5" thick is to be non-pavement and paid for as unclassified excavation.
The cost of this construction is estimated from $500.00 to $600.00.
AREA TO BE SEEDED (ITEM # SU-C)
LIMITS OF R.O.W.
H.W. MEYERS
New York City
INACCESSIBLE
Curve Data
Δ 75°-58' Rt
D 8°
R 716.8
T 569.7
L 937.1
E 186.5
Δ 75°14' Lt.
D 28°
R 204.6
T 153.50
L 268.7
E 33.7
P.C. 2+19.0
P.I. 3+77.0
3+29.7
FIELD EQUATION = 128.5 FT.
PARCEL | KIND OF INSTRUMENT | DATE OF INSTRUMENT | GRANTOR | GRANTEE | RECORDER'S ILLUMINATION | REMARKS
APR 26 1974
Sheet 6A