FED. ROAD DIST. NO.	STATE	PROJ. NO.	FISCAL YEAR	SHEET NO.	TOTAL SHEETS
1	VT.	NRH 63 E	1934	6	64

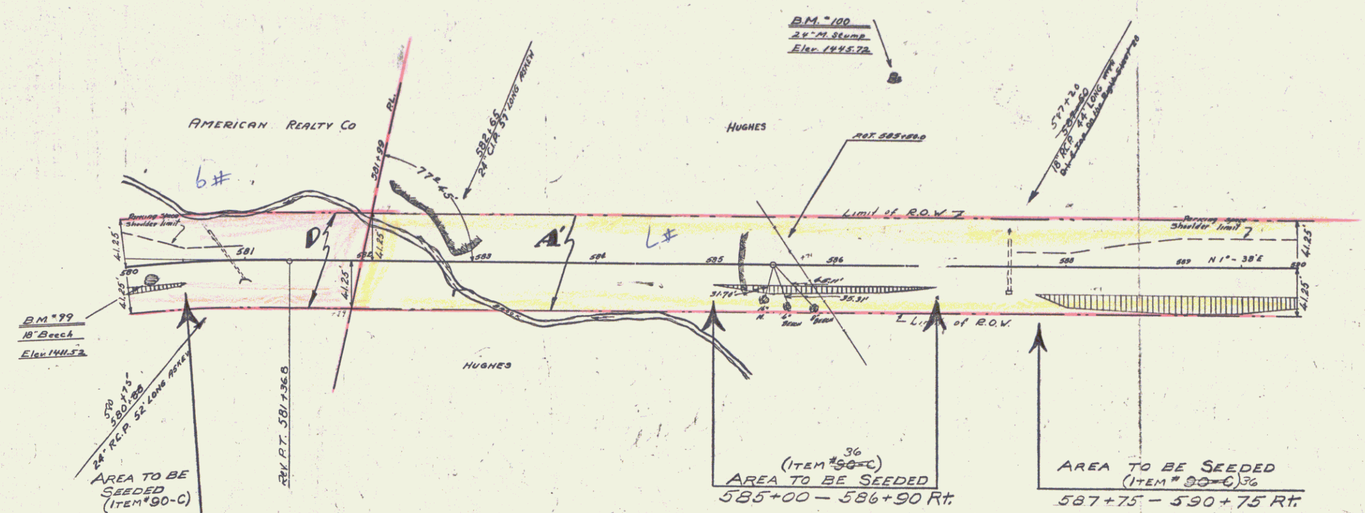

Parcel	Kind of Instrument	Date of Instrument	Grantor	Grantee	Recorded Middlebro Book	Page	Date	Remarks
A.B.C.D	Q.C.D.	7-31-34	American Realty Co.	State of Vt.	18	496-497	8-13-34	
A'	W.D.	6-23-34	George L. Hughes	"	18	493	7-13-34	