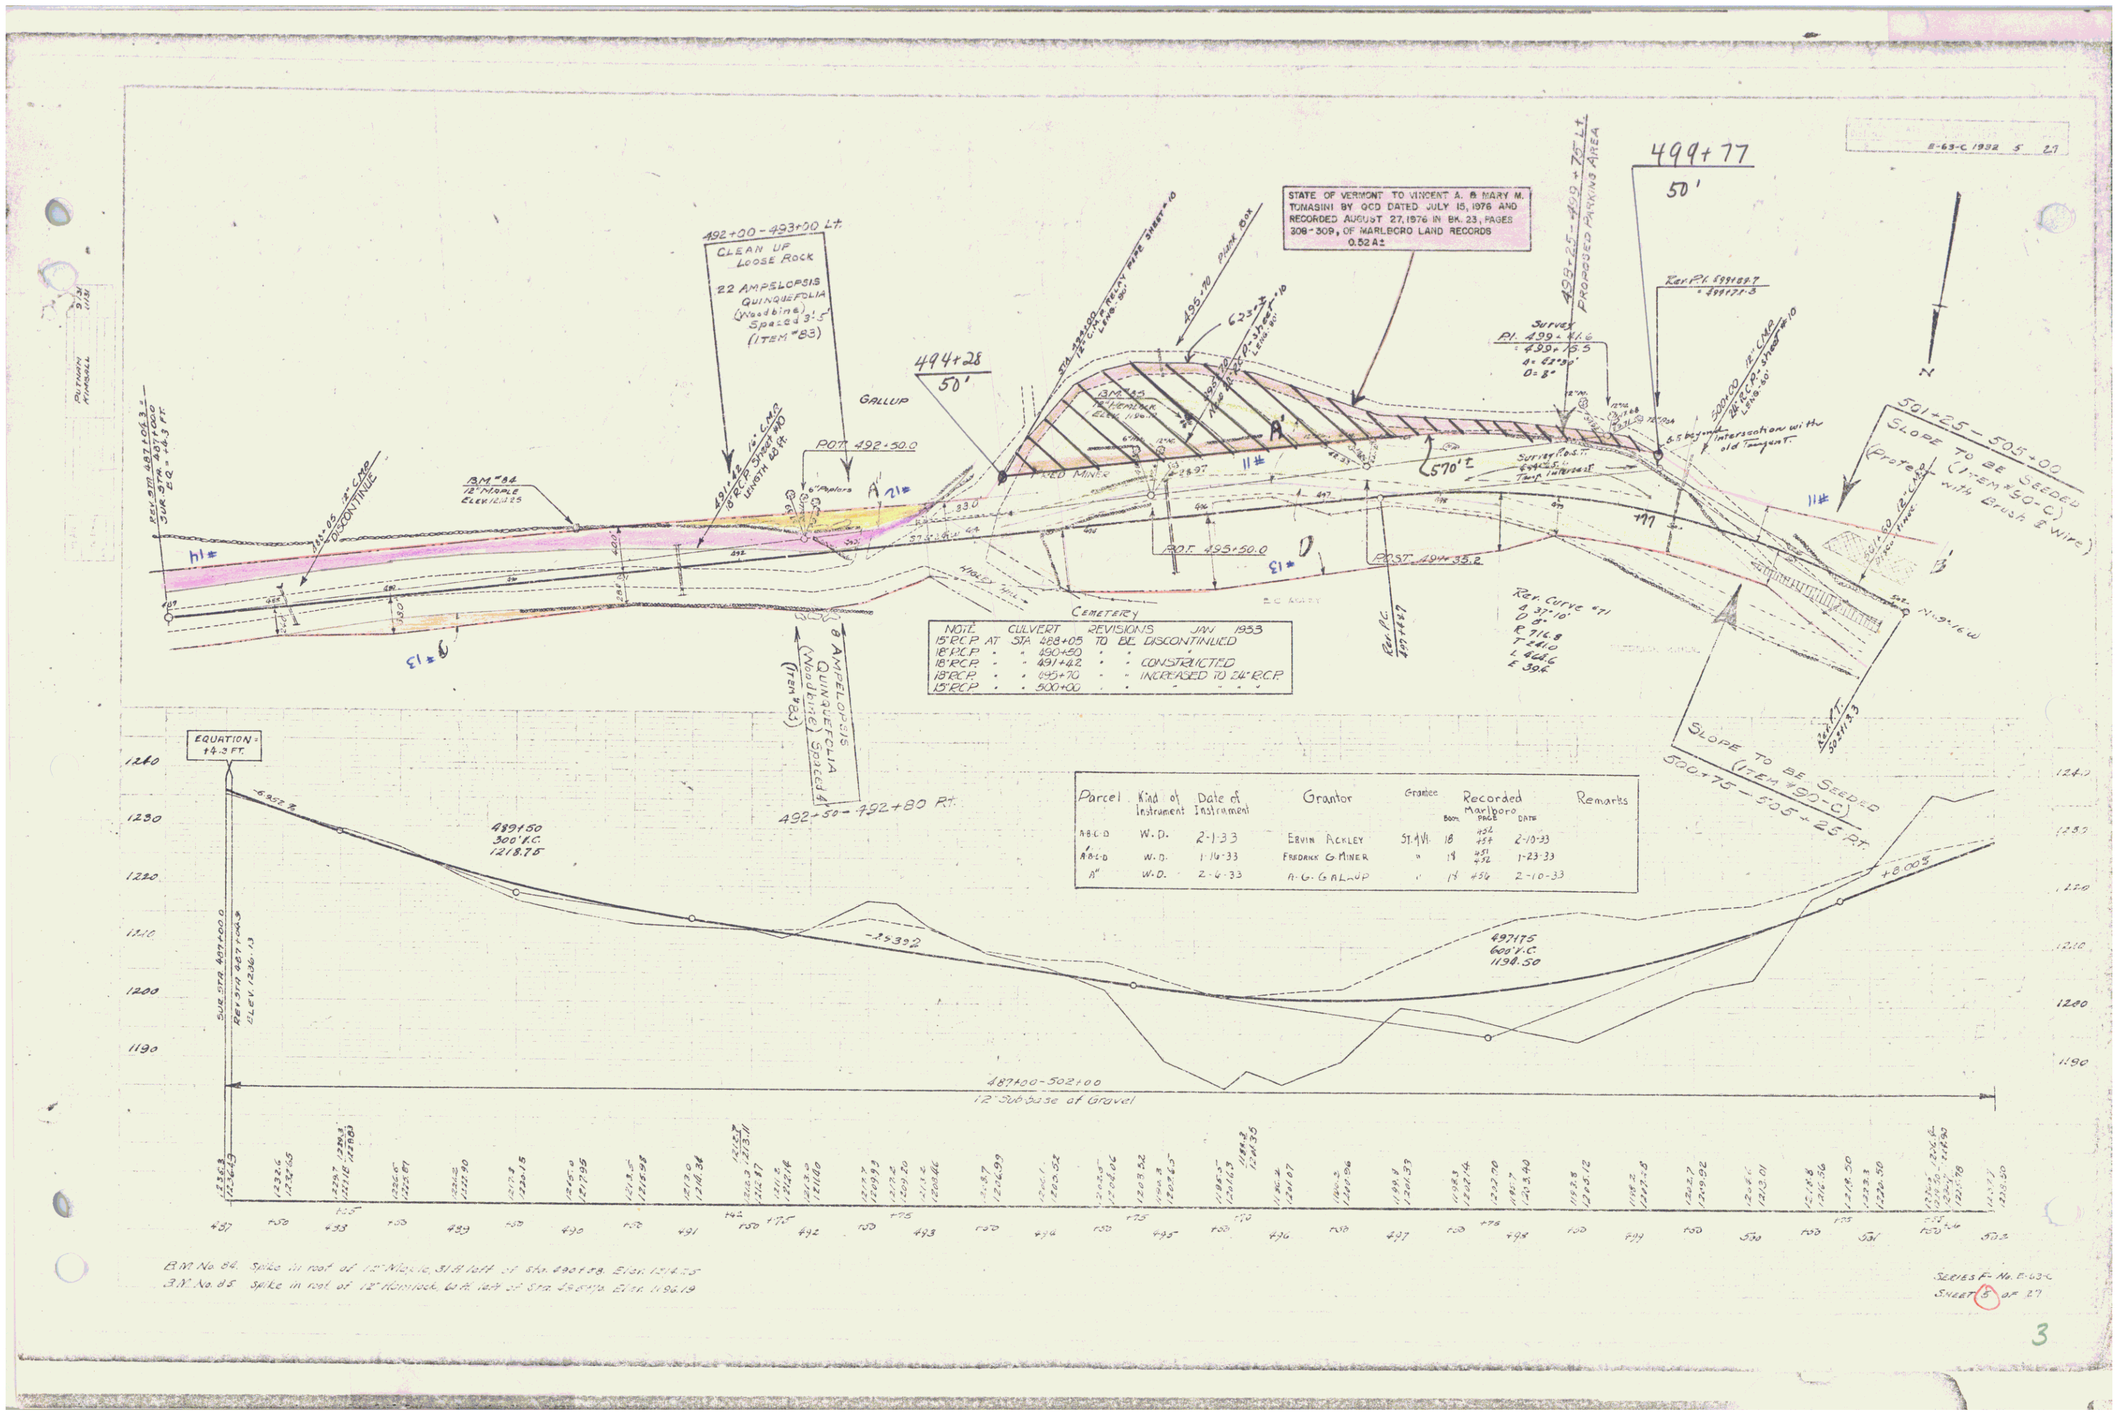
STATE OF VERMONT TO VINCENT A. & MARY M. TOMASINI BY QCD DATED JULY 15, 1976 AND RECORDED AUGUST 27, 1976 IN BK. 23, PAGES 308-309, OF MARLBORO LAND RECORDS
0.52 Ac±
492+00 - 493+00 Lt.
CLEAN UP LOOSE ROCK
22 AMPELOPSIS QUINQUEFOLIA (Woodbine) Spaced 3'-5' (ITEM #83)
494+28
50'
499+77
50'
GALLUP
POT. 492+50.0
POT. 495+50.0
POT. 494+35.2
CEMETERY
PROPOSED PARKING AREA
Survey PI. 499+41.6
= 499+15.5
Δ = 62°30'
D = 8°
Rev. Curve #1
Δ 37°10'
D 8°
R 716.8
T 244.0
L 464.6
E 39.6
Rev. P.C. 499+89.7
= 499+77.3
Intersection with old Tangent.
Surveyed Tangent
Rev. P.C. 497+44.7
Rev. P.C. 497+77.3
SLOPE TO BE SEEDED (Protect (1"-5" R50-C) with Brush & Wire)
501+25 - 505+00
SLOPE TO BE SEEDED (ITEM #90-C)
500+75 - 505+25 Rt.
N
N-39-16-W
NOTE CULVERT REVISIONS JAN 1953
15" R.C.P. AT STA 488+05 TO BE DISCONTINUED
18" R.C.P. " " 490+50 " "
18" R.C.P. " " 491+62 " " CONSTRUCTED
18" R.C.P. " " 495+70 " " INCREASED TO 24" R.C.P.
15" R.C.P. " " 500+00 " "
Parcel | Kind of Instrument | Date of Instrument | Grantor | Grantee | Recorded Book | Page | Date | Remarks
A&C D | W.D. | 2-1-33 | Ervin Ackley | St. Mt. | 18 | 424 | 2-10-33
A&C D | W.D. | 1-16-33 | Frederick G. Miner | " | 18 | 451 / 452 | 1-23-33
A" | W.D. | 2-6-33 | A. G. Galup | " | 18 | 456 | 2-10-33
EQUATION = +4.3 FT.
489+50
300' V.C.
1218.75
497+75
600' V.C.
1198.50
-3.392
+8.005
487+00 - 502+00
12" Subbase of Gravel
B.M. No. 84. Spike in root of 12" Maple, 31.8' left of Sta. 490+58. Elev. 1214.75
B.M. No. 85 Spike in root of 12" Hemlock, 6.4' left of Sta. 496+70. Elev. 1196.19
SERIES F-No. F-63-C
SHEET 5 OF 27
3