


Parcel	Kind of Instrument	Date of Instrument	Grantor	Grantee	Recorded Book	Recorded Page	Recorded Date	Remarks
A-B-C-D	W.D.	1-16-33	FREDRICK MINER	ST. AUT. 14	451	452	12-3-33	
A-B-C-D-E	W.D.	2-1-33	ERWIN AKLEY	"	451	450	2-10-33	

E-63-C 1932 6 29

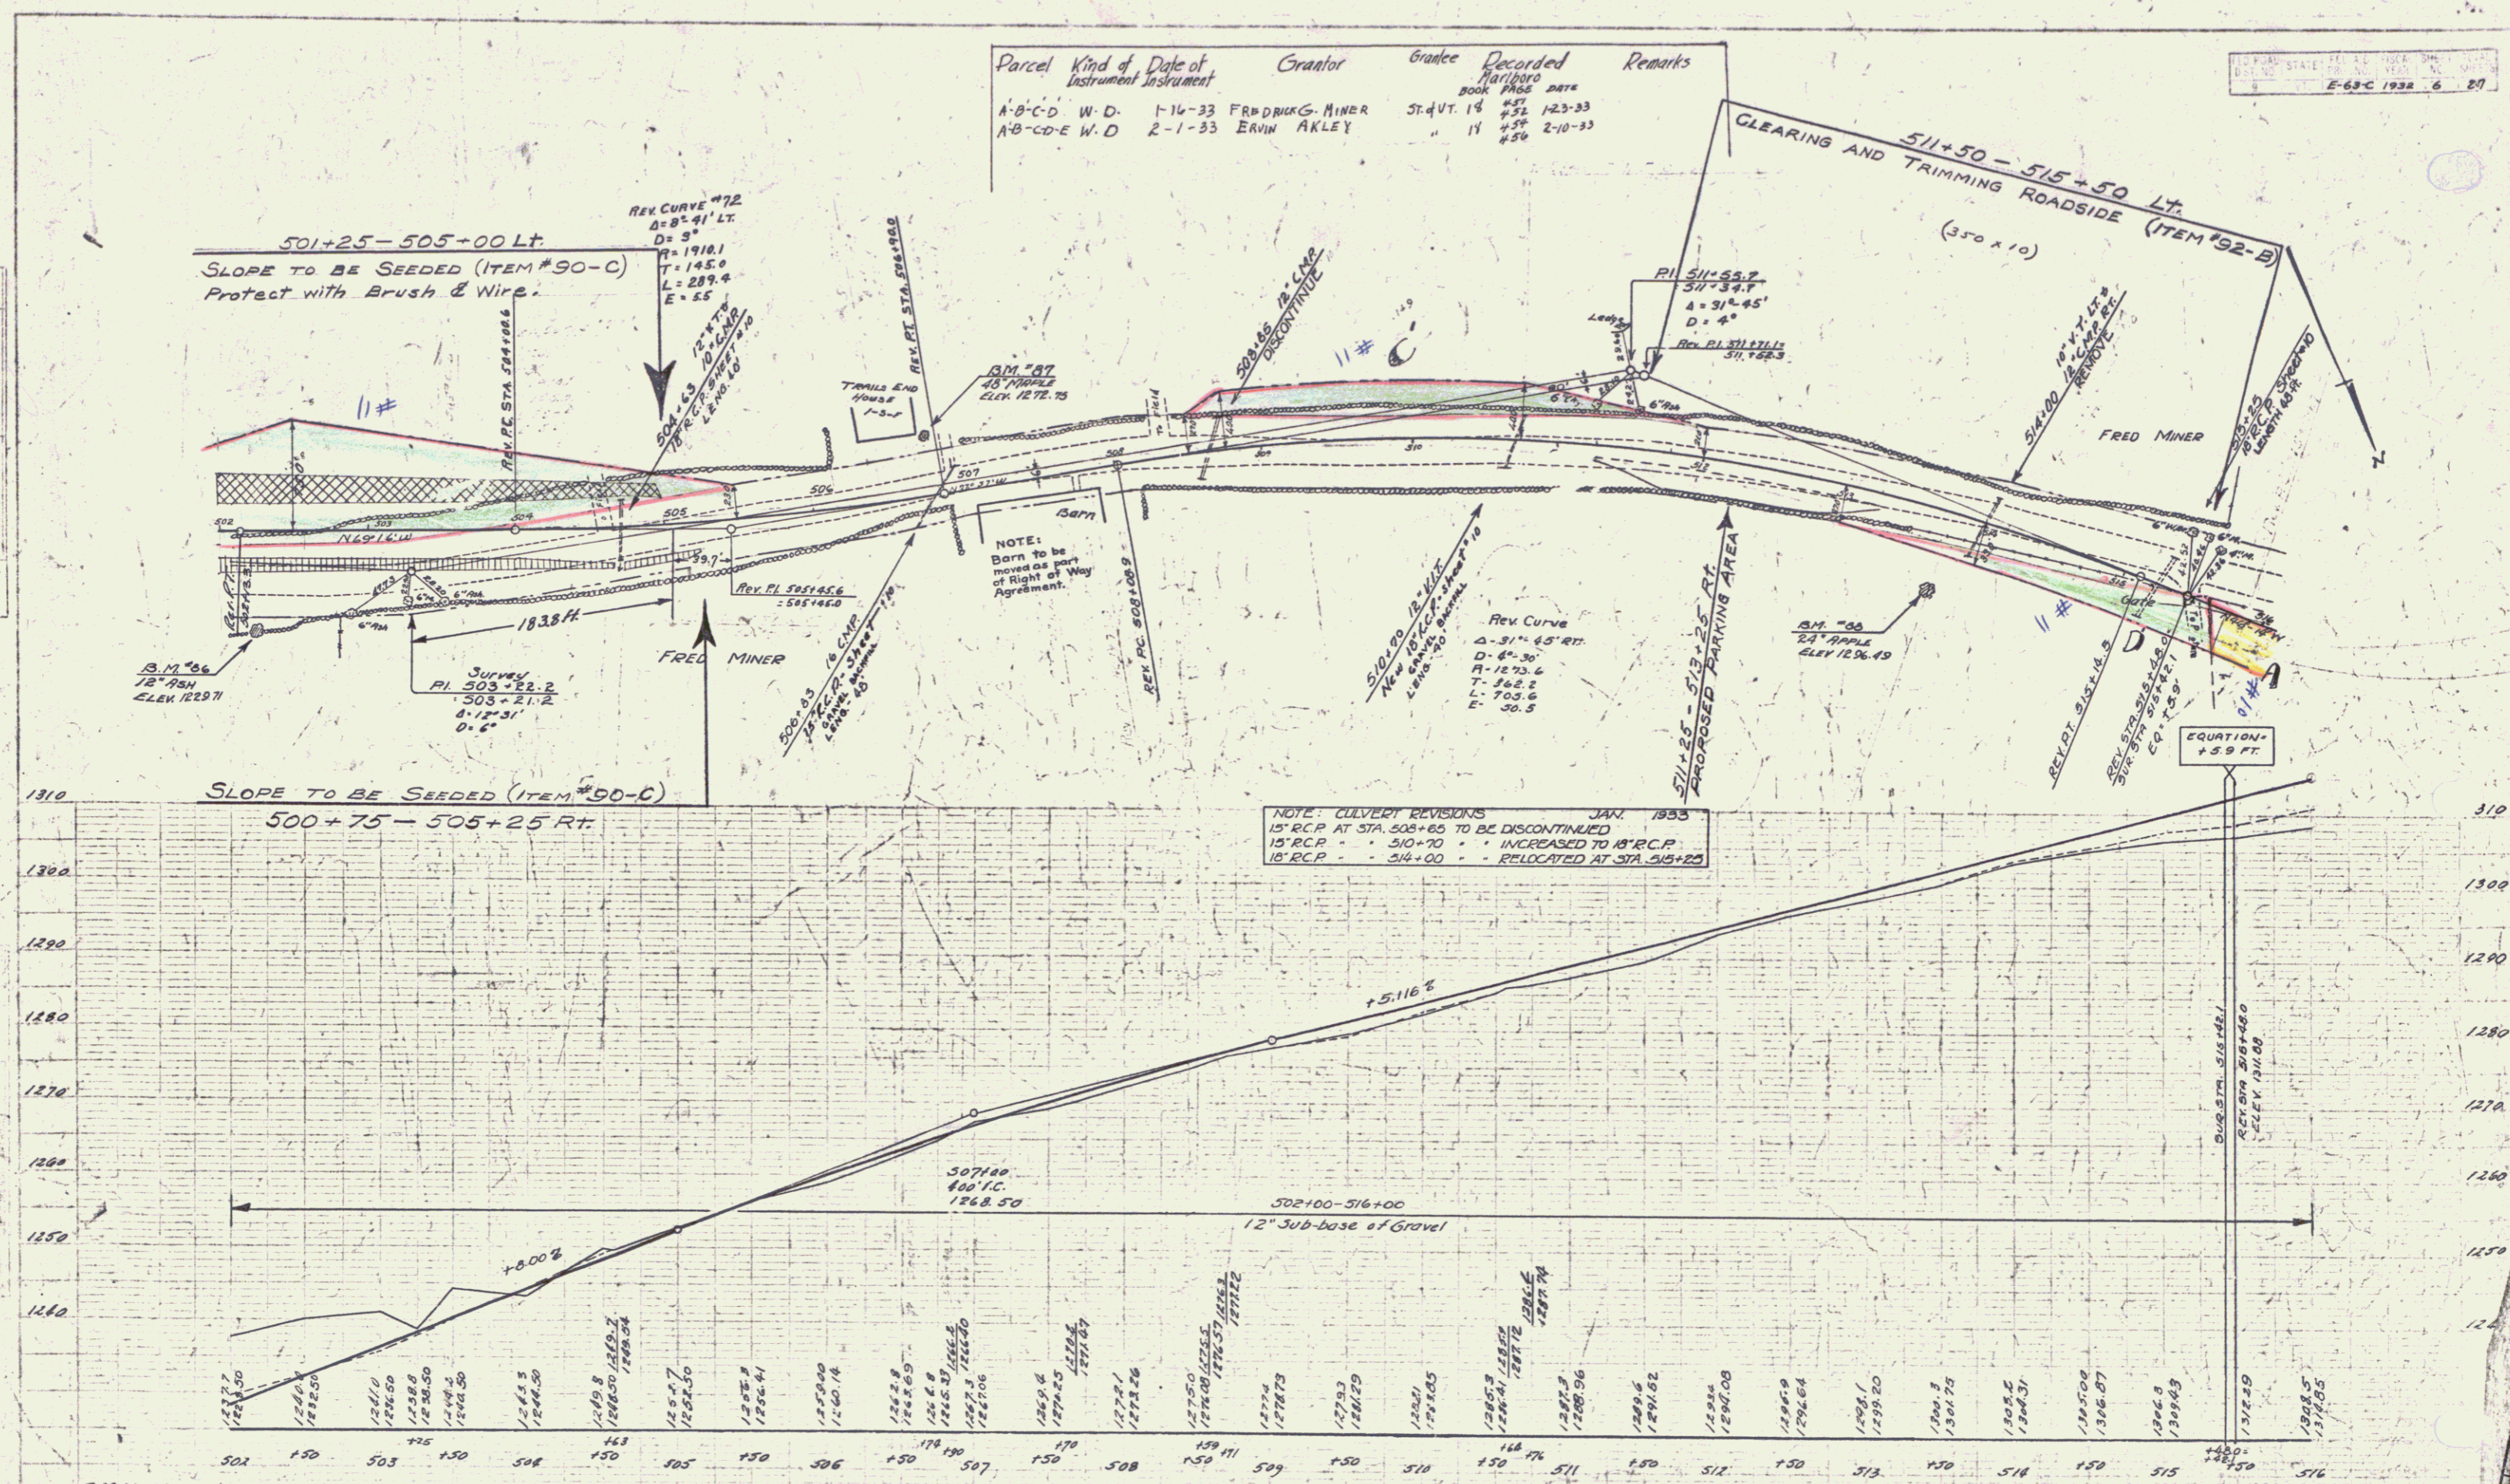

 B.M. No. 67 Spike in root of 48" Maple 56H left of Sta. 506+78 Elev. 1272.75  
 B.M. No. 68 Spike in root of 24" Apple 50H right of Sta. 513+70 Elev. 1296.49

SERIES E-63-C  
 SHEET 6 OF 27

4