Wood Guard Rail Required

Culv. Sta.	Left	Right
386+58	24'	–
394+65	24'	–

Wood Guide Posts Required

Culv. Sta.	Left	Right
381+50	1	1
386+58	–	1
394+65	–	2

New Reinf. Conc. Pipe Culverts Required

Station	Diam.	Leng.	Conc. R.	Steel	C.P.M.
381+50	15"	48'	1.5 c.y.	73#	–
386+58	18"	48'			3.6
394+65	30"	36'	3.2	58	–

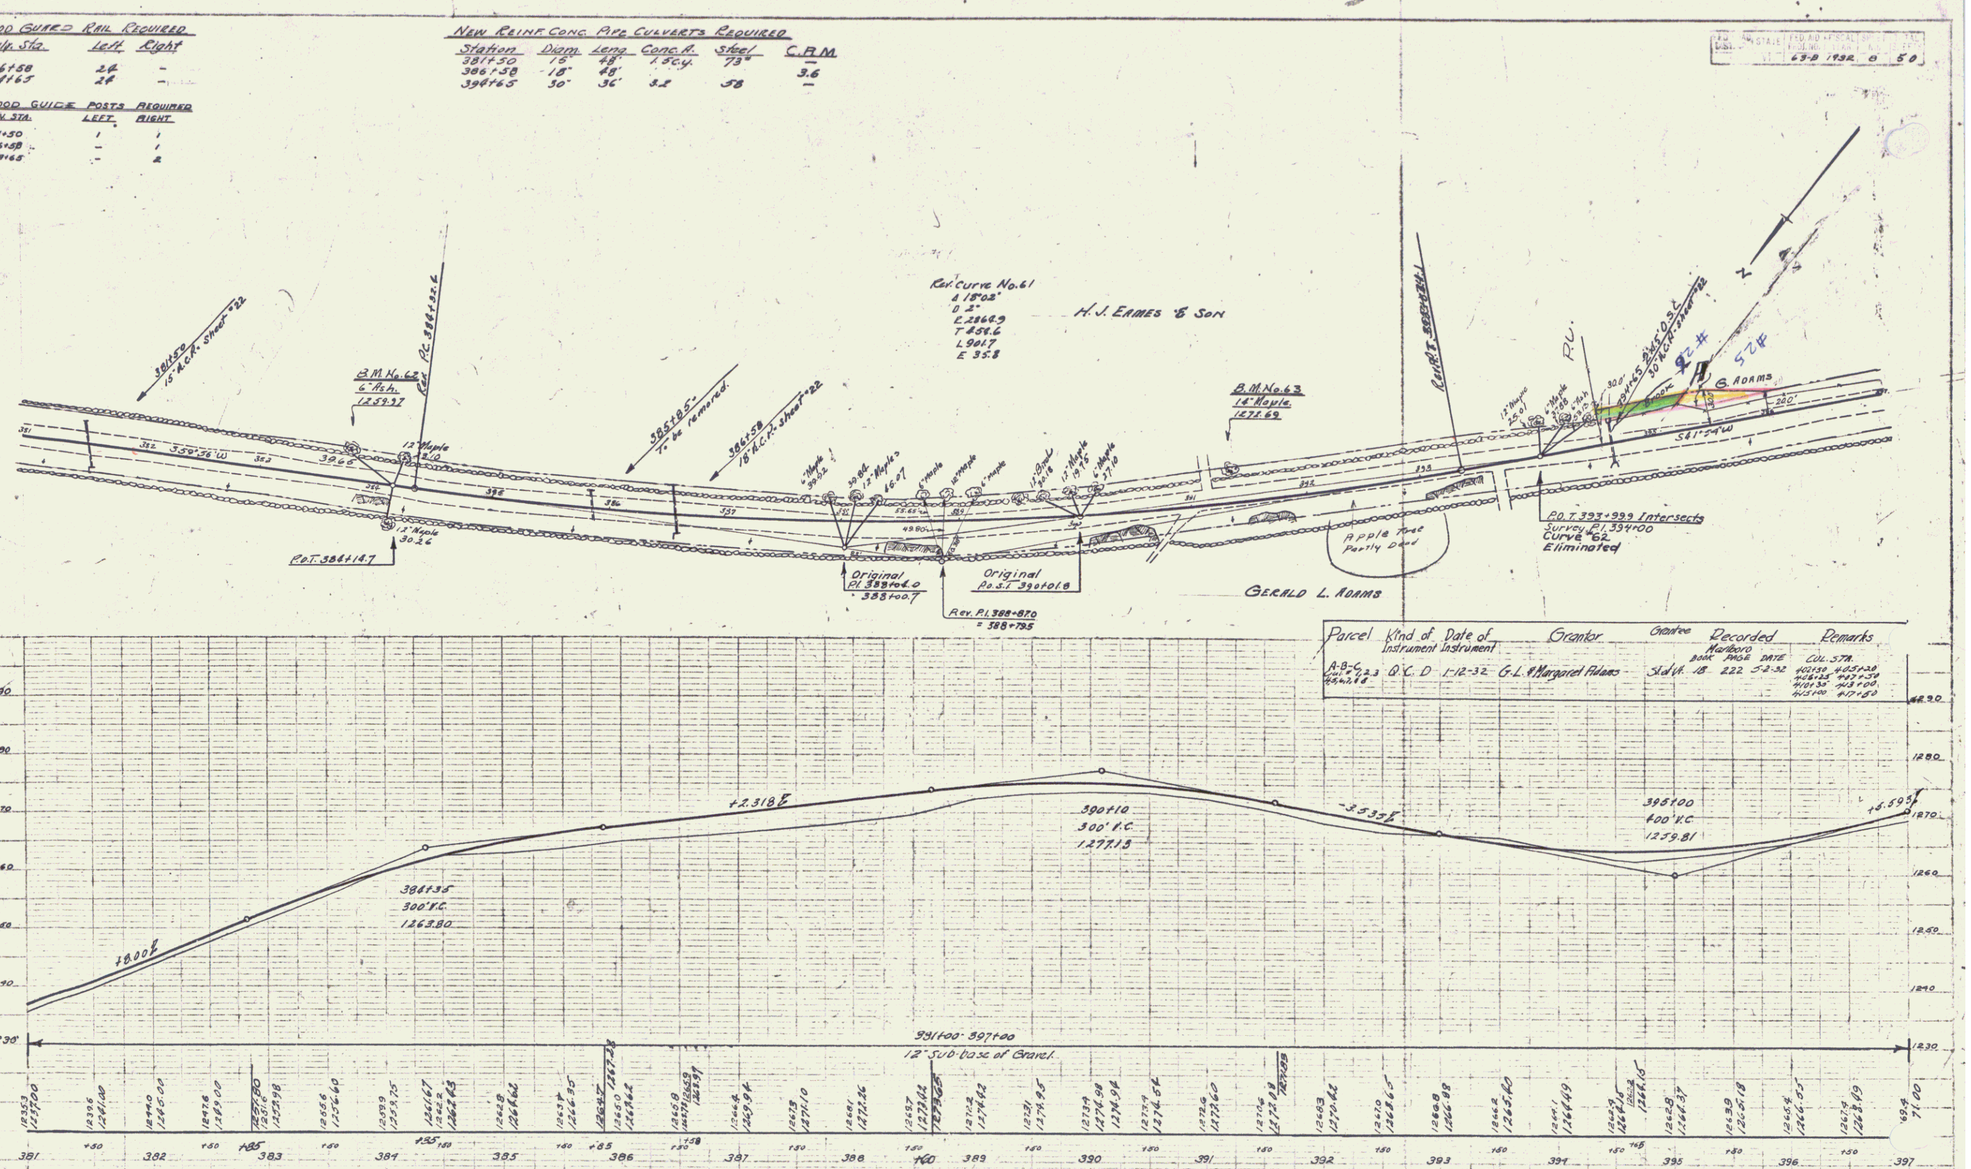

Parcel	Kind of Instrument	Date of Instrument	Grantor	Grantee	Recorded Marlboro Book	Page	Date	Remarks Col. Sta.
A-B-C Sheet #23 #24	Q.C.D.	1-12-32	G.L. & Margaret Adams	Sold to	18	222	5-2-32	402+50 to 405+20; 406+55 to 409+39; 410+35 to 412+20; 412+00 to 417+50

SERIES F - No. 63-13
SHEET 8 OF 50

6