

WOOD GUARD RAIL REQUIRED

Culvert Sta.	Left	Right
444.25	24'	
454.158	24'	

WOOD GUARD POSTS REQUIRED

Culvert Sta.	Left	Right
450.178		1

CELL GUARD RAIL REQUIRED


Stations	Length	Count	Remarks
447.152-451.51	4.36'	40'	216'
452.120-453.180	1.06'	60'	200'
454.100-454.120	0.20'	40'	136'
449.100-451.120	2.02'	40'	264'

NEW REINFORCING PIPE CULVERTS REQUIRED

Station	Diam.	Length	C.R.M.
447.75	18"	30'	3.85
450.178	15"	60'	2.7
454.78	15"	60'	2.7

Parcel	Kind of Instrument	Date of Instrument	Grantor	Grantee	Recorded	Remarks
A-2-20-2	Q.C.D.	3-16-32	Una W. Warnock	St. of Vt. 18	BOOK PAGE DATE 441 432 5-2-32	CUL. STA. 452.120-454.120 454.100-454.120

STATE OF VERMONT
63B 1932 12 50

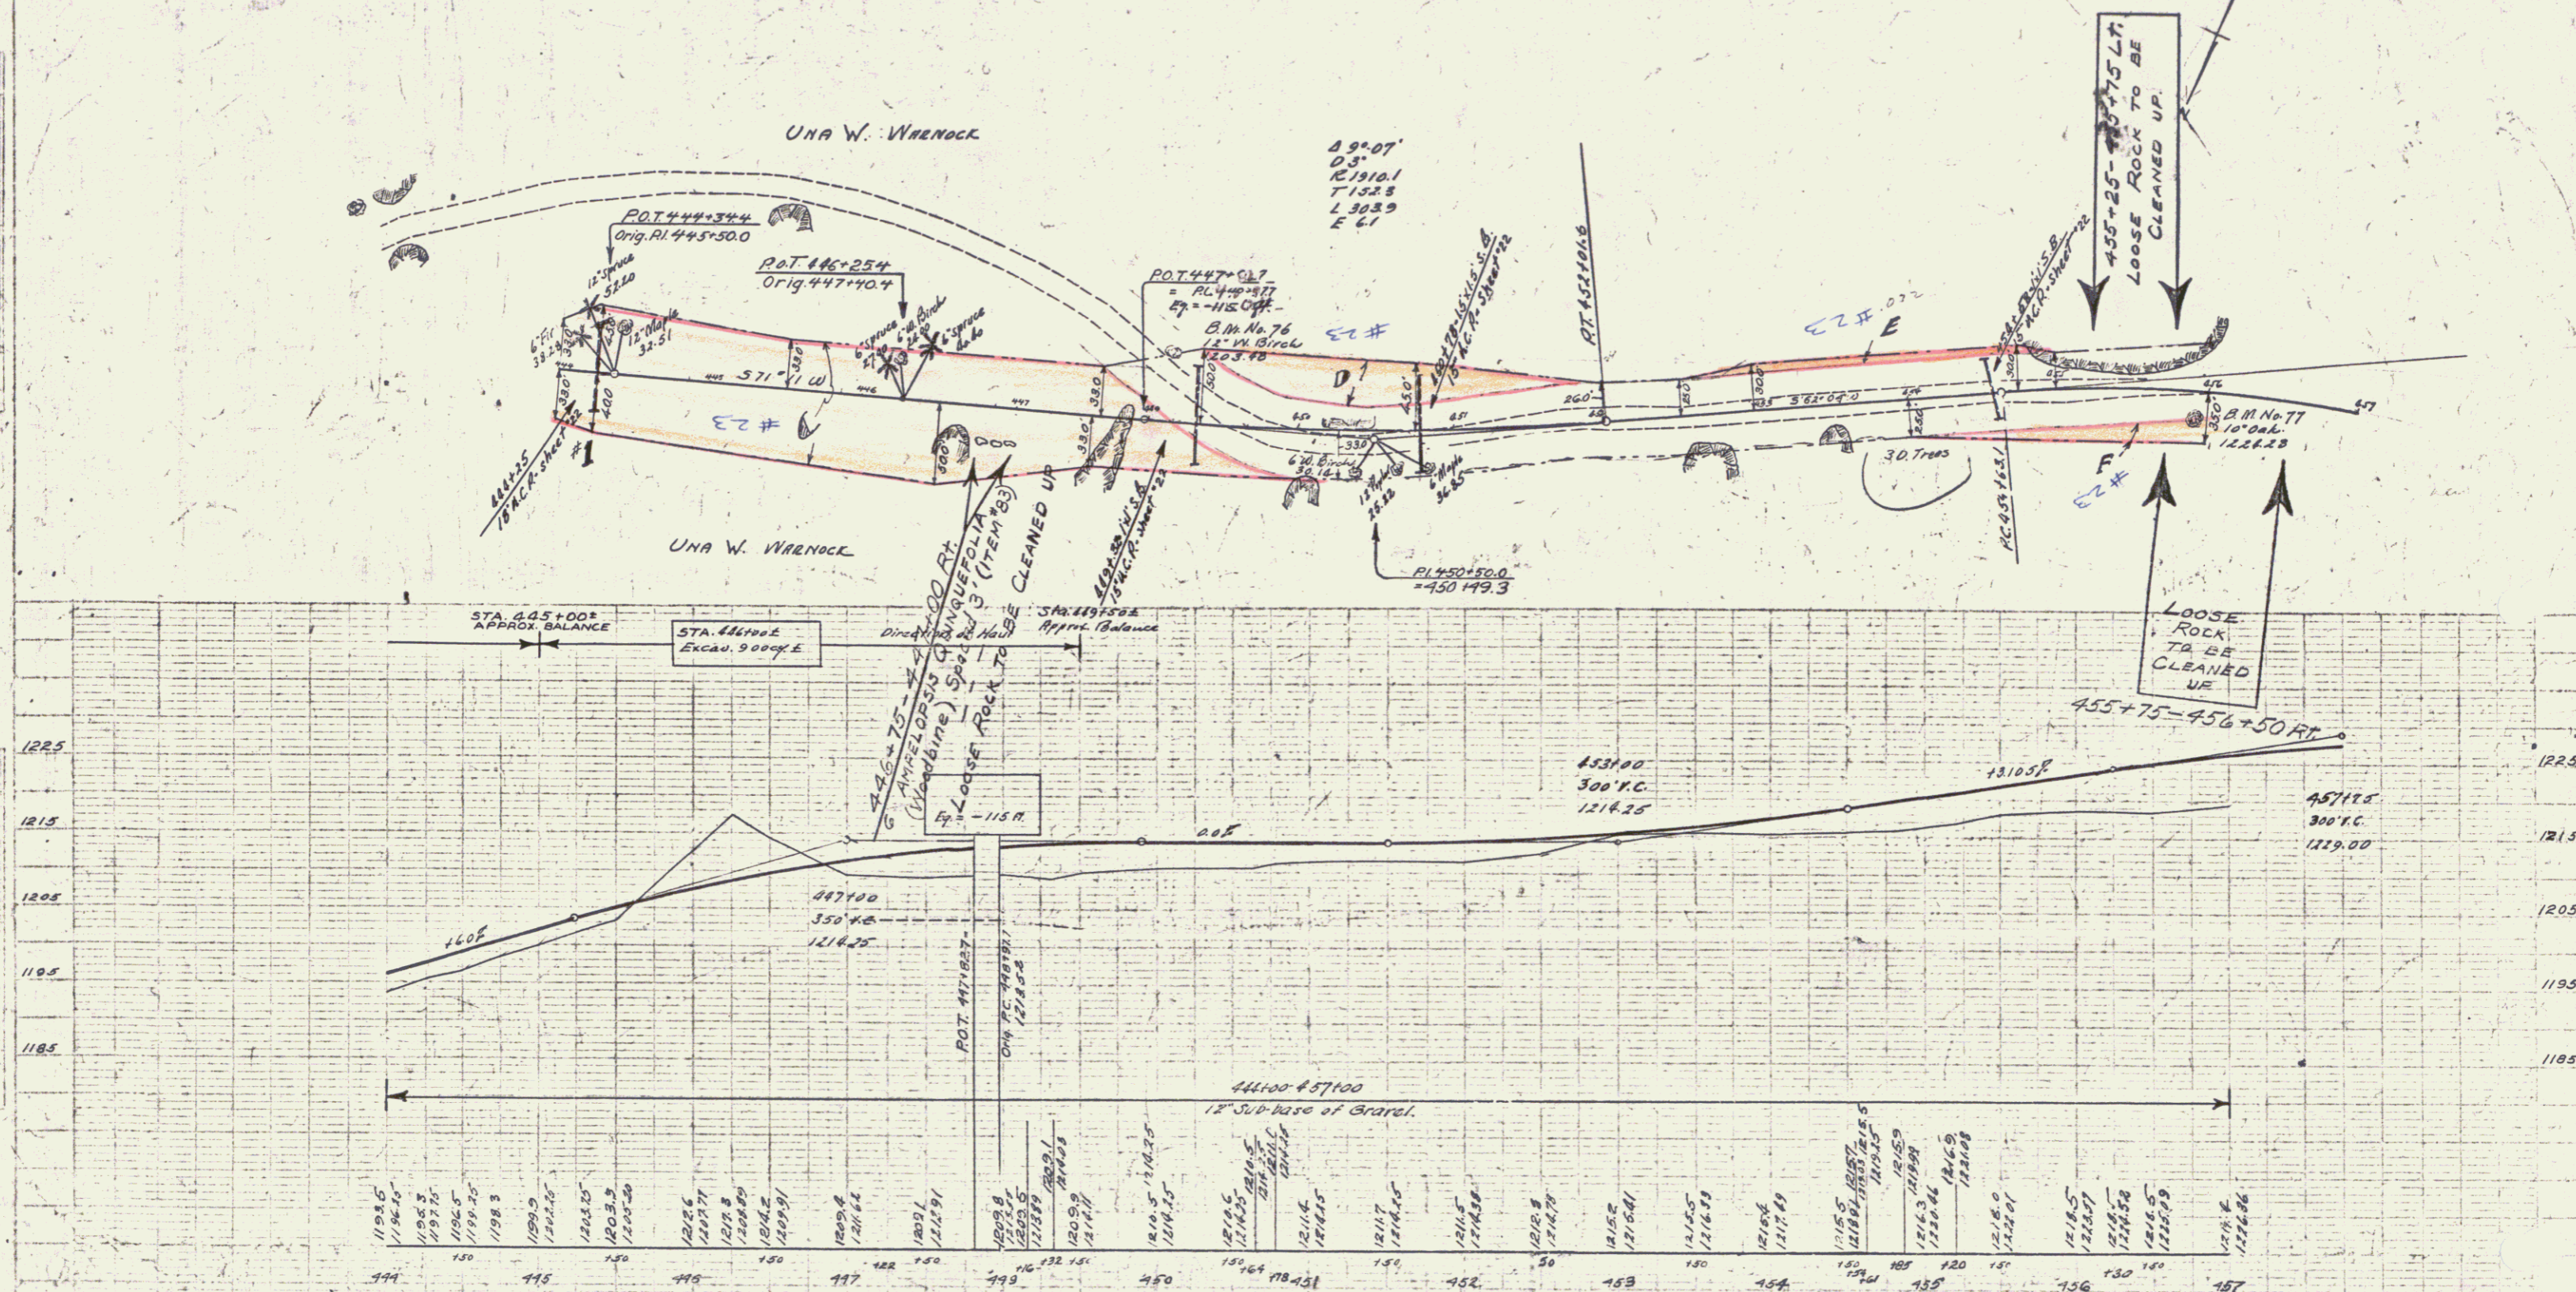

B.M. No. 76. Spike in roof of 12" W. Birch, 48" H. 1/2" of Sta. 447+25 Elev. 1208.48
 B.M. No. 77. Spike in roof of 10" Oak, 54" H. right of Sta. 454+72 Elev. 1224.28

SERIES F No 63 B
 SHEET 12 OF 50

10