FED. AID DIST. NO.	STATE	FED. AID PROJ. NO.	FISCAL YEAR	SHEET NO.	TOTAL SHEETS
3	VT	F	1918	4	16

GUARD RAIL REQUIRED

ON LEFT

" 25+00	"	" 28+00	"	300-

ON RIGHT

Sta. 20+60	To	Sta. 20+64	"	24-
" 25+00	"	" 25+40	"	40-
" 27+08	"	" 27+32	"	24-
TOTAL THIS SHEET				516-

NEW CULVERTS REQUIRED

Sta. 20+61	16" Cor. Iron	30 ft.	Concrete Headwalls 1.5 cu. yds. (1-2-4)
" 25+20	Plain Concrete Culvert		3.4 " " (1-2-4)
			13.4 " " (1-3-6)
			.3 " " (1-2-4)
" 27+20	" " "		5.1 " " (1-3-6)

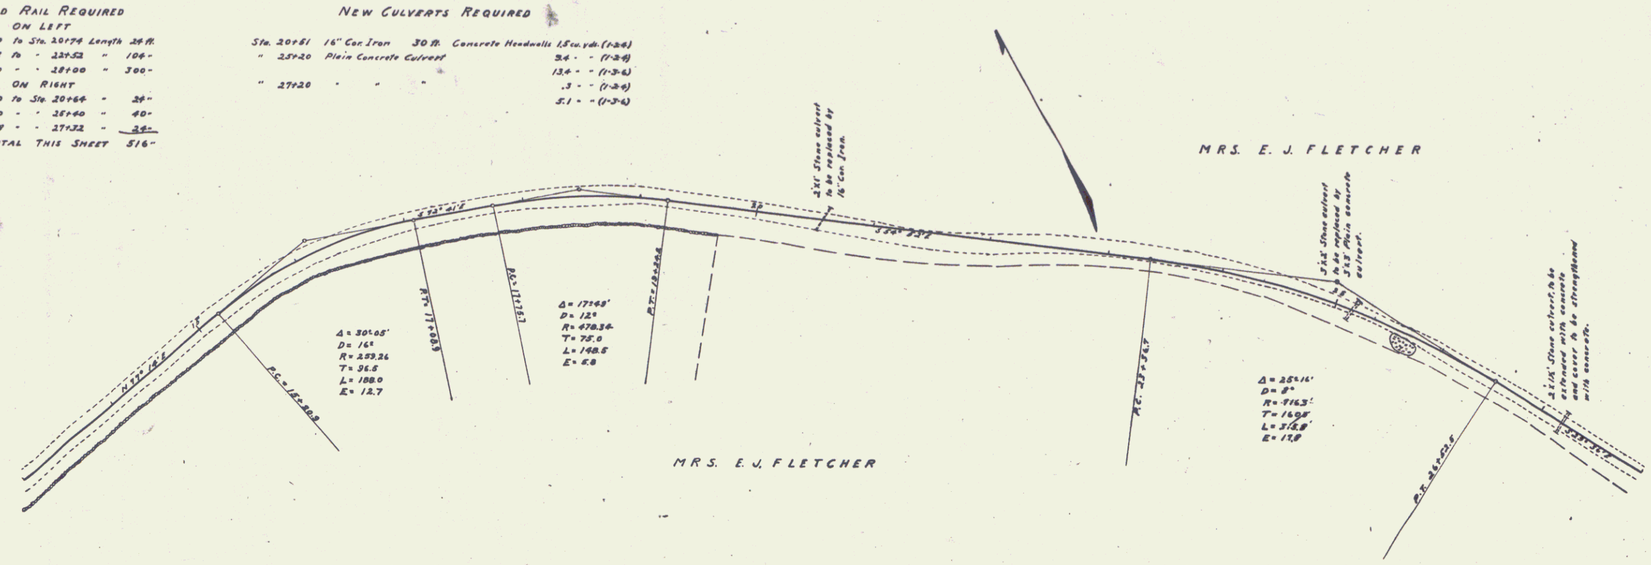

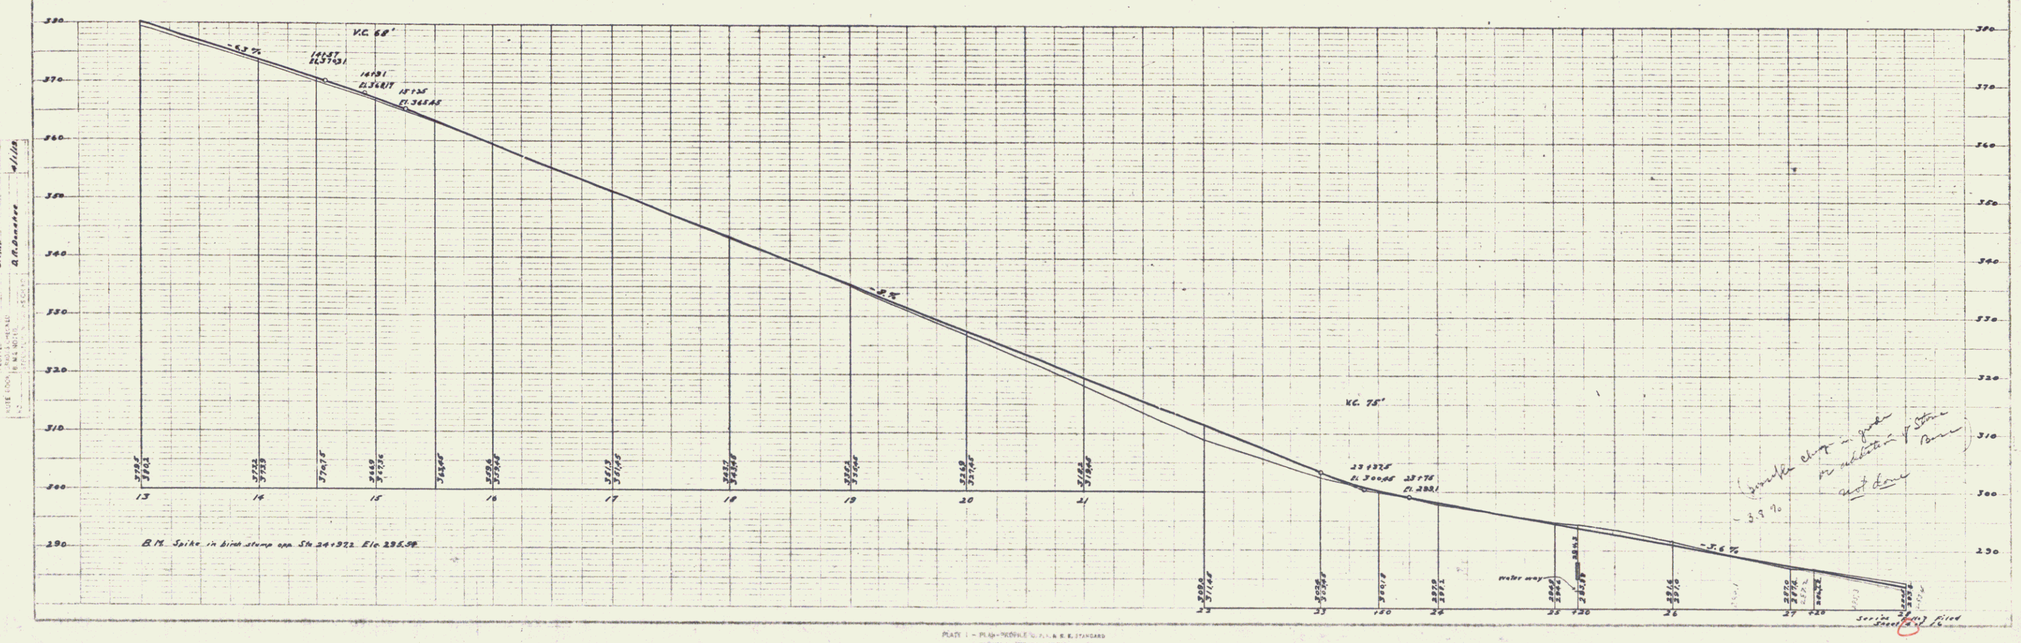

PLATE I — PLAN-PROFILE U. S. P. O. & R. R. STANDARD