1	TITLE SHEET
2-4	TYPICAL SHEETS
5	ALIGNMENT SHEET
6-7	QUANTITY SHEETS
8	DRAINAGE SHEET
9	EARTHWORK SHEET
10-11A	R.O.W. DETAIL SHEETS
12-17	PLAN AND PROFILE SHEETS
18	20 SCALE DETAIL
19-20	TRAFFIC SIGN & DELINEATOR LOCATION & SUMMARY SHEETS
21	TRAFFIC SIGN DETAIL SHEET
22	SIGN CONSTRUCTION DETAIL SHEET
23	A-61 SOLID ROCK EXCAVATION
24	B-1 BANKING TABLES
25	B-5 TYPICAL SLOPE GRADING
26	B-10 EMBANKMENT ON A SLOPE
27	B-11 METHODS OF SLOPE STABILIZATION
28	C-1 CURBS
29	C-1A CURBS
30	D-2 HEADWALLS
31	D-3 JUTE MATTING
32	D-4 FLUSHING BASINS
33	D-8 DROP INLETS
34	D-9 DROP INLET TOPS
35	D-10 DROP INLET TOPS
36	D-11 DROP INLET GRATES
37	D-13 CATCH BASIN OR MANHOLE
38	D-16 CAST IRON GRATES
39	E-1 BARRICADES, SIGNS AND LIGHTS
40	E-11 INTERSTATE ROUTE MARKERS
41	E-13 STATE ROUTE MARKERS
42	E-14 REGULATORY SIGNS
43	E-15 REGULATORY SIGNS
44	E-16 WARNING SIGNS
45	E-18 GUIDE SIGNS
46	E-19 STANDARD SIGN PLACEMENT
47	E-20 DELINEATORS
48	E-31 FEDERAL AID CONSTRUCTION IDENTIFICATION SIGNS
49	G-3 THREE CABLE GUARD RAIL
50	G-3A DEAD END ANCHORAGE AT BRIDGE APPROACH
51	G-4 PLANK GUARD RAIL
52	J-1 BOUNDARY MARKERS
53-69	BRIDGE 100 SERIES
70	SCB-D1-65 GENERAL NOTES
71	SCB-D6-65 DETAILS A,B,C,D,&E
72-73	SB-R1-64 SHEETS 1 & 2
74-85	V.T. 10-A CROSS-SECTIONS
86-89	MCKENNA ROAD CROSS-SECTIONS
90-91	RIVER ROAD CROSS-SECTIONS
	FOR RIGHT-OF-WAY DETAILS, SEE RIGHT-OF-WAY PLANS
92-95	STREET LIGHTING, ITEM 705 AND TRAFFIC CONDUITS, ITEM 704

BEGINNING AT A POINT 0.028 MILE WEST OF THE NEW HAMPSHIRE-
0.274

LENGTH OF BRIDGE
1352.96 0.256
97.04 FEET = 0.018 MILE
1450.00 0.274

1965	3100
1987	6900
1987	1005
	59%
	5%
	40

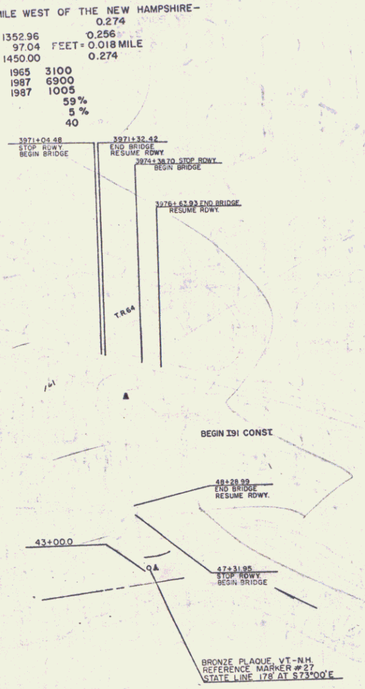

PROJECT NAME & NUMBER	TYPE PAVEMENT	AREA SY.
NORWICH S 0170 (1)	BITUMINOUS CONC.	
	RECORD PLANS	

MATERIALS

SUB-BASE OF GRAVEL
SUB-BASE OF SAND } Farrell Pit, Norwich, Vt.
GRAVEL BACKFILL
CRUSHED GRAVEL - ROCK - Green Quarry, Hartford, Vt.
REFINED TAR
CUTBACK ASPHALT - Humble Oil, Everett, Mass.
SA-GRAV. OR FEASTONE - Vt. Marble Co., Rutland, Vt.
FOR SEAL
CONCRETE CLASS 'AA' & 'B' - Miller Ready-Mix, W. Lebanon, N.H.
BIT. CON. PAVEMENT - L.M. Pike & Sons, W. Lebanon, N.H.
REINFORCING STEEL - Bethlehem Steel Corp., Bethlehem, Pa.
METAL PIPE CULVERT - Northeastern Culvert Corp., Westminster, Vt.
E.C.P. - S.T. Griswold & Co., Williston, Vt.
CAST IRON GRATE - B.L. Libbey Foundry, Brockton, Mass
DROP INLETS } S.T. Griswold
GUARD RAIL ITEMS }
STRUCTURAL STEEL - Vt. Structural Steel Corp., Burlington, Vt.
CAST IRON COVER FOR F.D. Northeastern Culvert Corp.,
JOINT SEALER PREFORMED - Johnson Rubber Co., Middlefield, Ohio
TAR EMULSION - Chemical Corp., Cheshire, Conn.

CONTRACTOR - Perini Corp. Framingham, Mass.	CONTRACT: DATED April 11,
RESIDENT ENGINEER - F.E. Aldrich	STARTED " "
INSPECTORS - S. Johnson, M. Hitchins, F. Gilbert	COMPLETED June 2
RECORD PLANS - P.F. W.J.	ACCEPTED " "

RIGHT-OF-WAY DIVISION
TOWN FILE
PERPETUAL
~~Town of~~ Rt 91
(To Be Returned To R.O.W. Division)

INTERSTATE 91
TO BRADFORD

NOTE: ANY FURTHER INFORMATION CON
FINAL QUANTITIES, AMOUNTS OR OTHER
RELATIVE TO THIS PROJECT MAY BE
EITHER THE FIELD BOOKS OR THE
FILE.

THESE PLANS ARE SUBJECT TO SUCH REVISIONS AS MAY BE REQUIRED BY THE BUREAU OF PUBLIC ROADS OR THE COMMISSIONER OF HIGHWAYS.

CONSTRUCTION TO BE CARRIED ON IN ACCORDANCE WITH THESE PLANS AND THE STANDARD SPECIFICATIONS FOR HIGHWAY AND BRIDGE CONSTRUCTION, DATED APRIL, 1964, AS APPROVED BY THE BUREAU OF PUBLIC ROADS ON OCT. 12, 1964, INCLUDING ALL SUBSEQUENT APPROVED REVISIONS AND SUCH REVISED SPECIFICATIONS AND SPECIAL PROVISIONS AS ARE INCORPORATED IN THESE PLANS.

ASST. CHIEF ENGINEER

IN 91

PROJECT NORWICH
NUMBER S 0170(1)
LENGTH 0.274 MI.
TYPE BITUMINOUS CONCRETE PAVEMENT
CONSTRUCTION PLANNING CONSTRUCTION
FRANKLINHAM, MASS.
1968 11 19
LOCATION Beginning at a point 0.028 mi. west of the N.H.-Vt. State Line and extending westerly 0.274 mile

FA

2