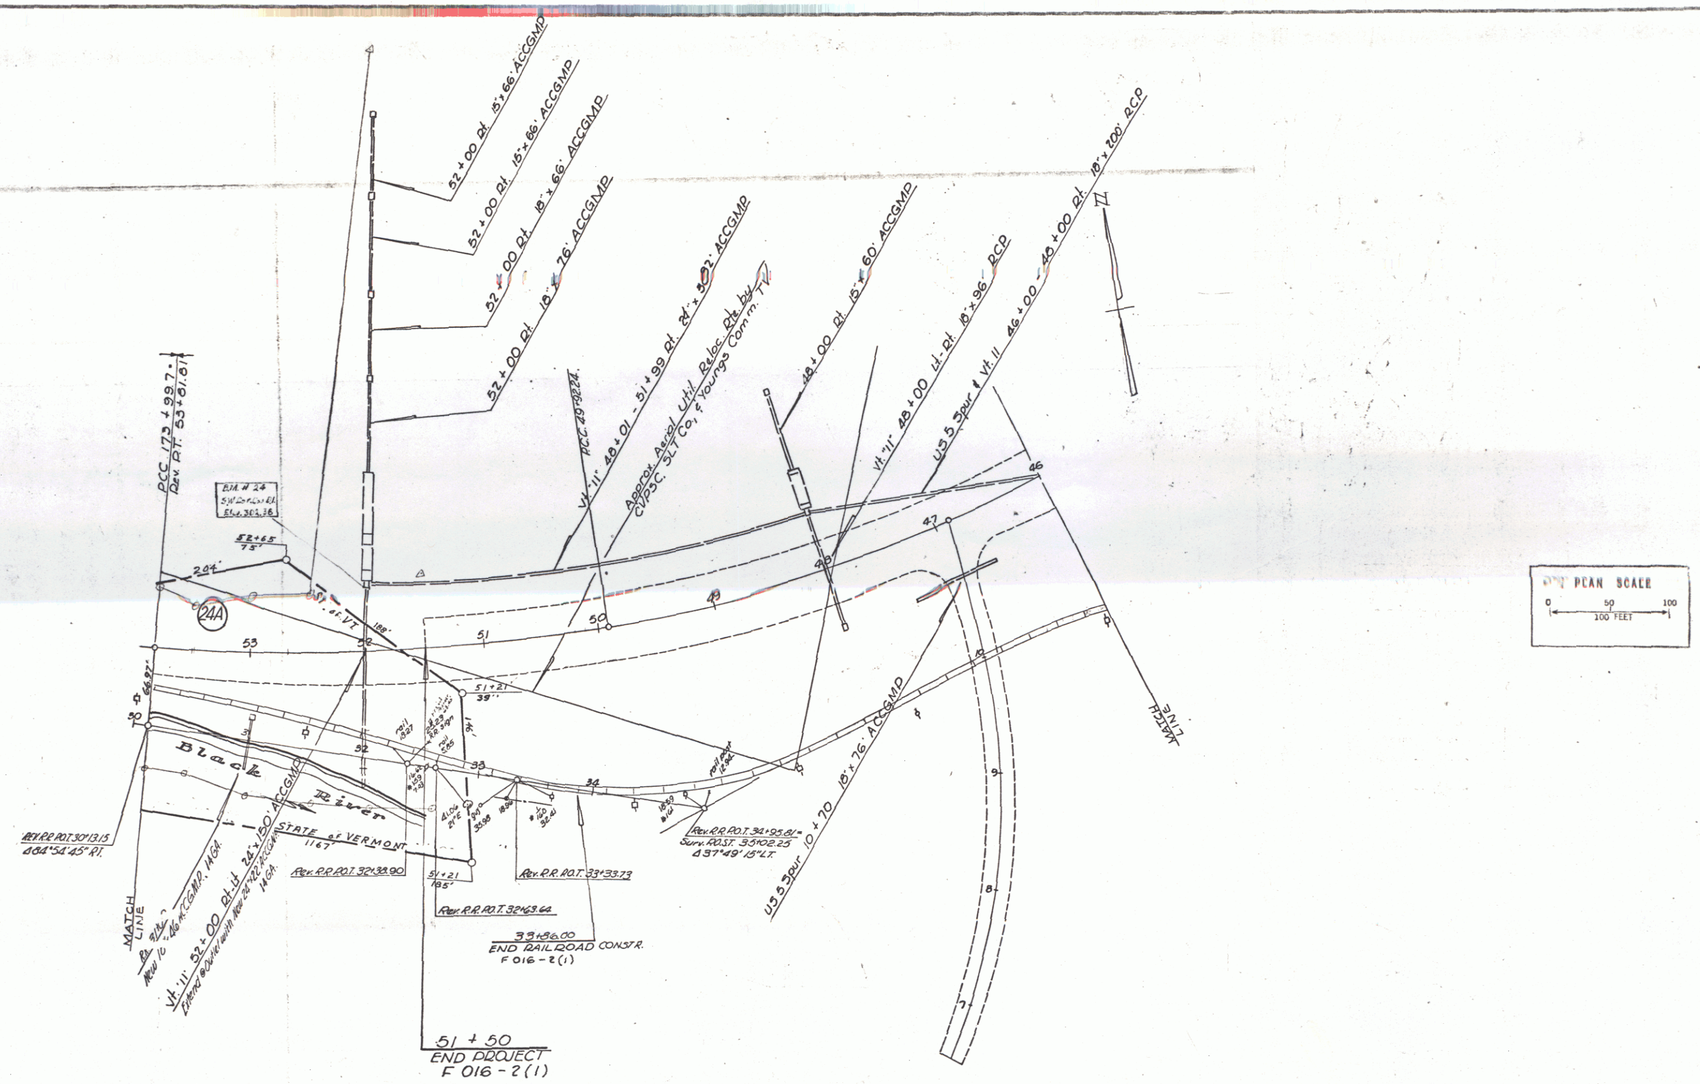


| PLAN | |
|---|---|
| Submitted | DATE |
| Checked | 2-2-66 |
| Plotted | 2-2-66 |
| Traced | 2-2-66 |

| BY | |
|---|---|
| Designer | |
| Engr. | |
| W.H. | |

SPRINGFIELD
F 016-2(1)

Sheet 21 of 195

16