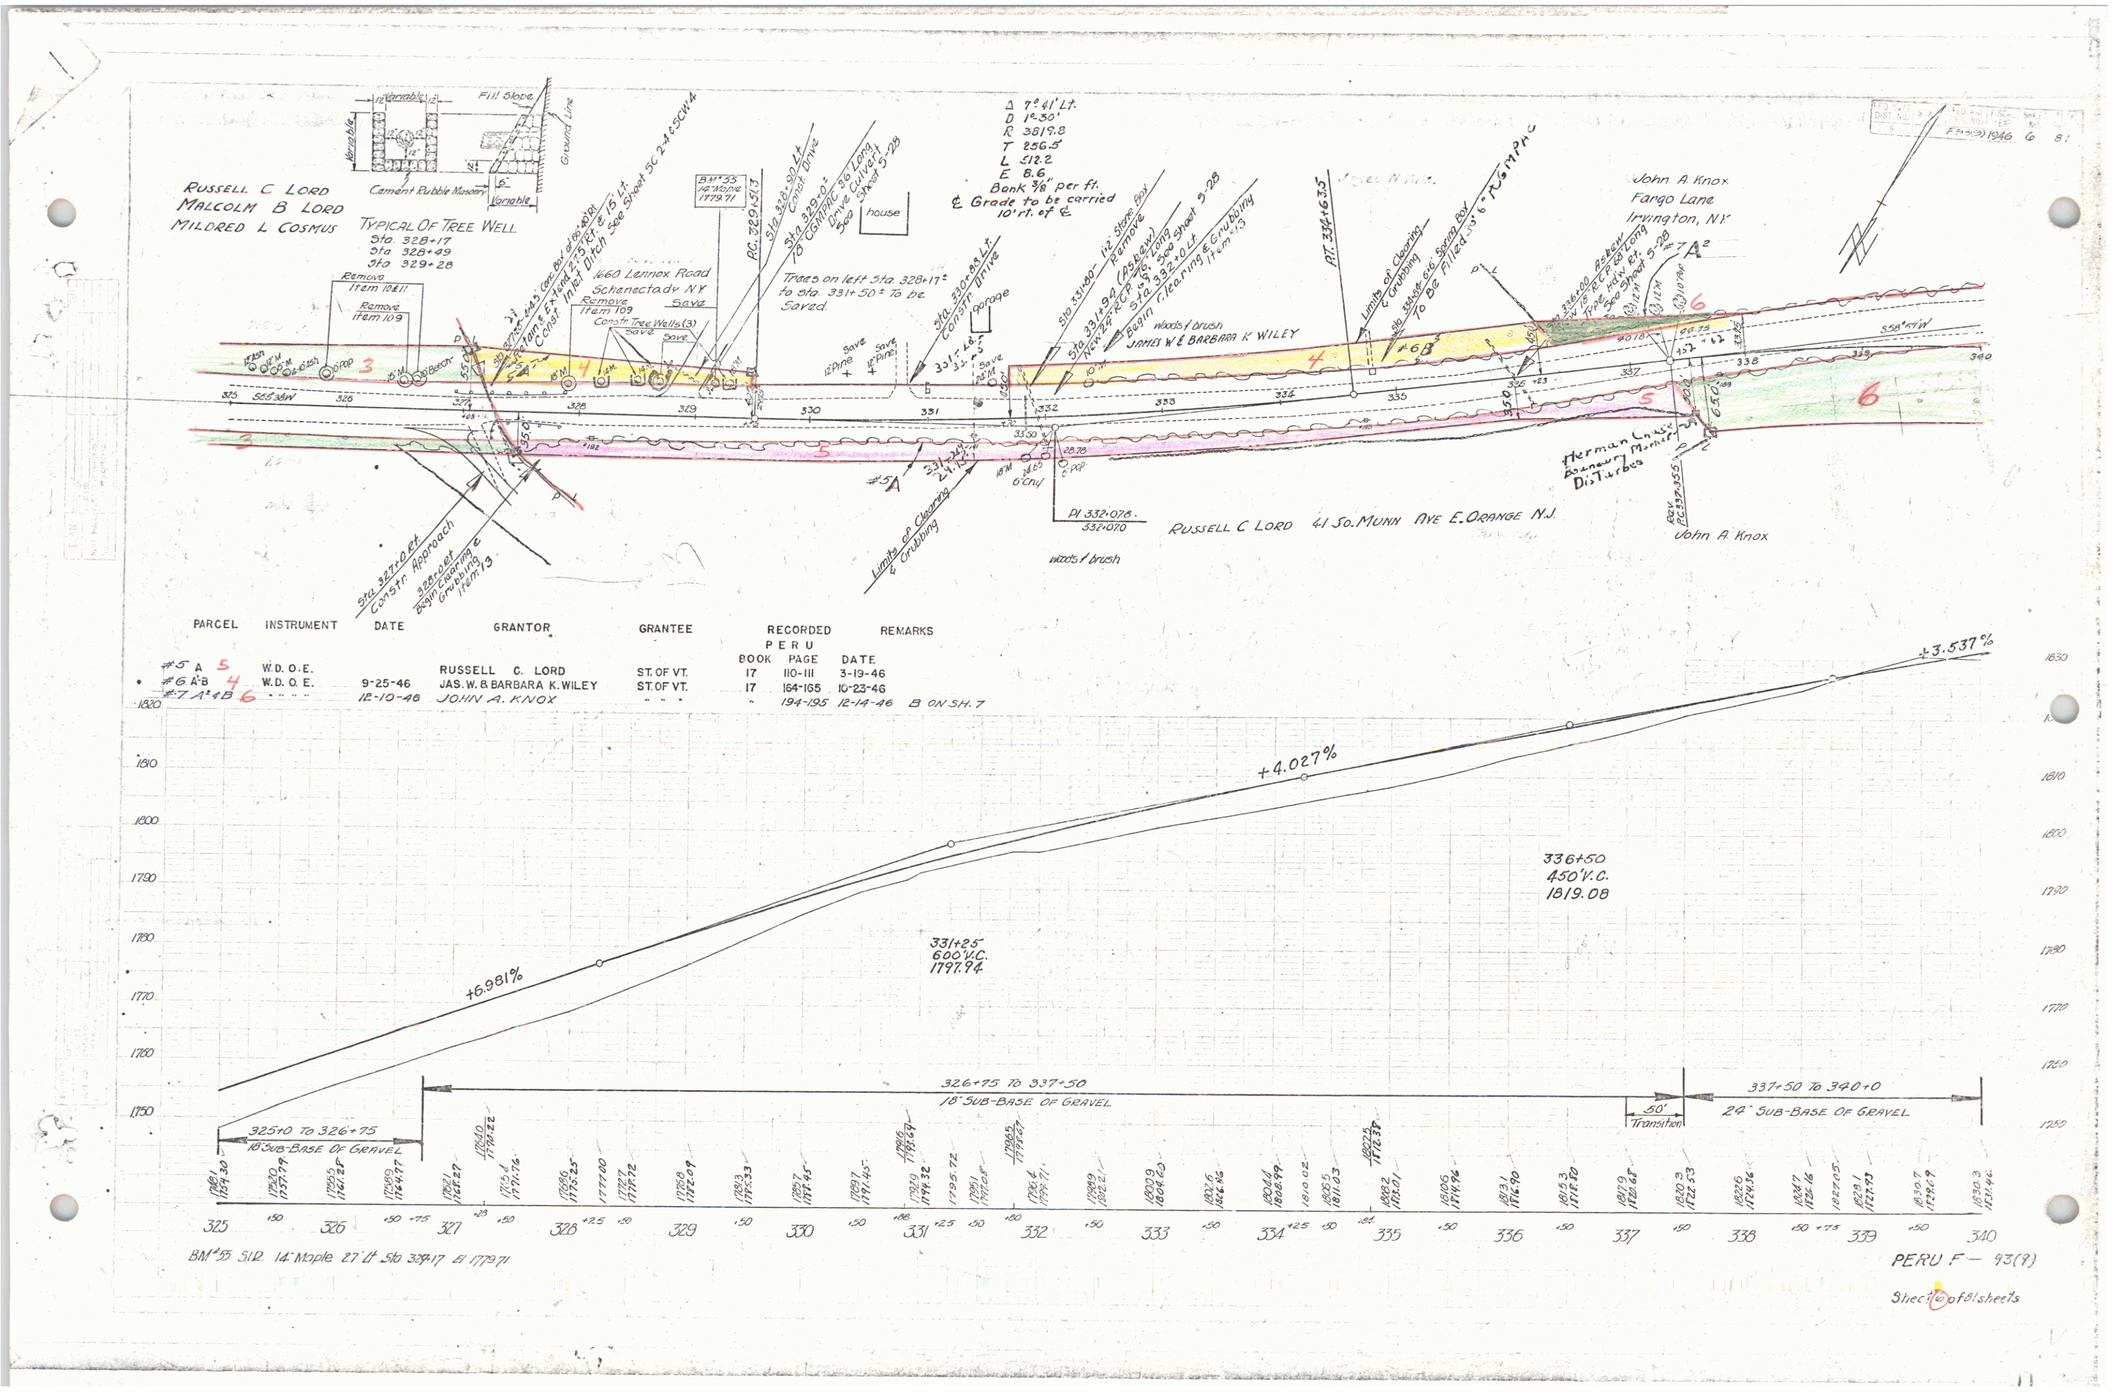


| PARCEL | INSTRUMENT | DATE | GRANTOR | GRANTEE | RECORDED PERU BOOK | PAGE | DATE | REMARKS |
|---|---|---|---|---|---|---|---|---|
| #5 A 5 | W.D.O.E. | | RUSSELL C. LORD | ST. OF VT. | 17 | 110-111 | 3-19-46 | |
| #6 A-B 4 | W.D.O.E. | 9-25-46 | JAS. W. & BARBARA K. WILEY | ST. OF VT. | 17 | 164-165 | 10-23-46 | |
| #7 A² & B 6 | " " " | 12-10-46 | JOHN A. KNOX | " " " | " | 194-195 | 12-14-46 | B ON SH. 7 |