FED. ROAD DIST. NO.	STATE	FED. AID PROJ. NO.	YEAR	SHEET NO.	TOTAL SHEETS
5	VT.	F 93(9)	1946	7	81

NOTE: Care shall be taken by the Contractor that the trees outside of top of cut slope from sta. 347+0 to sta. 350+0 on the left shall not be damaged.

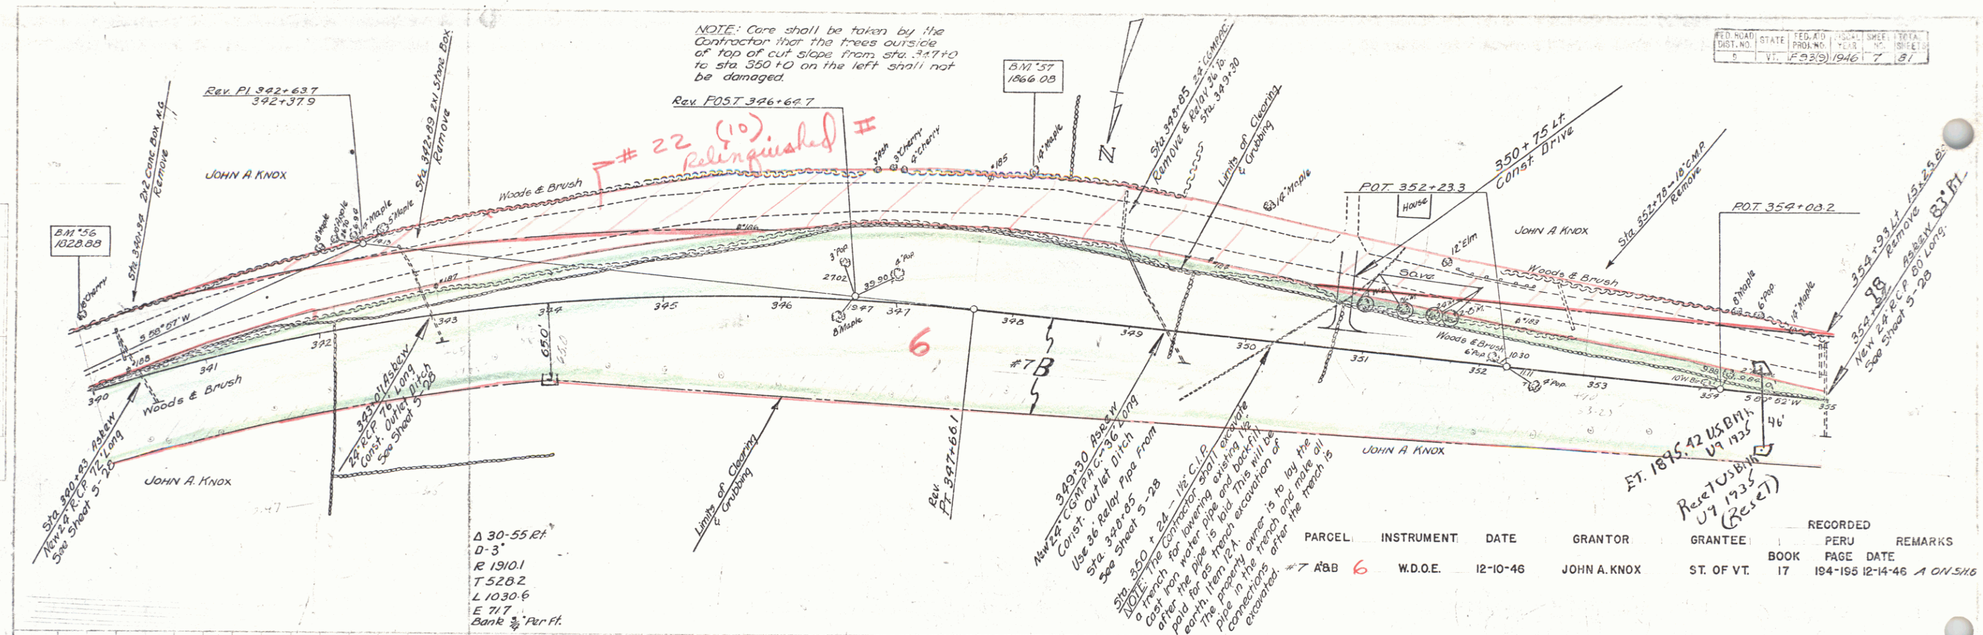

PARCEL	INSTRUMENT	DATE	GRANTOR	GRANTEE	RECORDED BOOK	RECORDED PAGE	RECORDED DATE	REMARKS
#7 A&B 6	W.D.O.E.	12-10-46	JOHN A. KNOX	ST. OF VT.	PERU 17	194-195	12-14-46	A ON 5/16

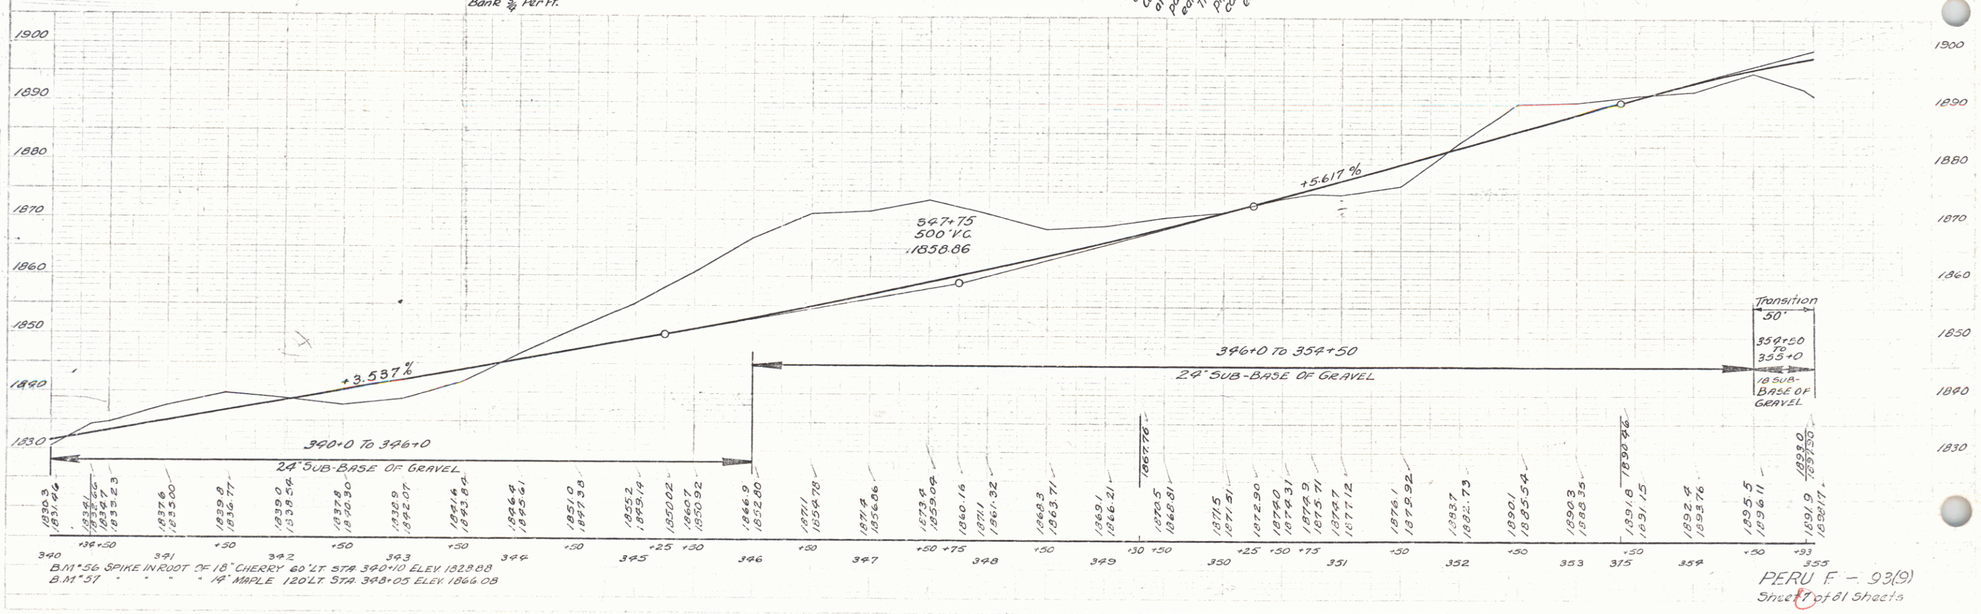

PERU F-93(9)
Sheet 7 of 81 Sheets