


PARCEL INSTRUMENT DATE	GRANTOR	GRANTEE	RECORDED	REMARKS

432+50-445+00 Clearing & Grubbing Item No. 13

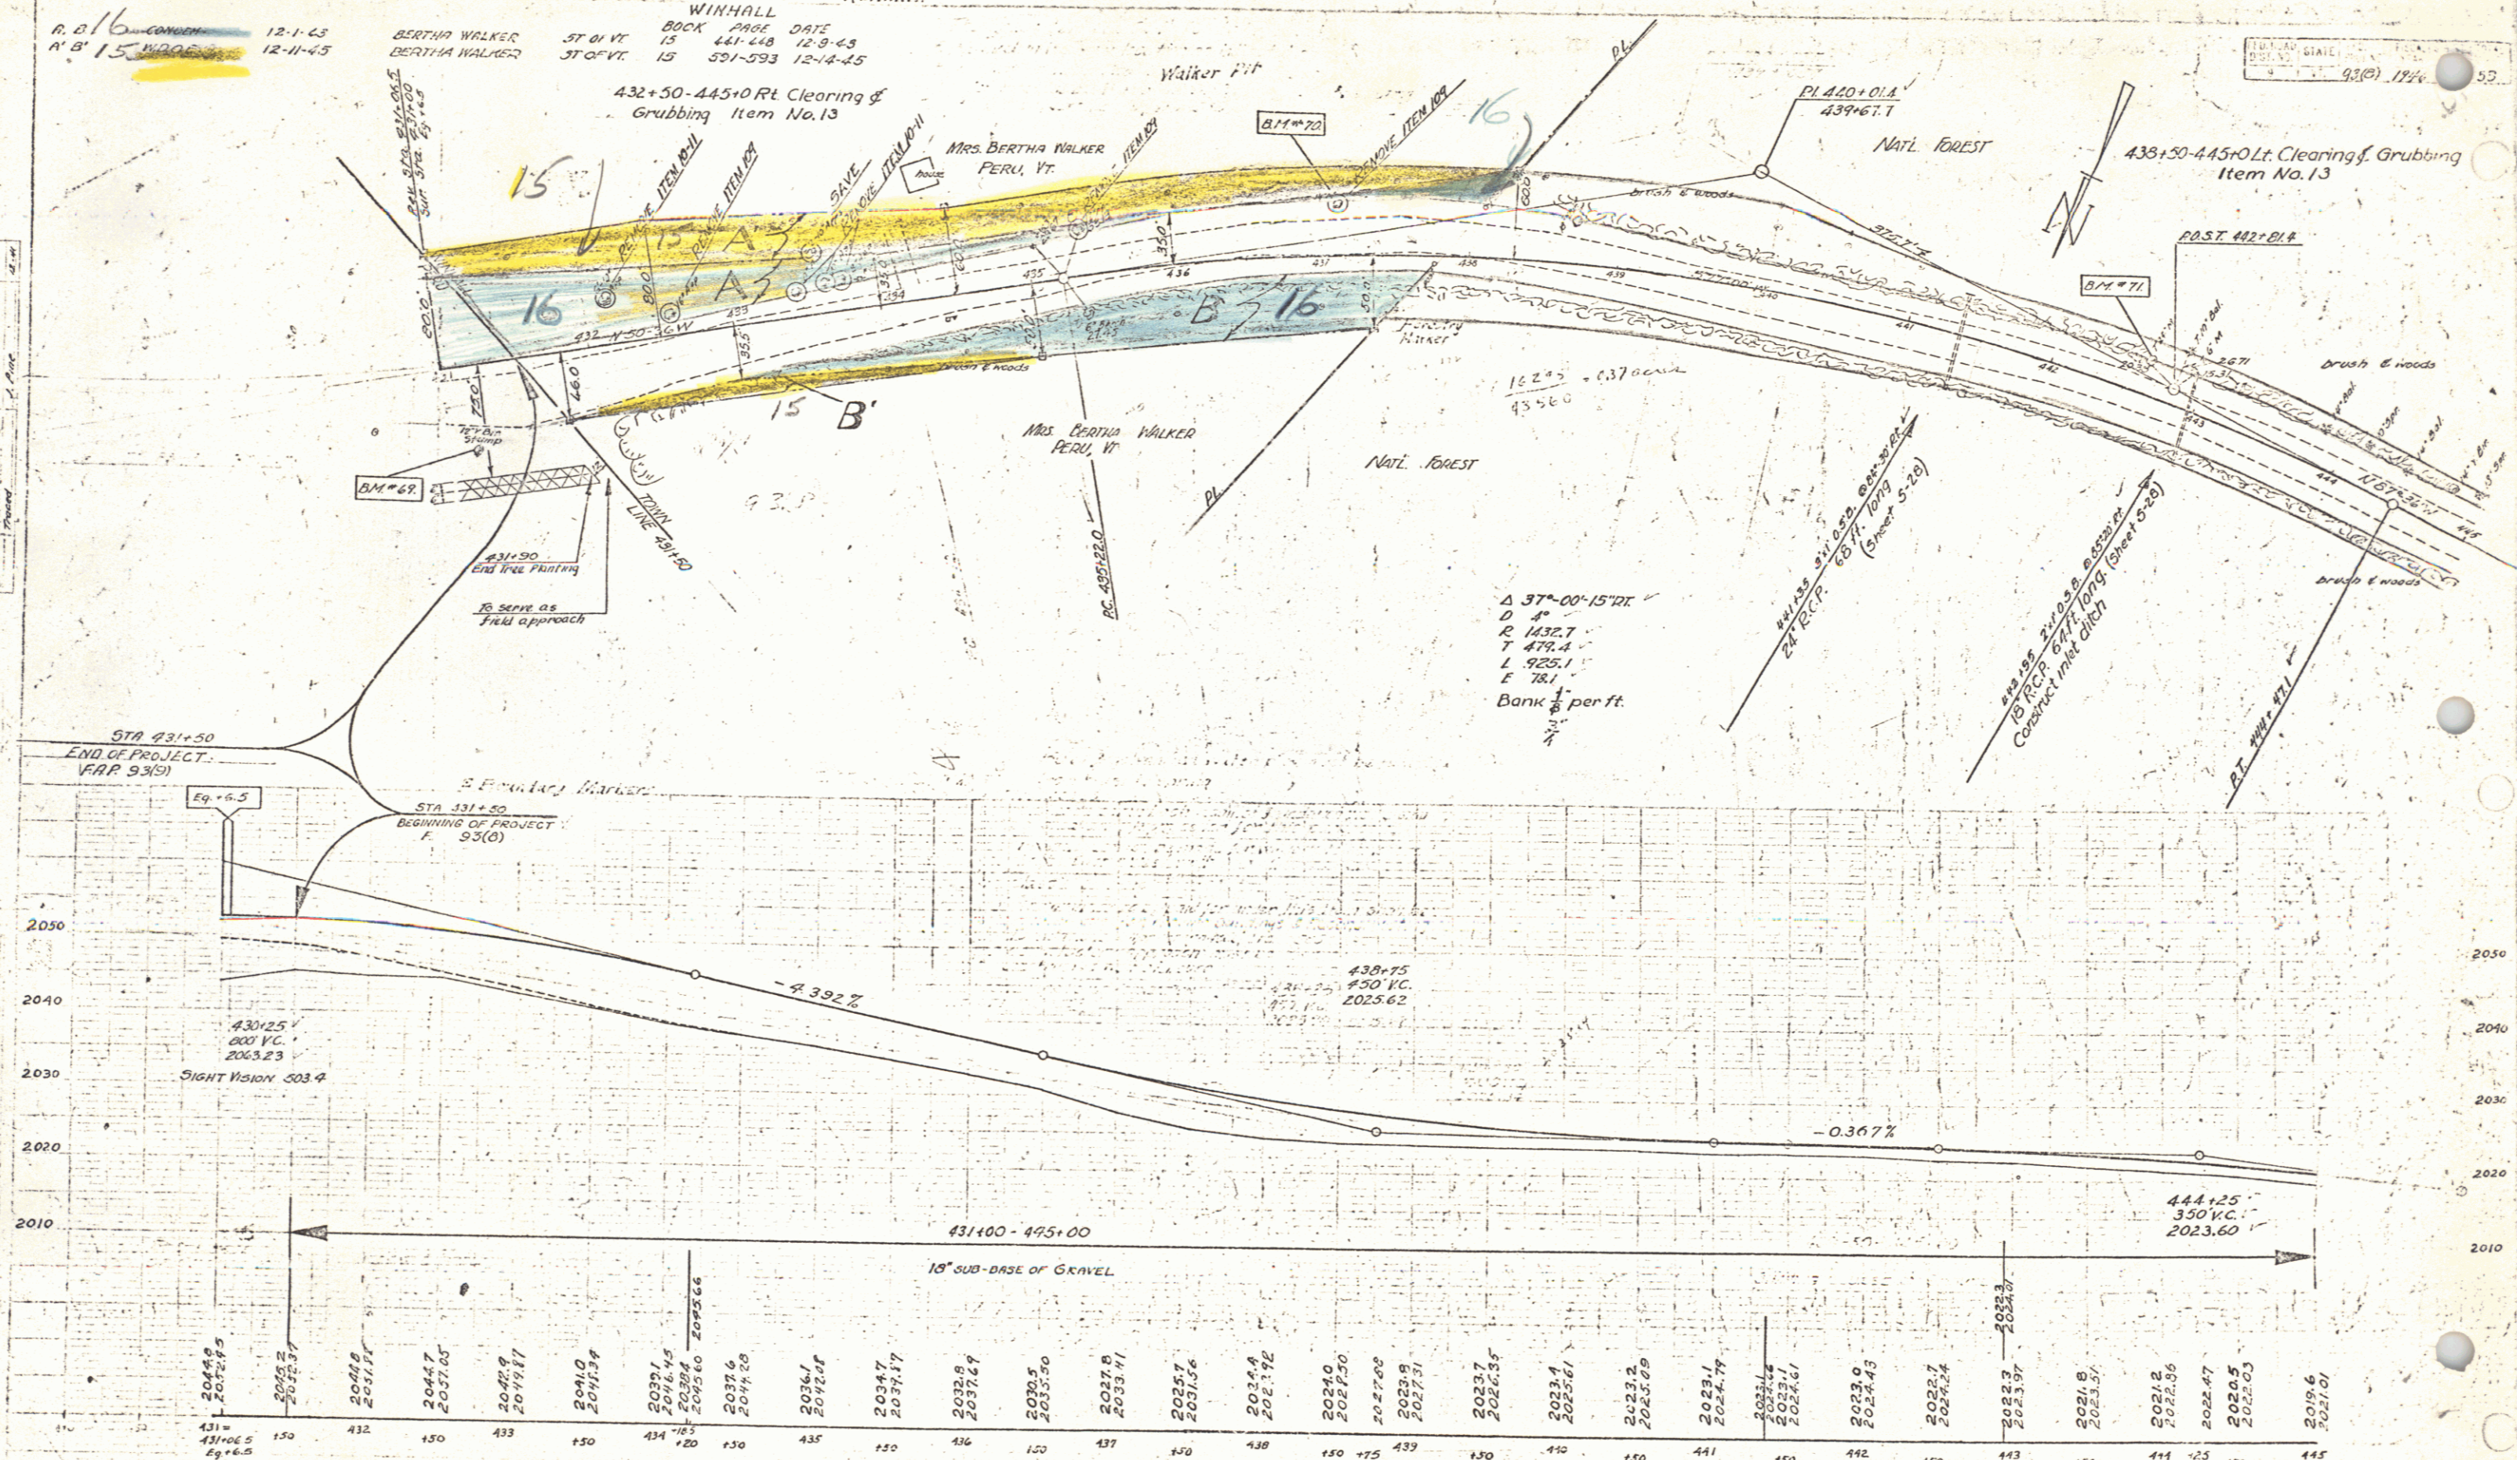


B.M. #69 S.I. Frank 12" Birch 29' RT Sta. 431+14 Elev. 2050.81  
 B.M. #70 S.I.R. 14" Maple 22' LT Sta. 437+14 Elev. 2023.19  
 B.M. #71 S.I.P. 24" Maple 108' LT Sta. 442+14 Elev. 2023.39  
 B.M. #72 1153.55

Winhall F. 93-3  
 MAP 93(3)  
 Sheet 5 of 53