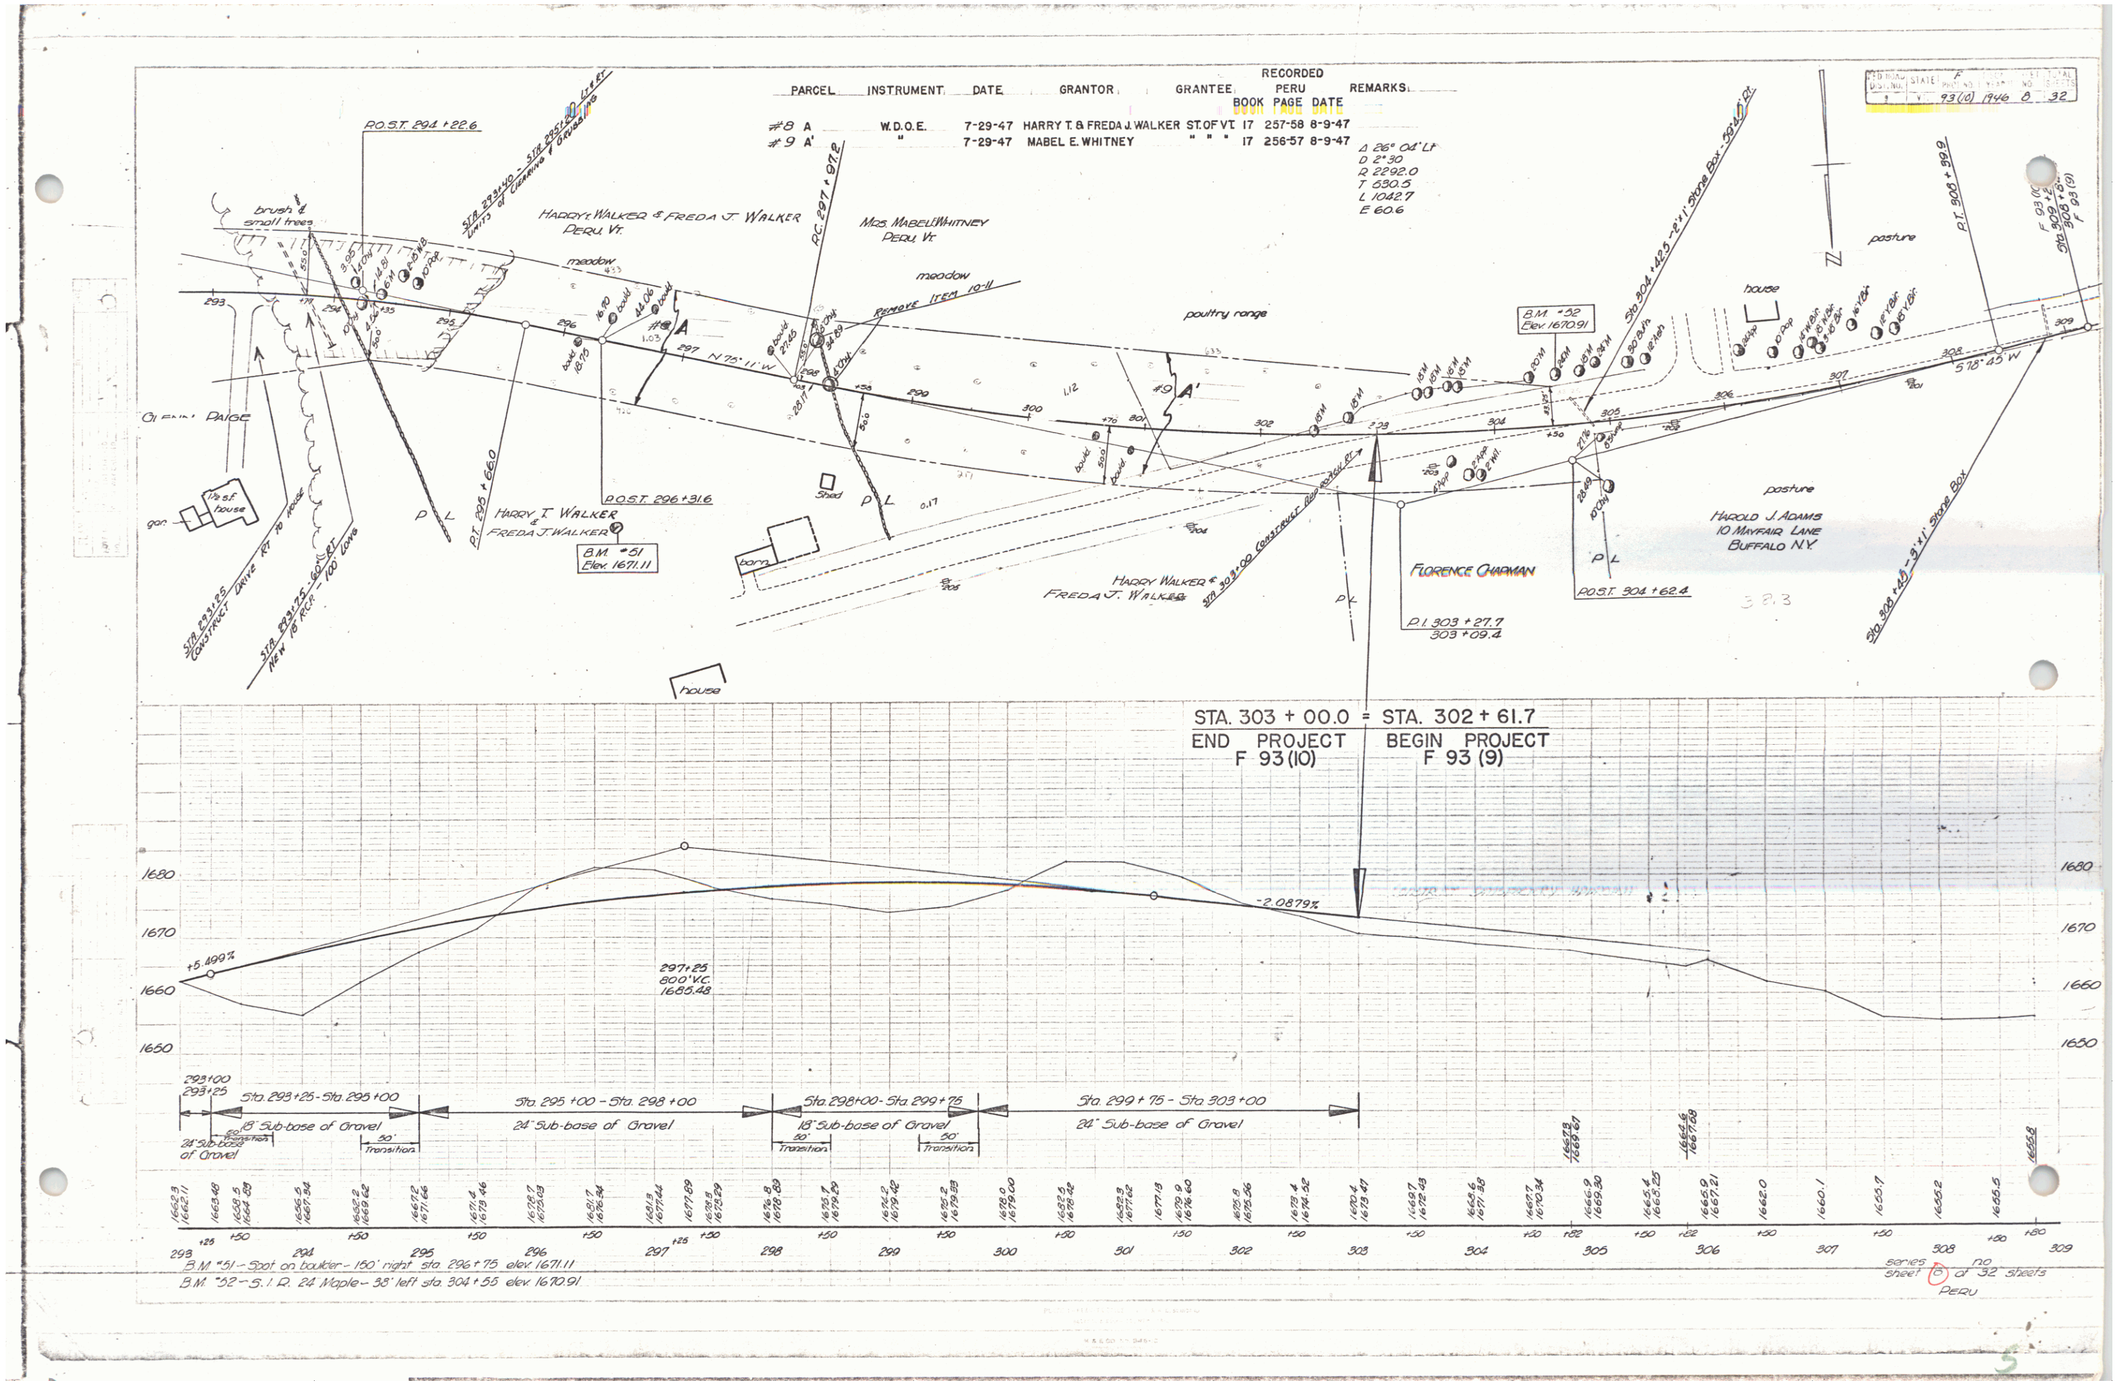

PARCEL INSTRUMENT DATE GRANTOR GRANTEE RECORDED PERU BOOK PAGE DATE REMARKS
#8 A W.D.O.E. 7-29-47 HARRY T. & FREDA J. WALKER ST. OF VT 17 257-58 8-9-47
#9 A' " 7-29-47 MABEL E. WHITNEY " " " 17 256-57 8-9-47
Δ 26° 04' Lt
D 2°30
R 2292.0
T 530.5
L 1042.7
E 60.6
STATE F PROJ. NO. 93(10) 1946 8 32
P.O.S.T. 294+22.6
HARRY T. WALKER & FREDA J. WALKER PERU, VT.
MRS. MABEL E. WHITNEY PERU, VT.
meadow
poultry range
house
pasture
GLENN PAIGE
HARRY T. WALKER & FREDA J. WALKER
B.M. #51 Elev. 1671.11
P.O.S.T. 296+31.6
P.T. 295+66.0
P.T. 308+39.9
B.M. #52 Elev. 1670.91
HARRY WALKER & FREDA J. WALKER
FLORENCE CHAPMAN
P.I. 303+27.7 303+09.4
P.O.S.T. 304+62.4
HAROLD J. ADAMS 10 MAYFAIR LANE BUFFALO N.Y.
STA. 303 + 00.0 = STA. 302 + 61.7
END PROJECT F 93(10)
BEGIN PROJECT F 93(9)
+5.499%
-2.0879%
297+25 800' V.C. 1685.48
Sta. 293+25 - Sta. 295+00
18" Sub-base of Gravel
24" Sub-base of Gravel
Sta. 295+00 - Sta. 298+00
24" Sub-base of Gravel
Sta. 298+00 - Sta. 299+75
18" Sub-base of Gravel
Sta. 299+75 - Sta. 303+00
24" Sub-base of Gravel
B.M. #51 - Spot on boulder - 150' right sta. 296+75 elev. 1671.11
B.M. #52 - S.I.R. 24 Maple - 38' left sta. 304+55 elev. 1670.91
series no sheet 8 of 32 sheets
PERU