PARCEL	INSTRUMENT	DATE	GRANTOR	GRANTEE	RECORDED LANDGROVE BOOK	PAGE	DATE	REMARKS
#6 A, [redacted]	W.D.O.E.	9-3-47	CHARLES H. & LILLIAN B. GRANT	ST. OF VT.	G	430-431	9-11-47	[redacted]

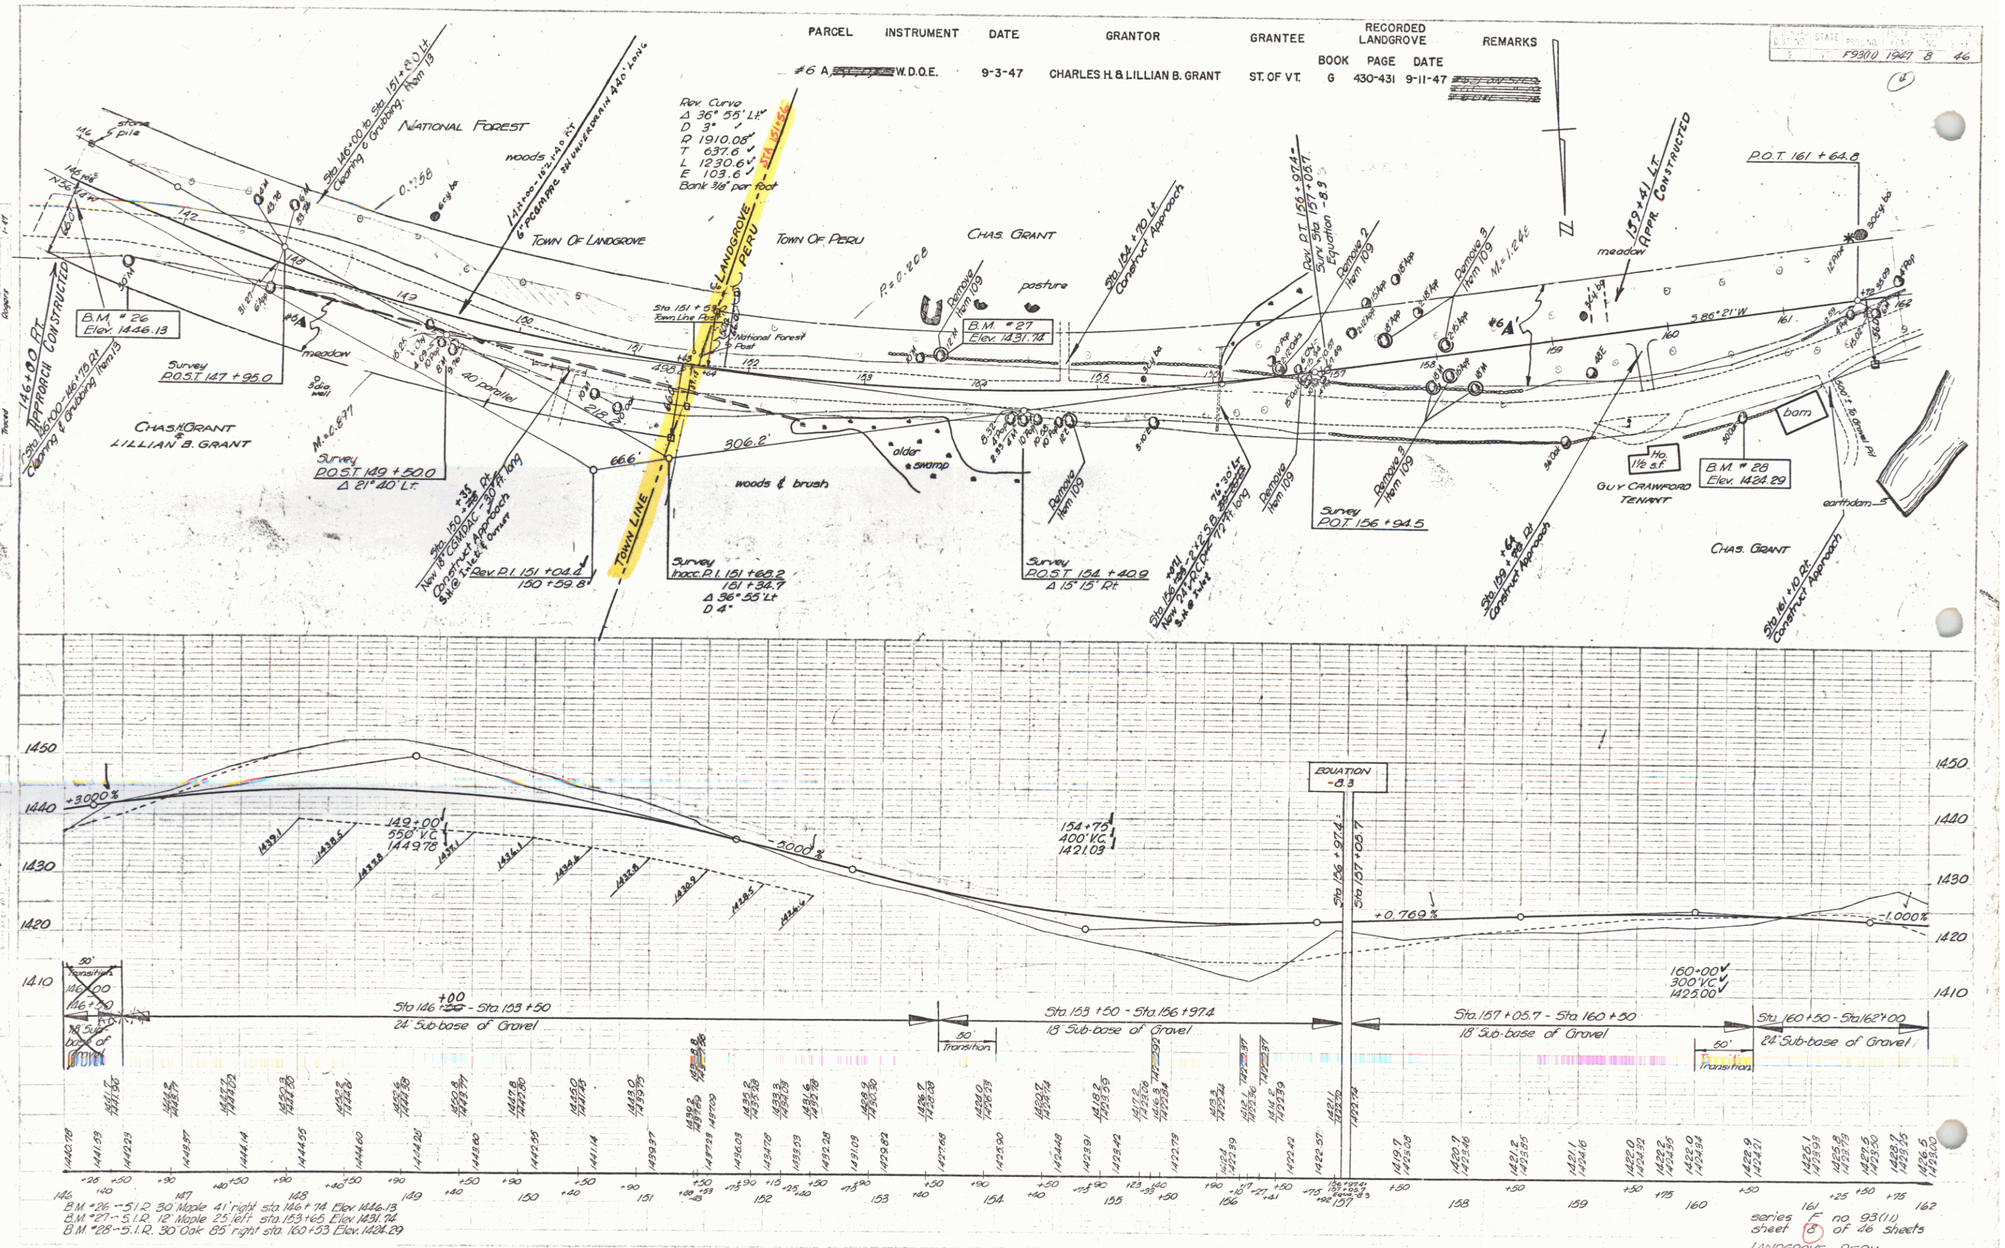

series F no. 93(11)
sheet 8 of 46 sheets

LANDGROVE - PERU