


PLAN  
 11-46  
 1-47  
 1-47

Profile  
 1-47  
 1-47

PARCEL	INSTRUMENT	DATE	GRANTOR	GRANTEE	RECORDED BOOK	PERU PAGE	DATE	REMARKS
#7 A	W.D.O.E.	9-4-47	GEORGE B. MOFFITT	ST. OF VT.	17	279-280	9-12-47	
#3 A	ADMIN. DEED	4-7-48	G. B. DAVIS, EST.		17	360-361	4-12-48	#6 B ON 34 B

STATE OF VERMONT  
 F 9300 1947 9 46

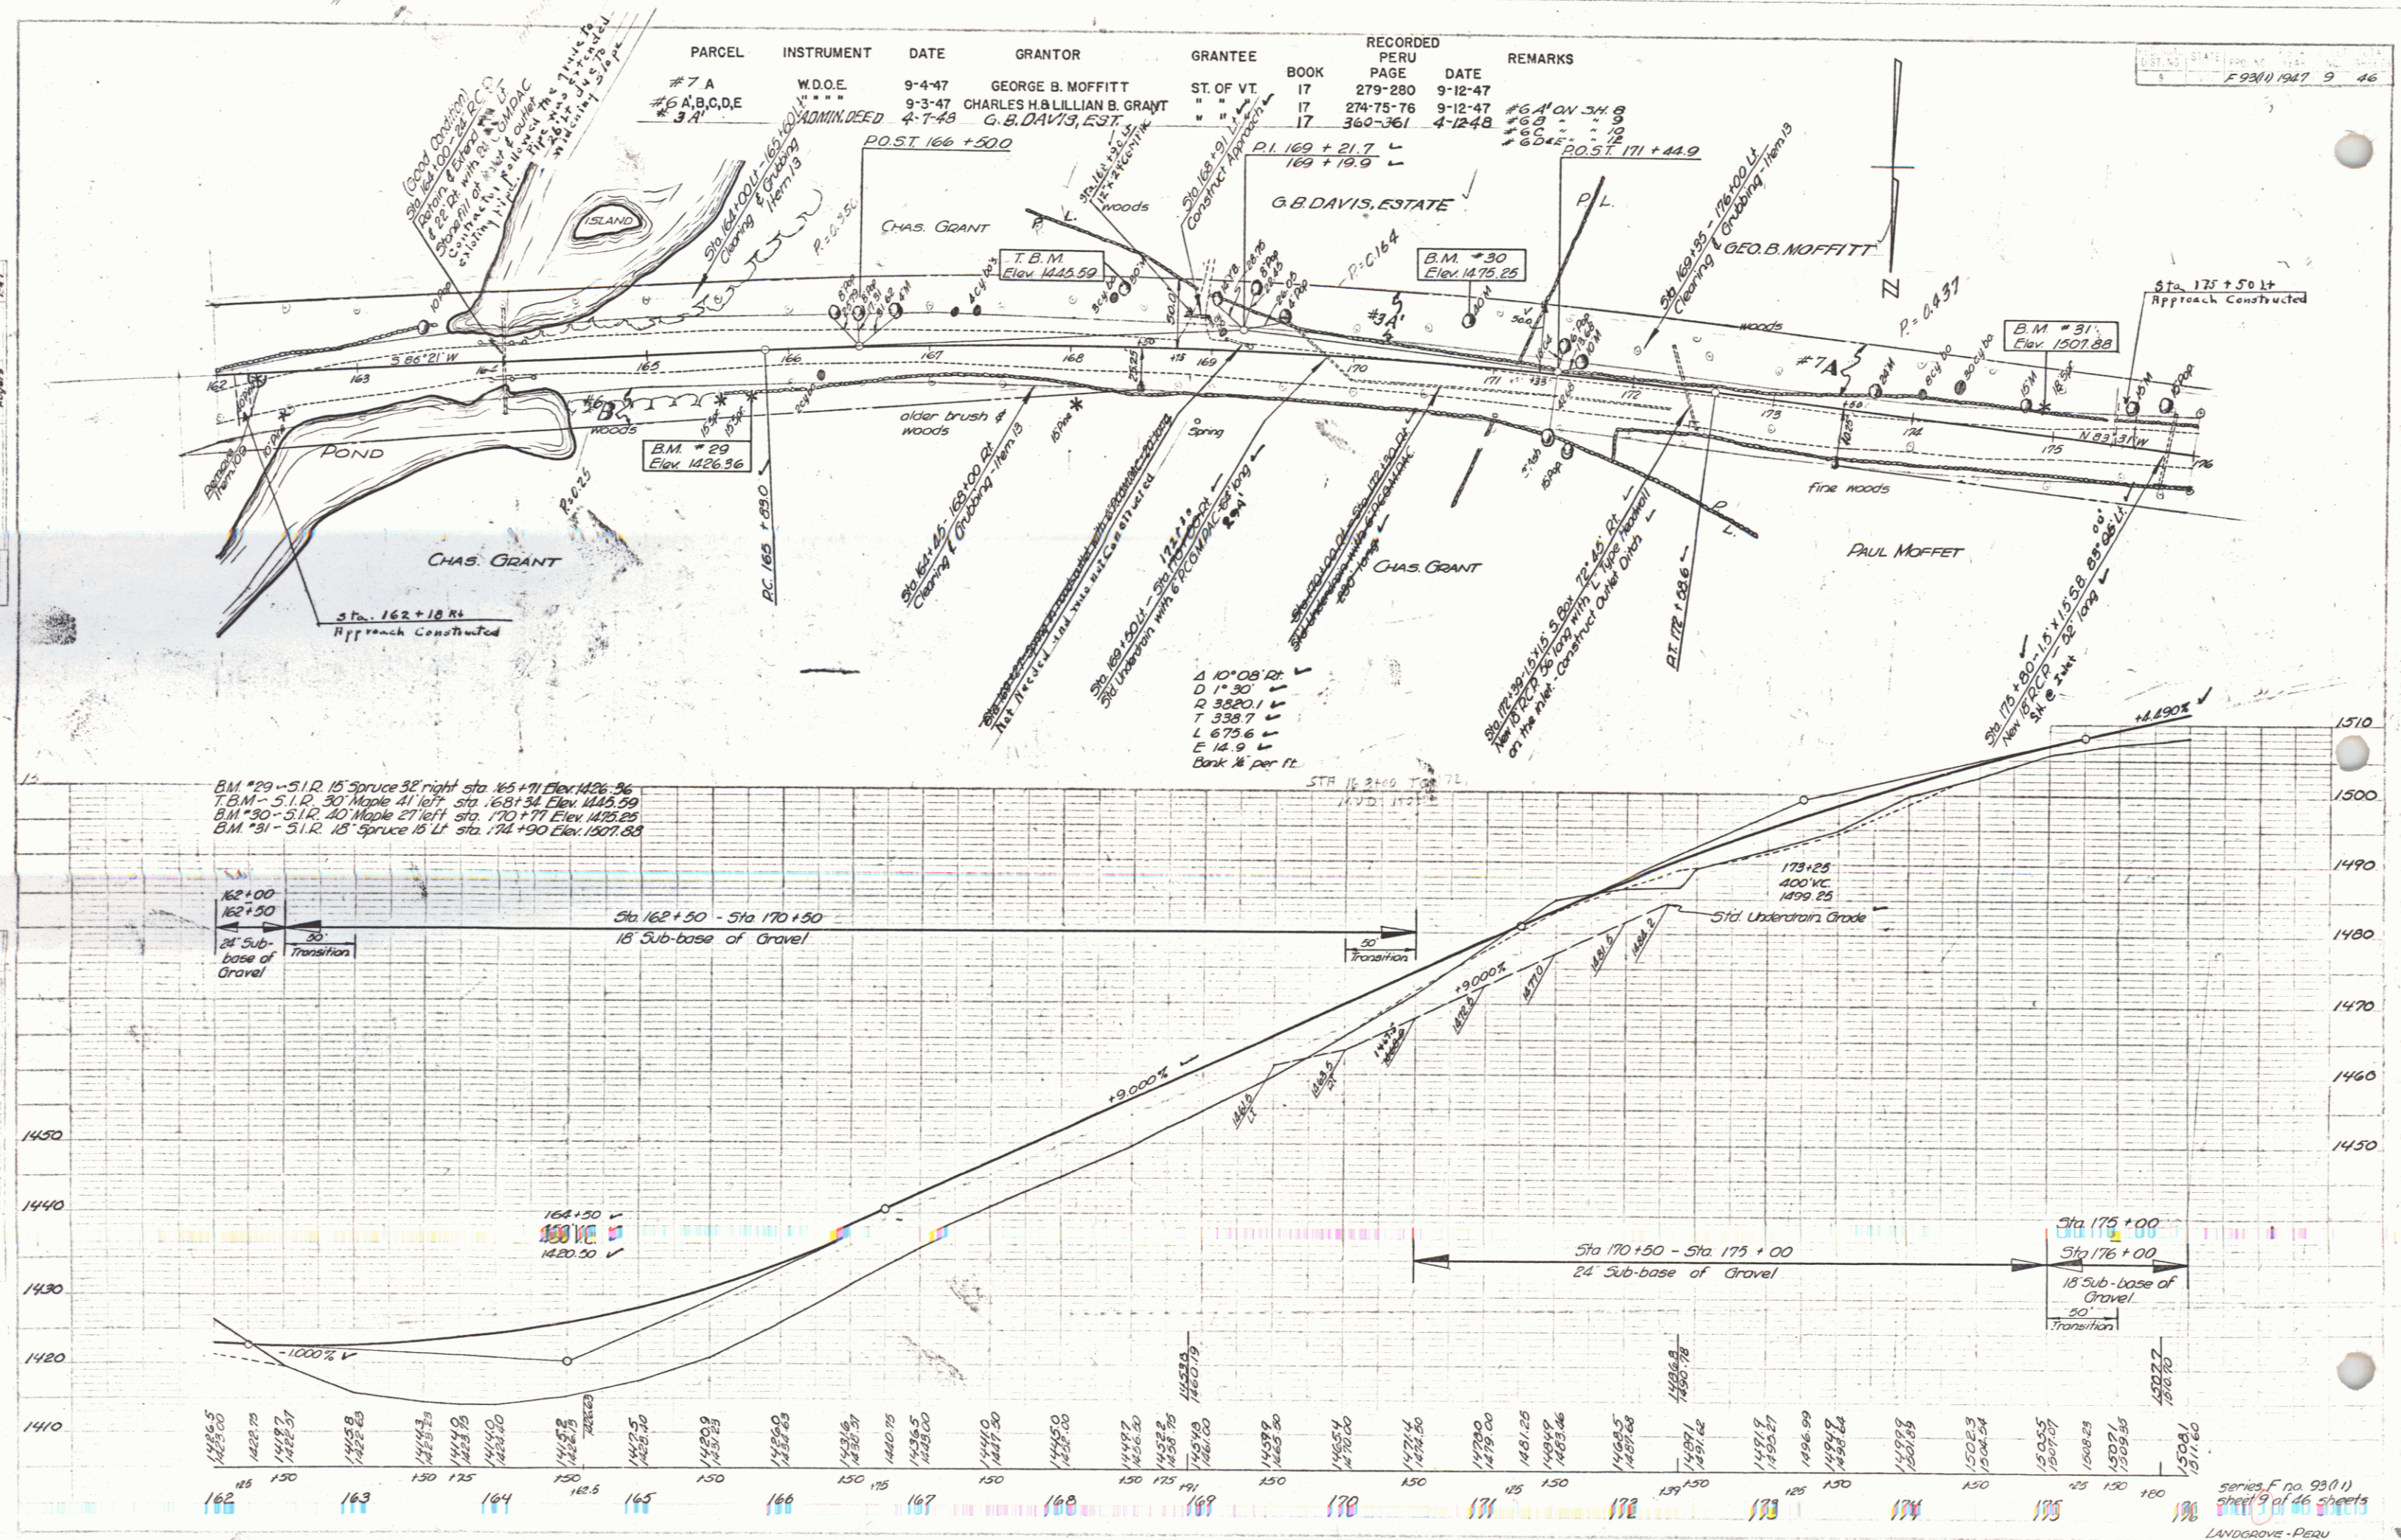

Series F no 93(1)  
 sheet 9 of 46 sheets  
 LANDROVE - PERU