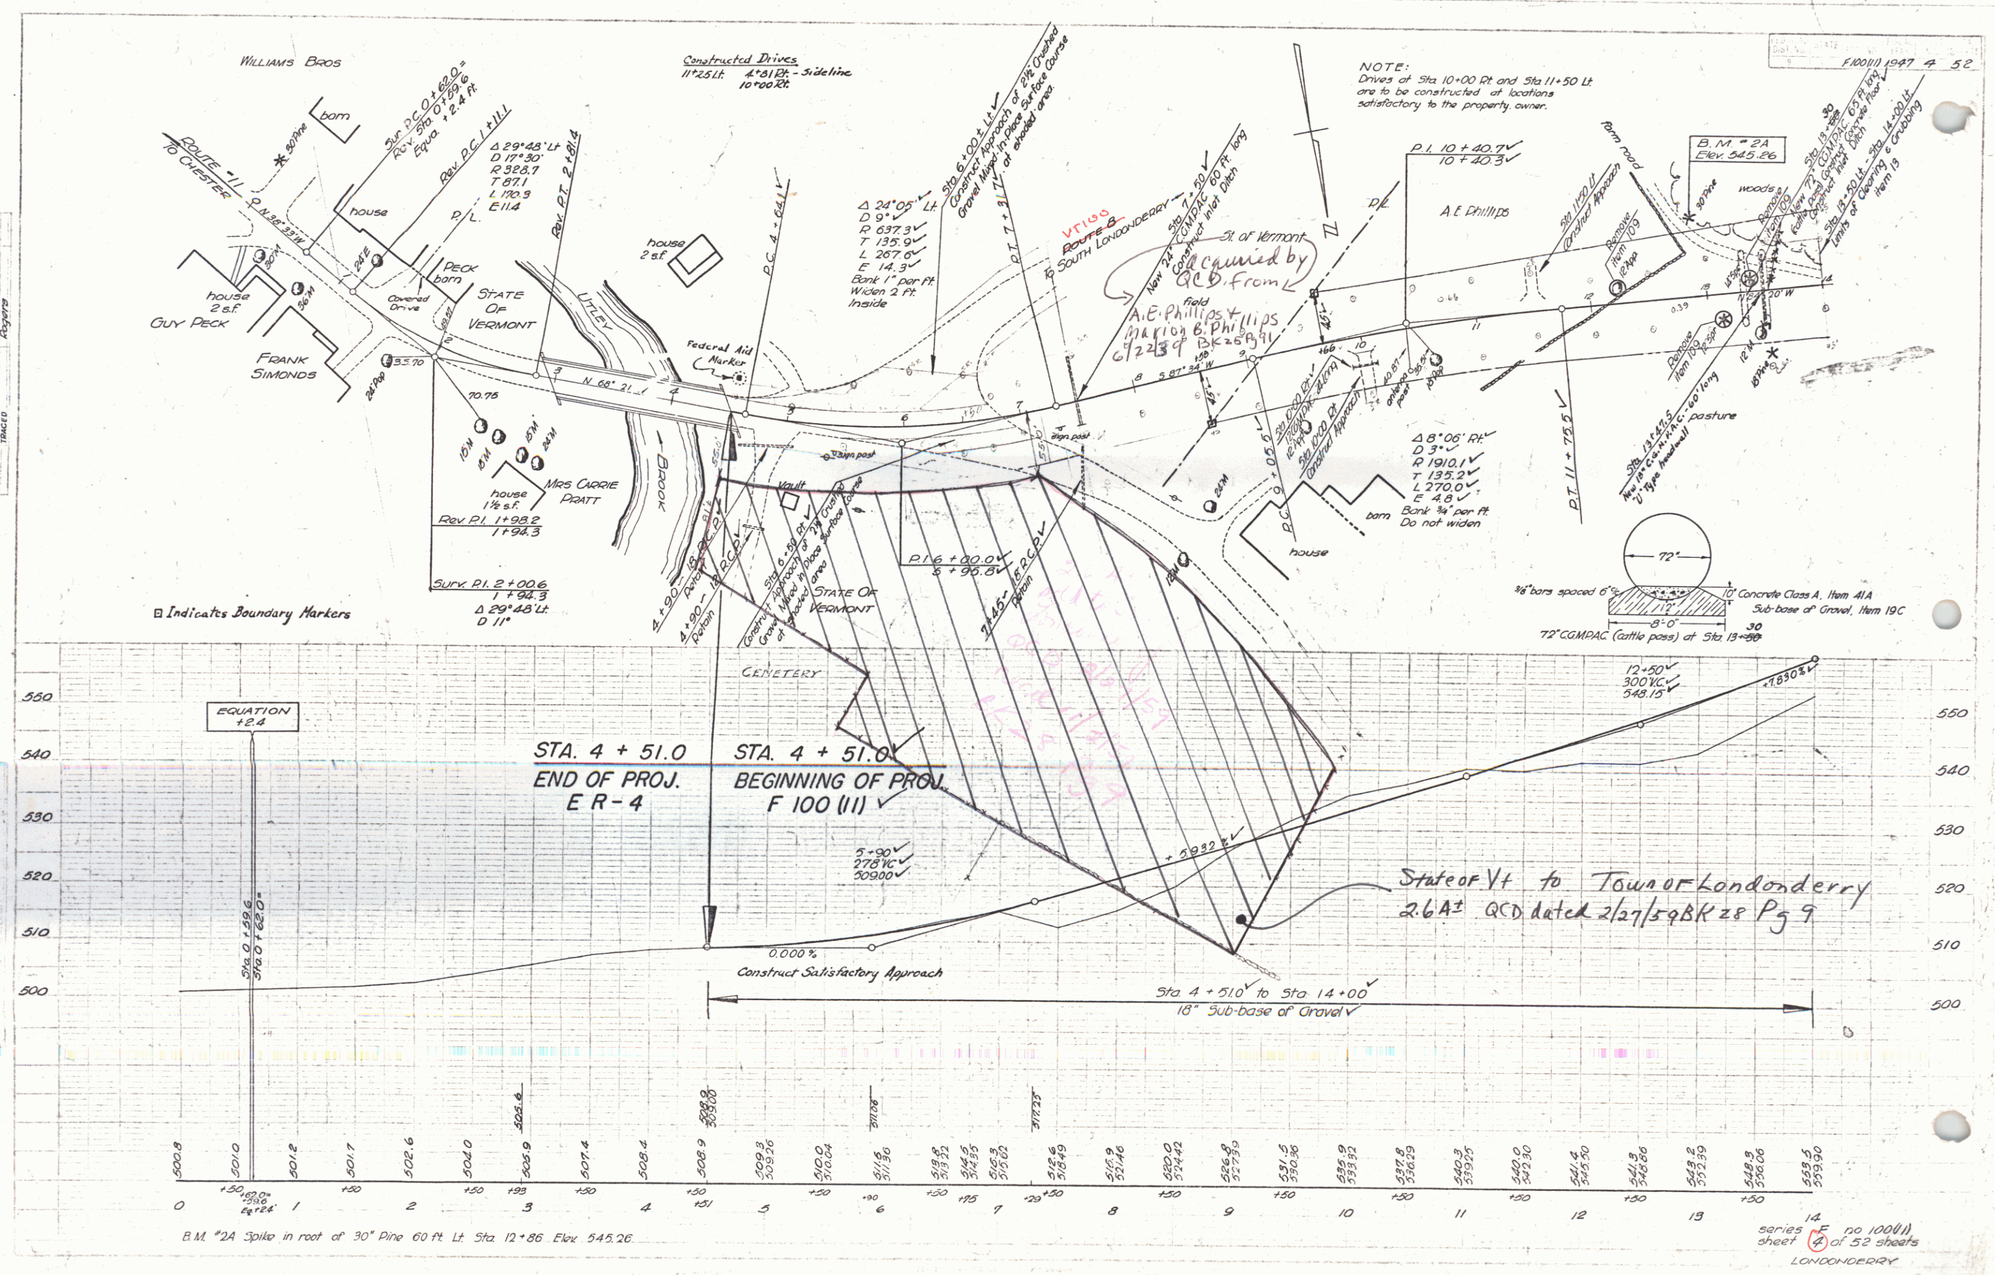
WILLIAMS BROS
Constructed Drives
11+25 Lt. 4+81 Rt. - Sideline
10+00 Rt.
NOTE:
Drives at Sta. 10+00 Rt. and Sta. 11+50 Lt. are to be constructed at locations satisfactory to the property owner.
F100(11) 1947 4 52
B.M. #2A
Elev. 545.26
ROUTE 11 TO CHESTER
barn
house
DECK barn
Covered Drive
STATE OF VERMONT
house 2 s.f.
GUY PECK
FRANK SIMONDS
house 2 s.f.
LITTLEY BROOK
Federal Aid Marker
MRS CARRIE PRATT
house 1½ s.f.
Rev. P.I. 1+98.2
1+94.3
Surv. P.I. 2+00.6
1+94.3
Δ 29°48' Lt.
D 11°
Rev. P.T. 2+81.4
Rev. P.C. 1+11
Δ 29°48' Lt.
D 17°30'
R 328.7
T 87.1
L 170.9
E 11.4
Sur. P.C. 0+62.0 = Rev. Sta. 0+79.6
Equa. +2.4 ft.
Δ 24°05' Lt.
D 9°
R 637.3
T 135.9
L 267.6
E 14.3
Bank 1" per ft. Widen 2 ft. Inside
Sta. 6+00± Lt. Construct Approach of 2½" Crushed Gravel Mixed in Place Surface Course at shaded area
Vault
Sign post
P.I. 6+00.0
5+90.8
STATE OF VERMONT
CEMETERY
Indicates Boundary Markers
VT 100
Route 8
To South Londonderry
St. of Vermont
Now 24' CGMPAC 60 ft. long
Construct Inlet Ditch
Acquired by QCD from
A.E. Phillips + Marion B. Phillips
6/22/59 BK 26 Pg 11
field
P.I. 10+40.7
10+40.3
A.E. Phillips
farm road
woods
Sta. 11+20 Lt. Construct Approach
Remove Item 10.5 12 Hp
Sta. 13+47.5 Rt. Construct Approach 50+00 Rt. 16 Hp
Δ 8°06' Rt.
D 3°
R 1910.1
T 135.2
L 270.0
E 4.8
Bank ¾" per ft. Do not widen
barn
house
P.C. 4+64.1
P.T. 7+37.1
P.T. 11+75.5
Sta. 13+47.5 Rt. Now 16' C.G.M.P.A.C. 60' long 10' Type headwall
pasture
Sta. 13+50 Lt. Now 72" CGMPAC 65 ft. long Construct Inlet Ditch
Sta. 14+00 Lt. Limits of Clearing & Grubbing Item 13
72"
3/8" bars spaced 6" c.c.
10" Concrete Class A, Item 41A
Sub-base of Gravel, Item 19C
8'-0"
72" CGMPAC (cattle pass) at Sta. 13+50
EQUATION +2.4
STA. 4+51.0
END OF PROJ.
E R-4
STA. 4+51.0
BEGINNING OF PROJ.
F 100 (11)
5+90
278 VC
309.00
12+50
300 VC
548.15
+7.850%
+5.932%
0.000%
Construct Satisfactory Approach
State of Vt to Town of Londonderry
2.6 Ac± QCD dated 2/27/59 BK 28 Pg 9
Sta. 4+51.0 to Sta. 14+00
18" Sub-base of Gravel
550
540
530
520
510
500
500.8
501.0
501.2
501.7
502.6
504.0
505.9
507.4
508.4
508.9
509.8
509.26
510.0
510.04
511.6
511.96
513.8
513.32
514.5
514.35
516.3
515.02
518.6
518.49
519.9
519.46
520.0
519.42
526.8
527.39
531.5
530.36
535.9
533.32
537.8
536.29
540.3
539.25
540.0
540.30
541.6
541.50
541.3
540.86
543.2
543.39
548.3
546.06
553.5
553.90
0
1
2
3
4
5
6
7
8
9
10
11
12
13
14
B.M. #2A Spike in root of 30" Pine 60 ft. Lt. Sta. 12+86 Elev. 545.26
series F no 100(11)
sheet 4 of 52 sheets
LONDONDERRY