PARCEL	INSTRUMENT	DATE	GRANTOR	GRANTEE	RECORDED LONDONDERRY BOOK	PAGE	DATE	REMARKS
#/A	W.D.O.E.	7-28-47	ALBERT E. & MARION B. PHILLIPS	ST. OF VT.	26	214	8-11-47	
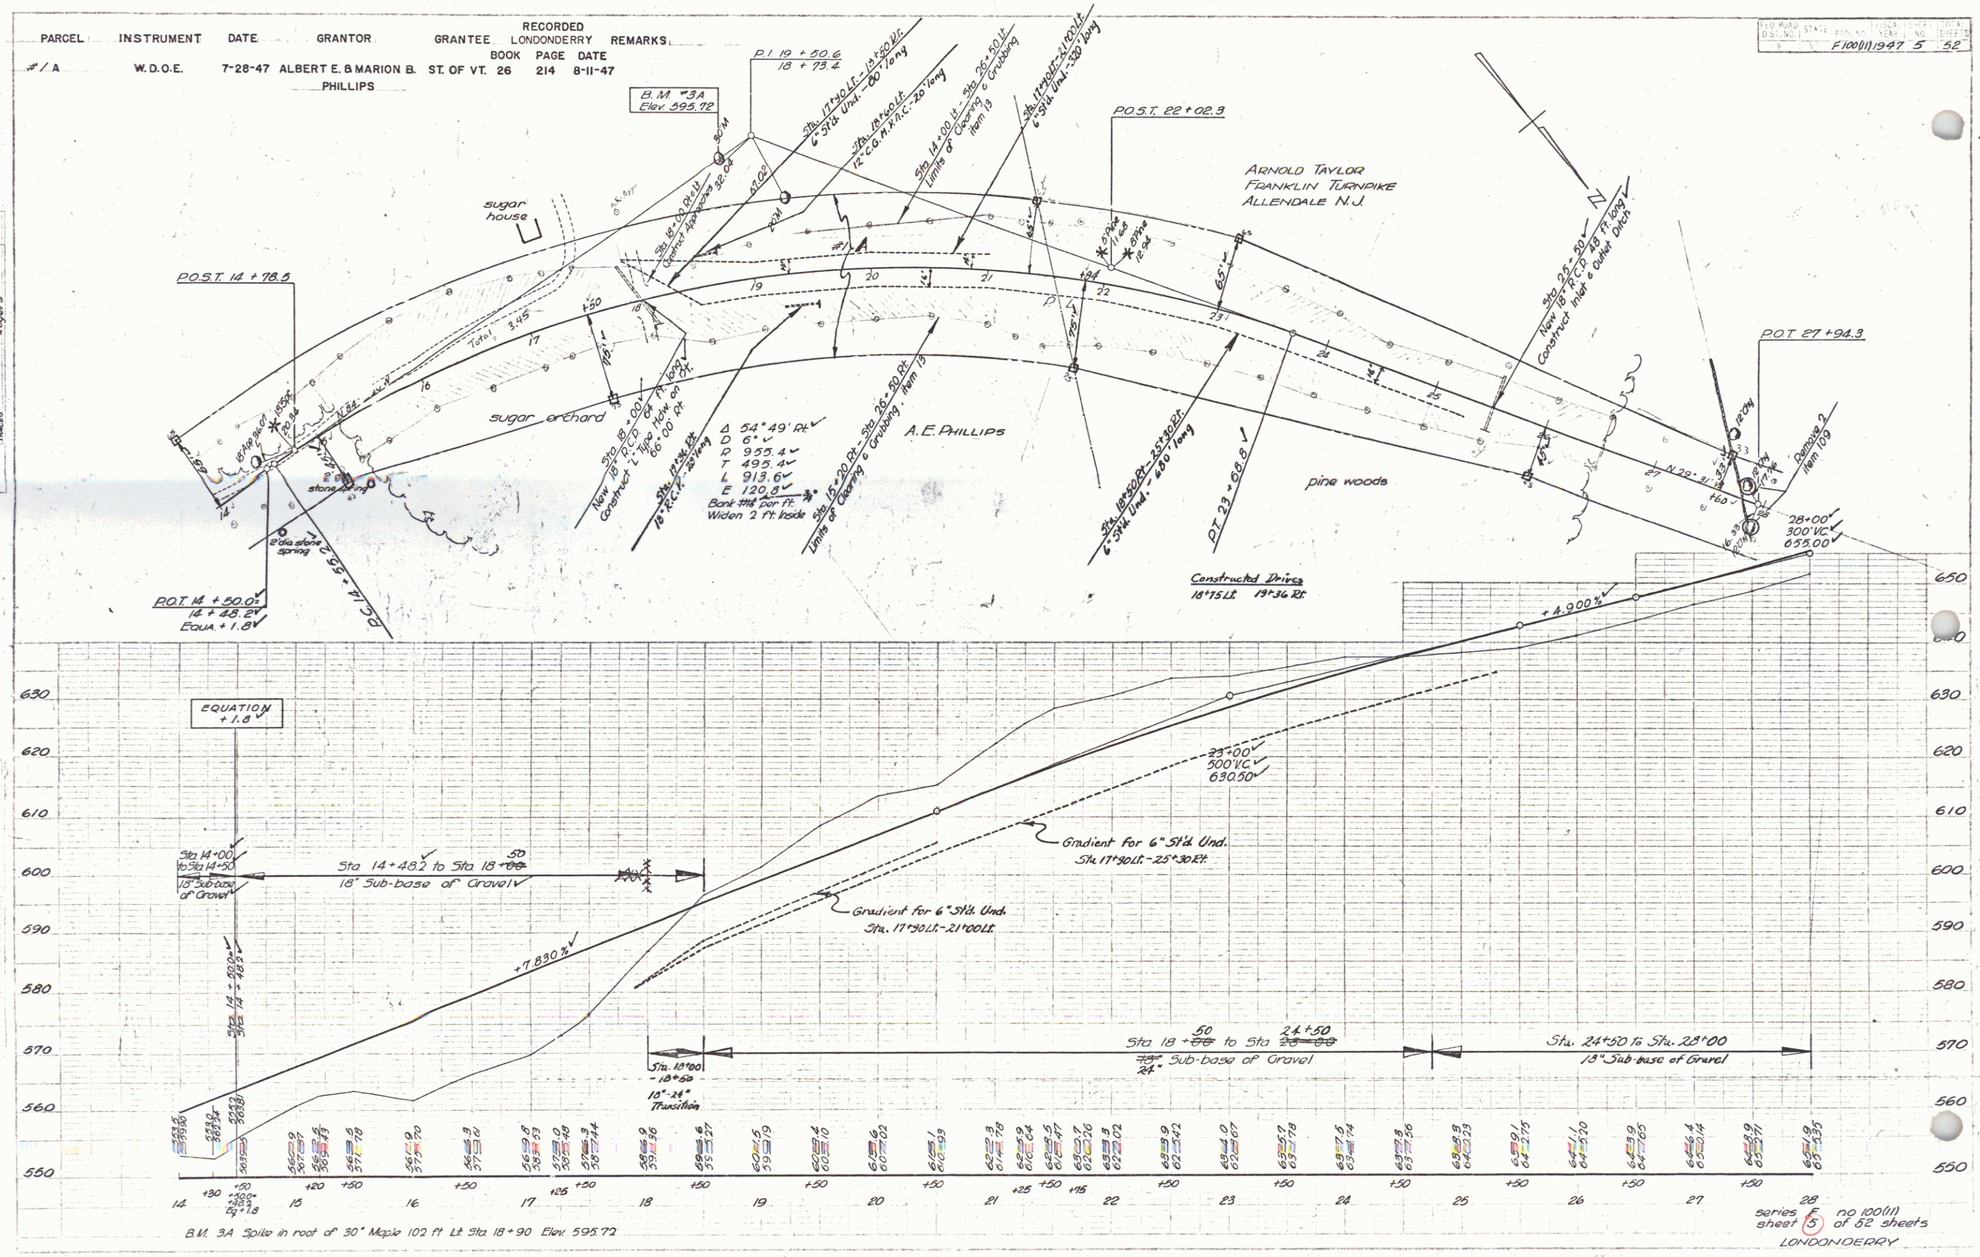
FED. AID DIST. NO.	STATE	ROUTE NO.	PROJECT YEAR	PROJECT NO.	SHEET NO.	TOTAL SHEETS
			F100(11)	1947	5	52