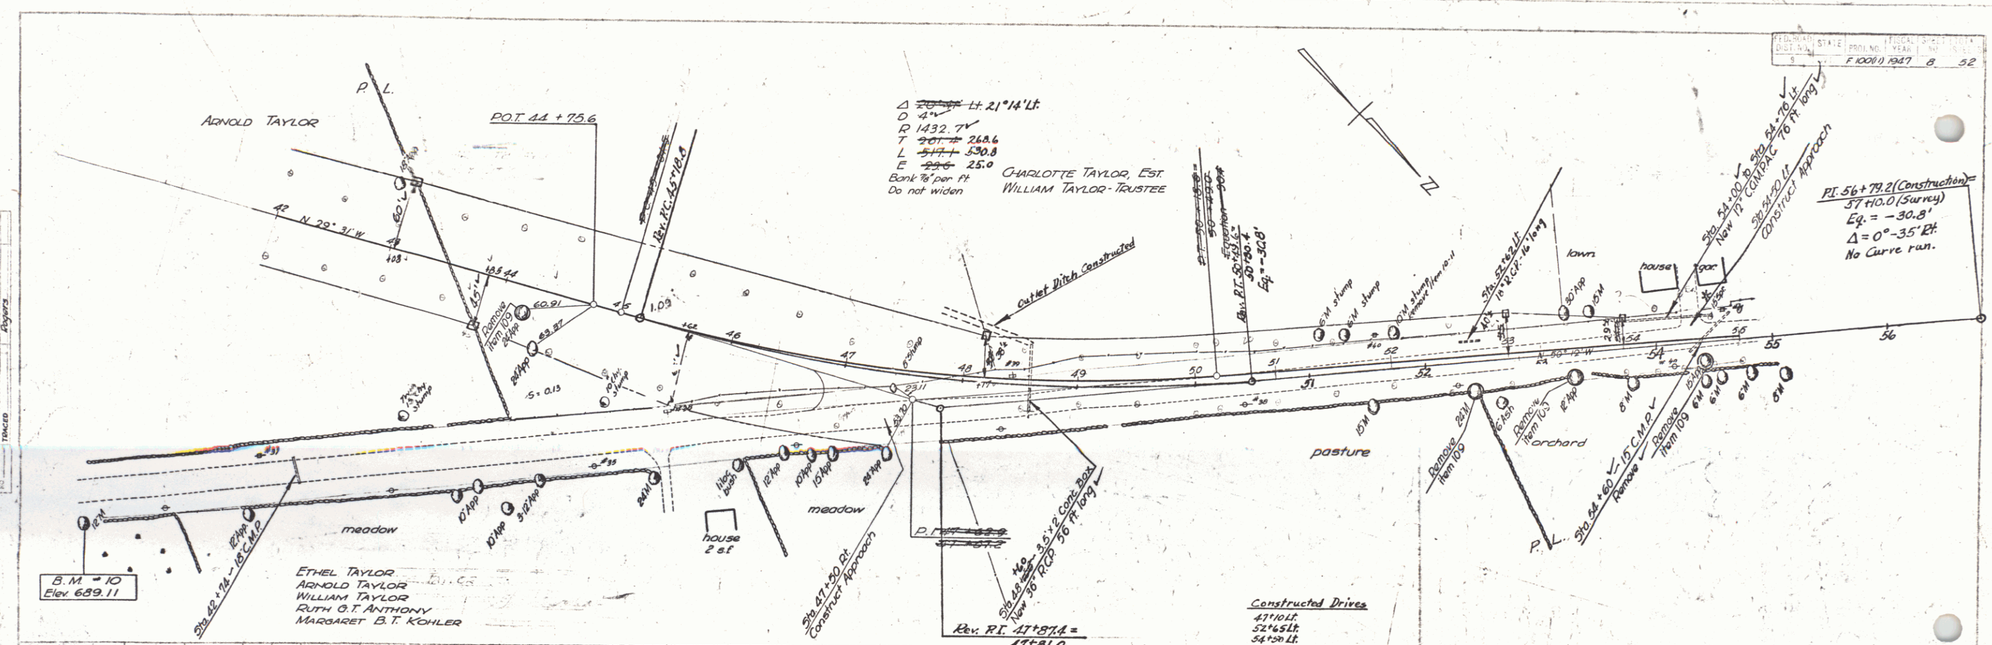FEDERAL AID PROJ. NO.	STATE DIST. NO.	PROJ. NO.	FISCAL YEAR	SHEET NO.	TOTAL SHEETS
	9	F 10001	1947	8	52