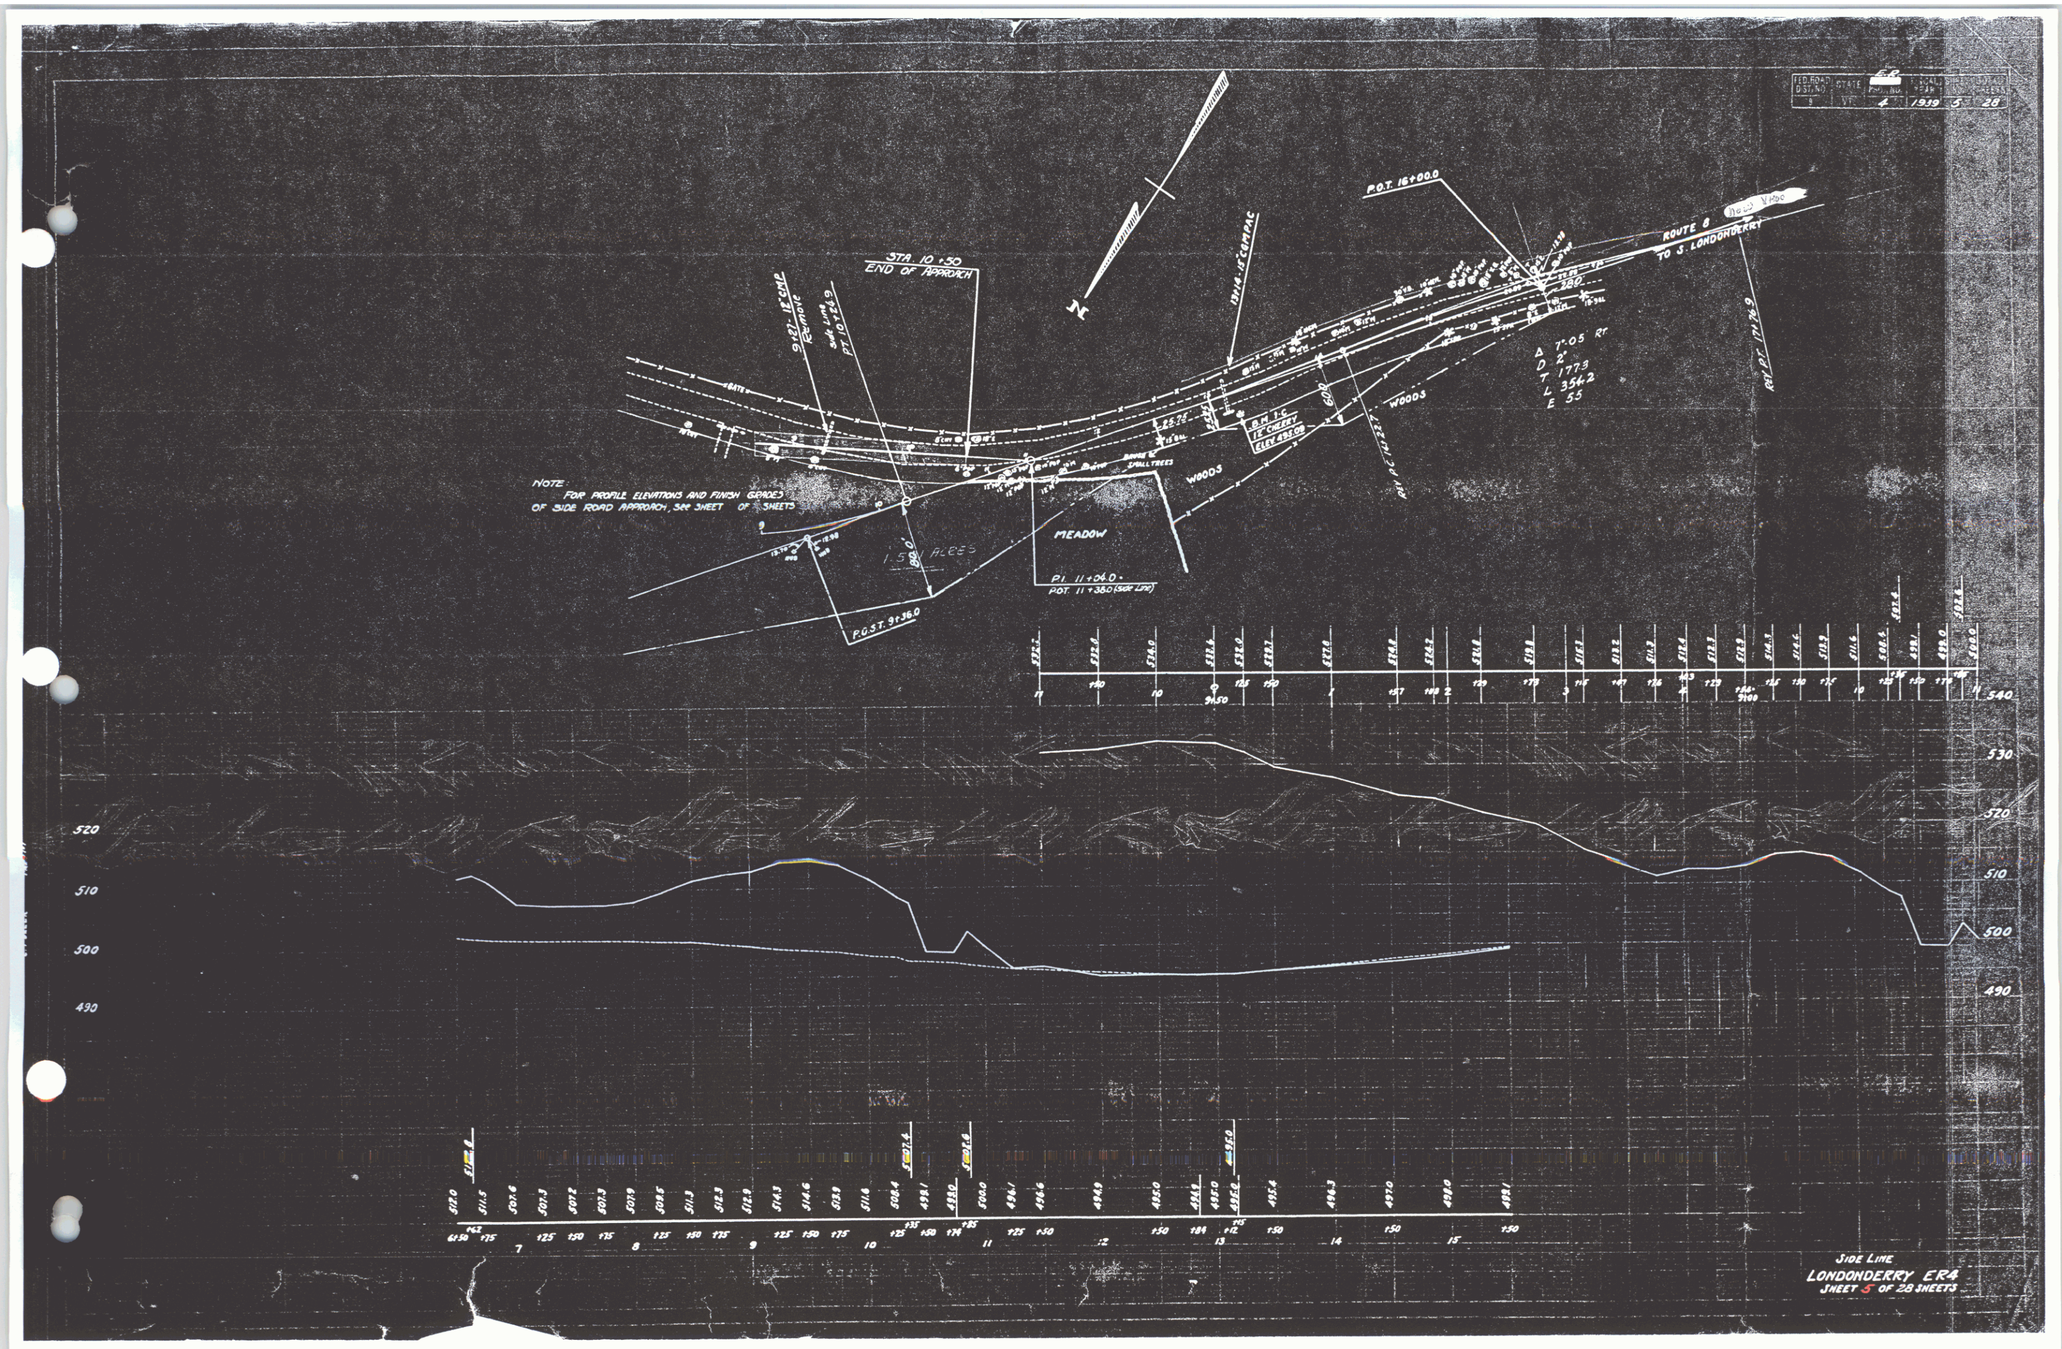
FED. ROAD DIST. NO.
STATE
PROJECT
SCALE PER INCH
DRAWN
SHEETS
8
VT
4
1939
5
28
STA. 10+50
END OF APPROACH
P.O.T. 16+00.0
ROUTE 8
TO J. LONDONDERRY
NOTE:
FOR PROFILE ELEVATIONS AND FINISH GRADES OF SIDE ROAD APPROACH, SEE SHEET OF SHEETS
MEADOW
WOODS
SMALL TREES
P.I. 11+06.0
P.O.T. 11+38.0 (SIDE LINE)
P.O.S.T. 9+36.0
A 7°-05' RT
D 2°
T 177.3
L 354.2
E 55
SIDE LINE
LONDONDERRY ER4
SHEET 5 OF 28 SHEETS