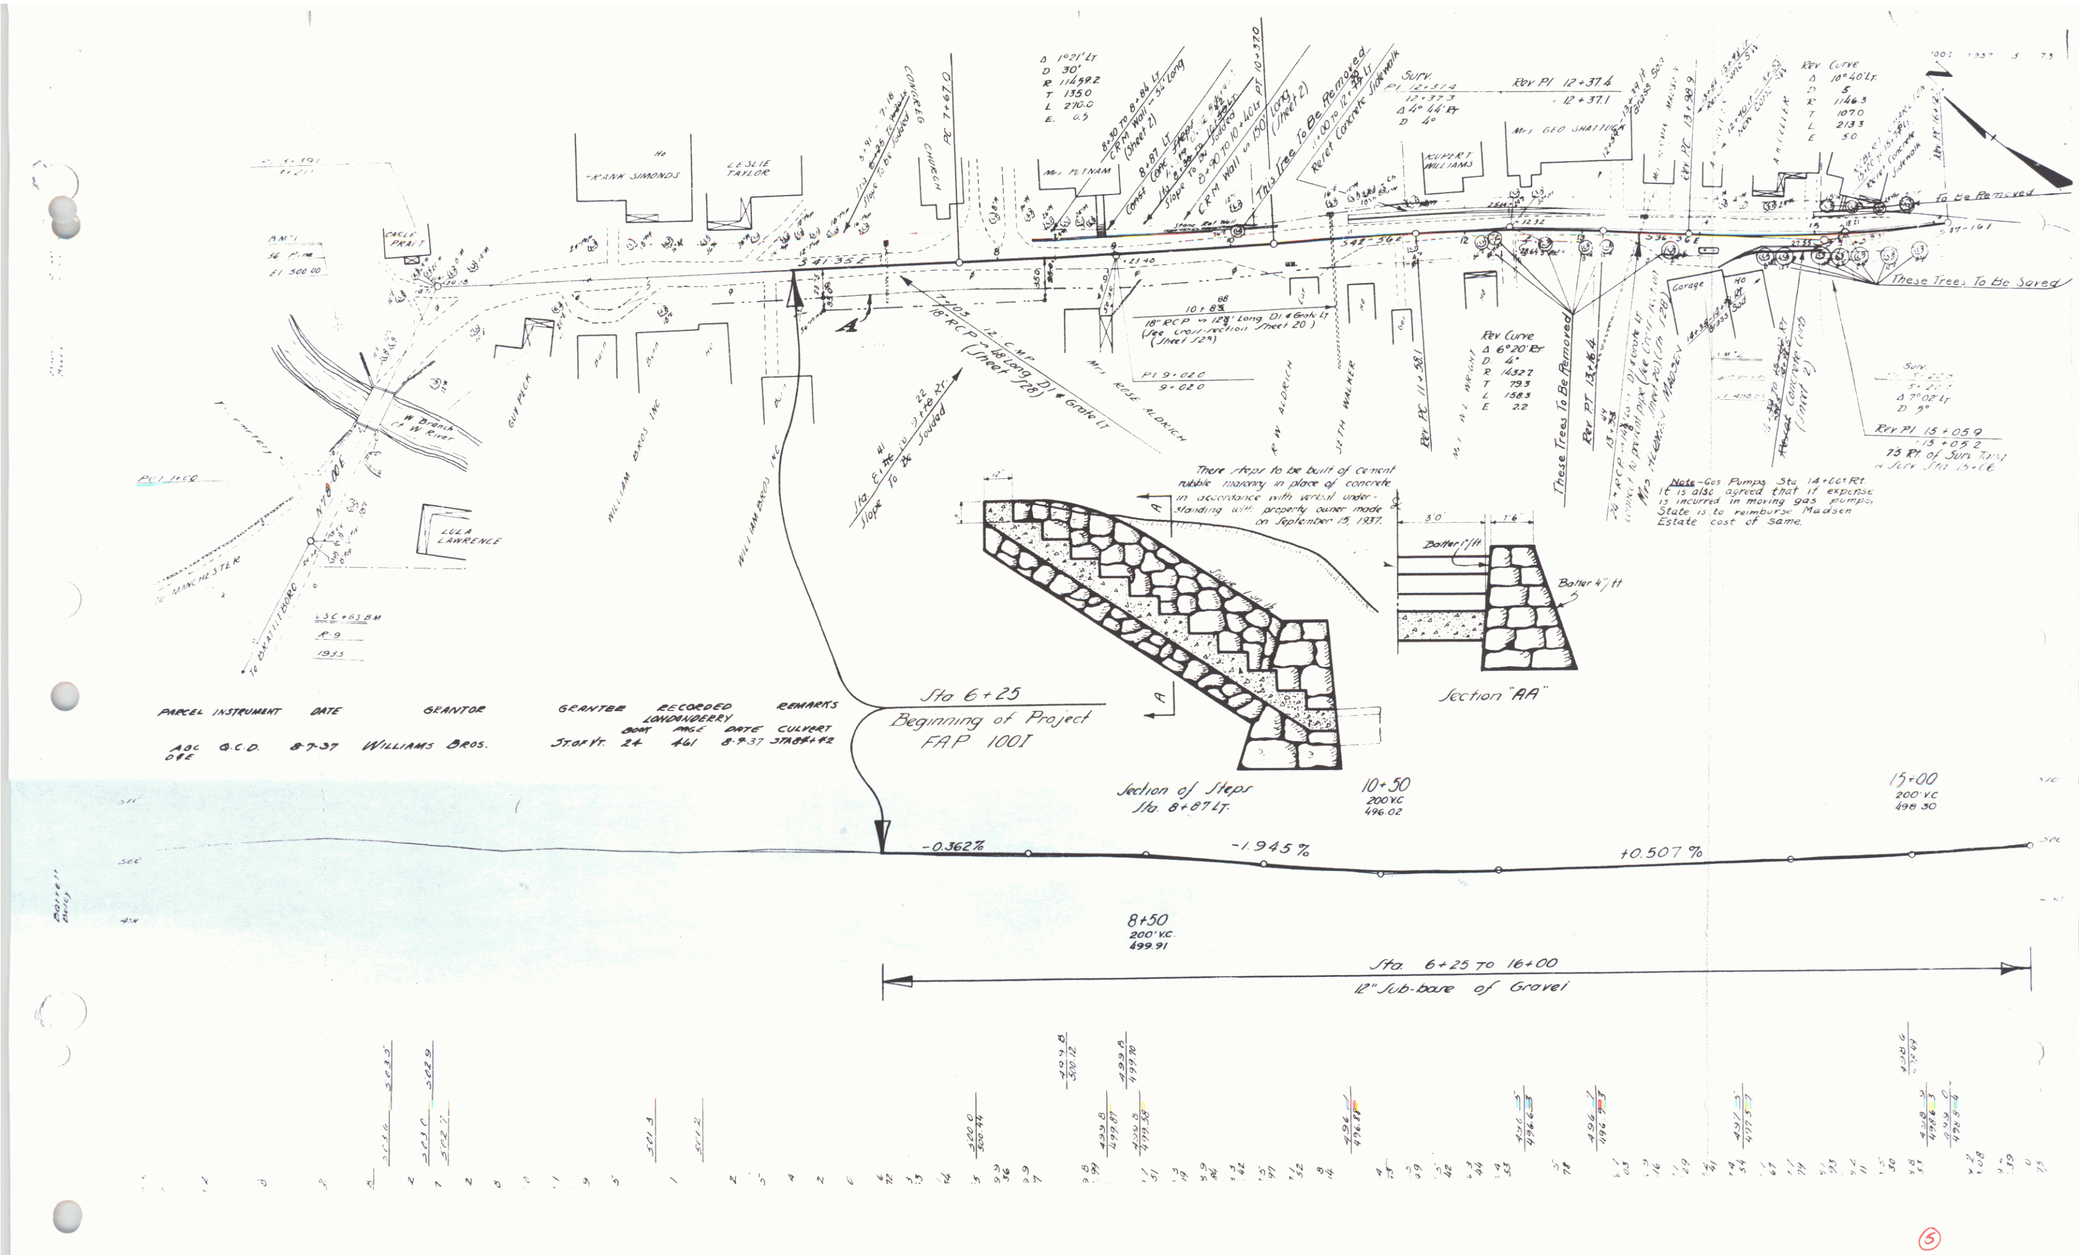
Sta 6+25
Beginning of Project
FAP 1001
Section "AA"
Section of Steps
Sta. 8+87 LT.
-0.362%
-1.945%
+0.507%
8+50
200' V.C.
499.91
10+50
200' V.C.
496.02
15+00
200' V.C.
498.30
Sta. 6+25 to 16+00
12" Sub-base of Gravel
PARCEL INSTRUMENT DATE GRANTOR GRANTEE RECORDED LONDONDERRY BOOK PAGE DATE REMARKS CULVERT
A&C D&E Q.C.D. 8-7-37 WILLIAMS BROS. State Hy. 24 461 8-9-37 STA 8+42
Note - Gas Pumps Sta. 14+66 Rt.
It is also agreed that if expense is incurred in moving gas pumps, State is to reimburse Madsen Estate cost of same.
There Steps to be built of Cement rubble masonry in place of concrete in accordance with verbal understanding with property owner made on September 13, 1937.
These Trees To Be Saved
These Trees To Be Removed
Garage
Batter 1"/ft
Batter 4"/ft

2