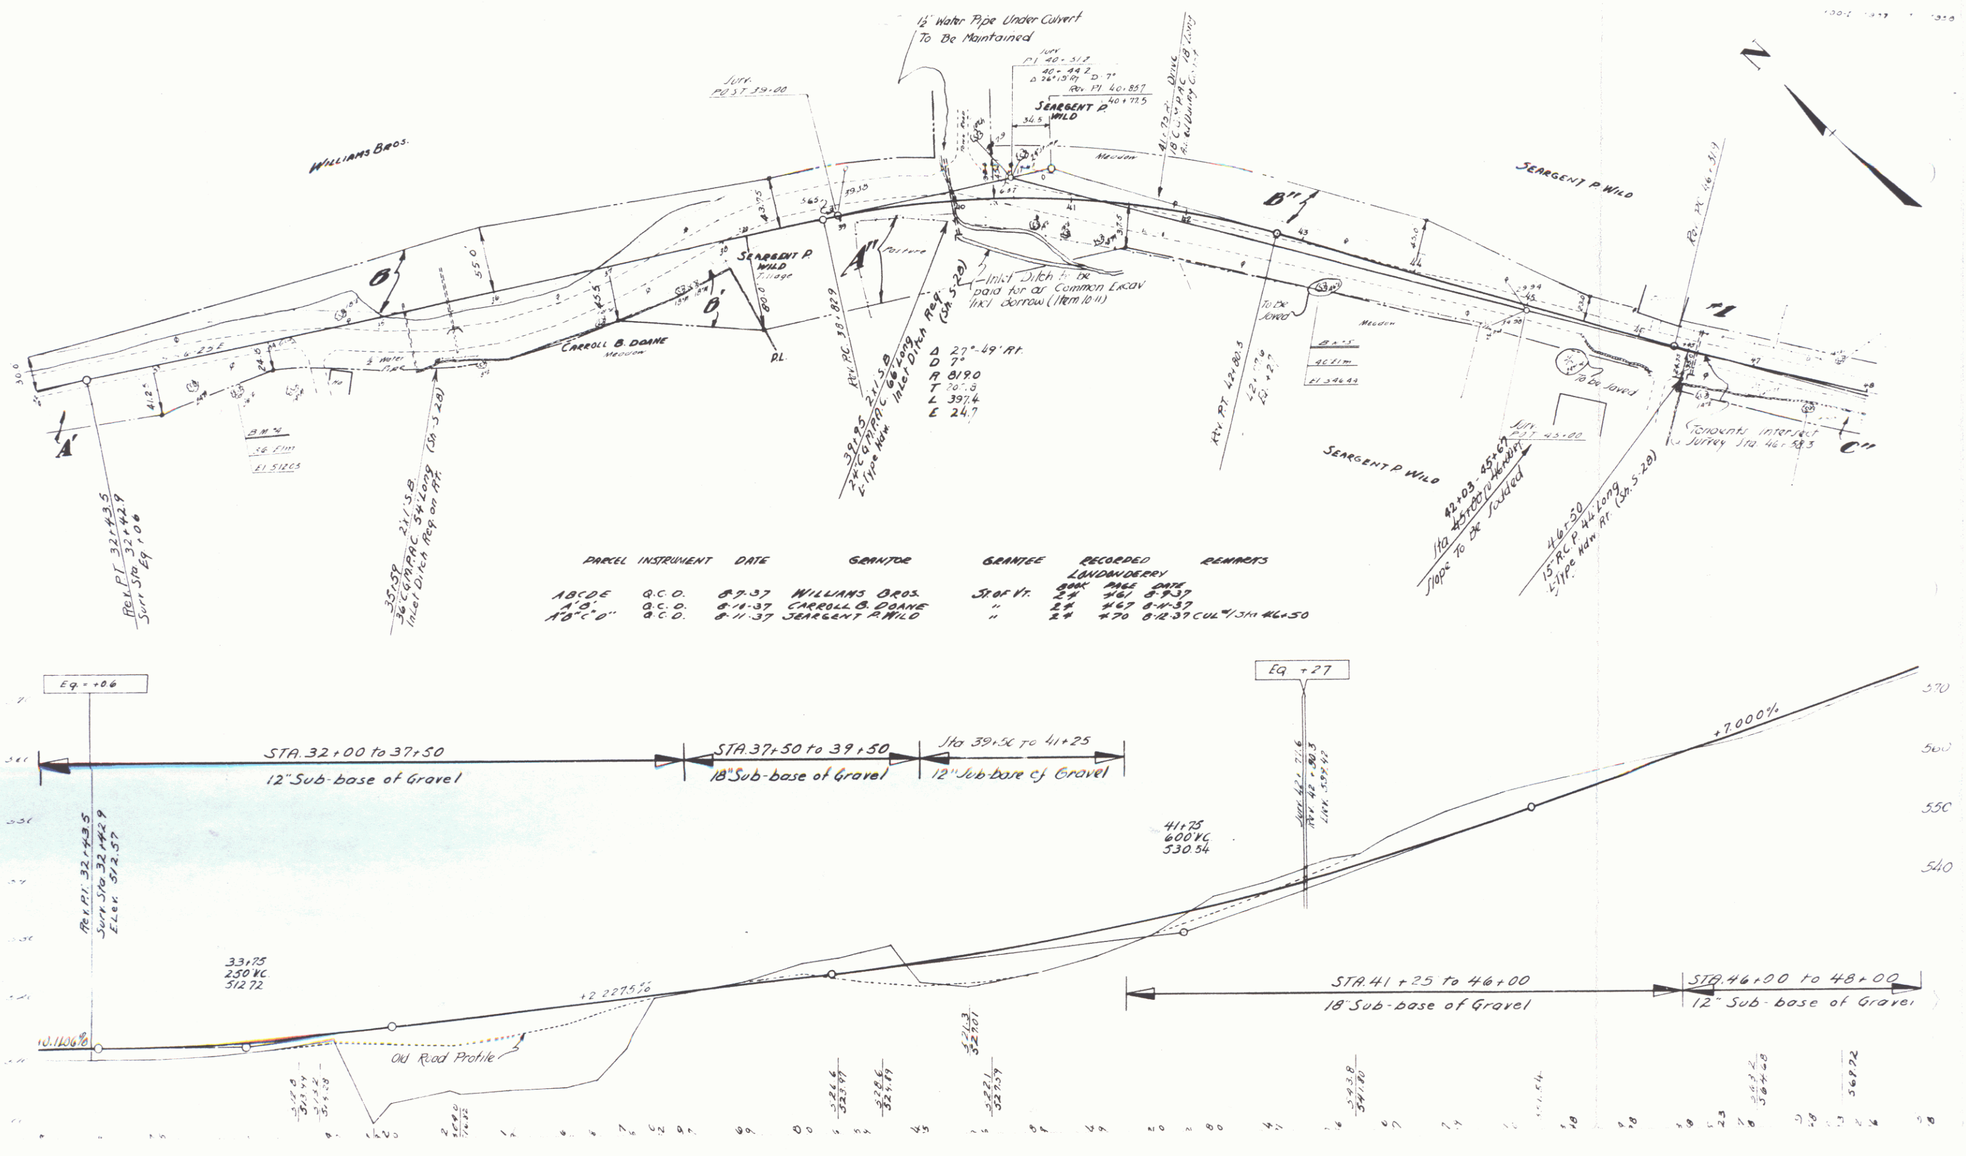
1½" Water Pipe Under Culvert To Be Maintained
WILLIAMS BROS.
SEARGENT P. WILD
CARROLL B. DOANE
Meadow
Inlet Ditch to be paid for as Common Excav Incl borrow (Item 10.11)
Inlet Ditch Req (Sh. 5-28)
Δ 27°-49' Rt.
D 7°
R 819.0
T 201.8
L 397.4
E 24.7
To be Joined
