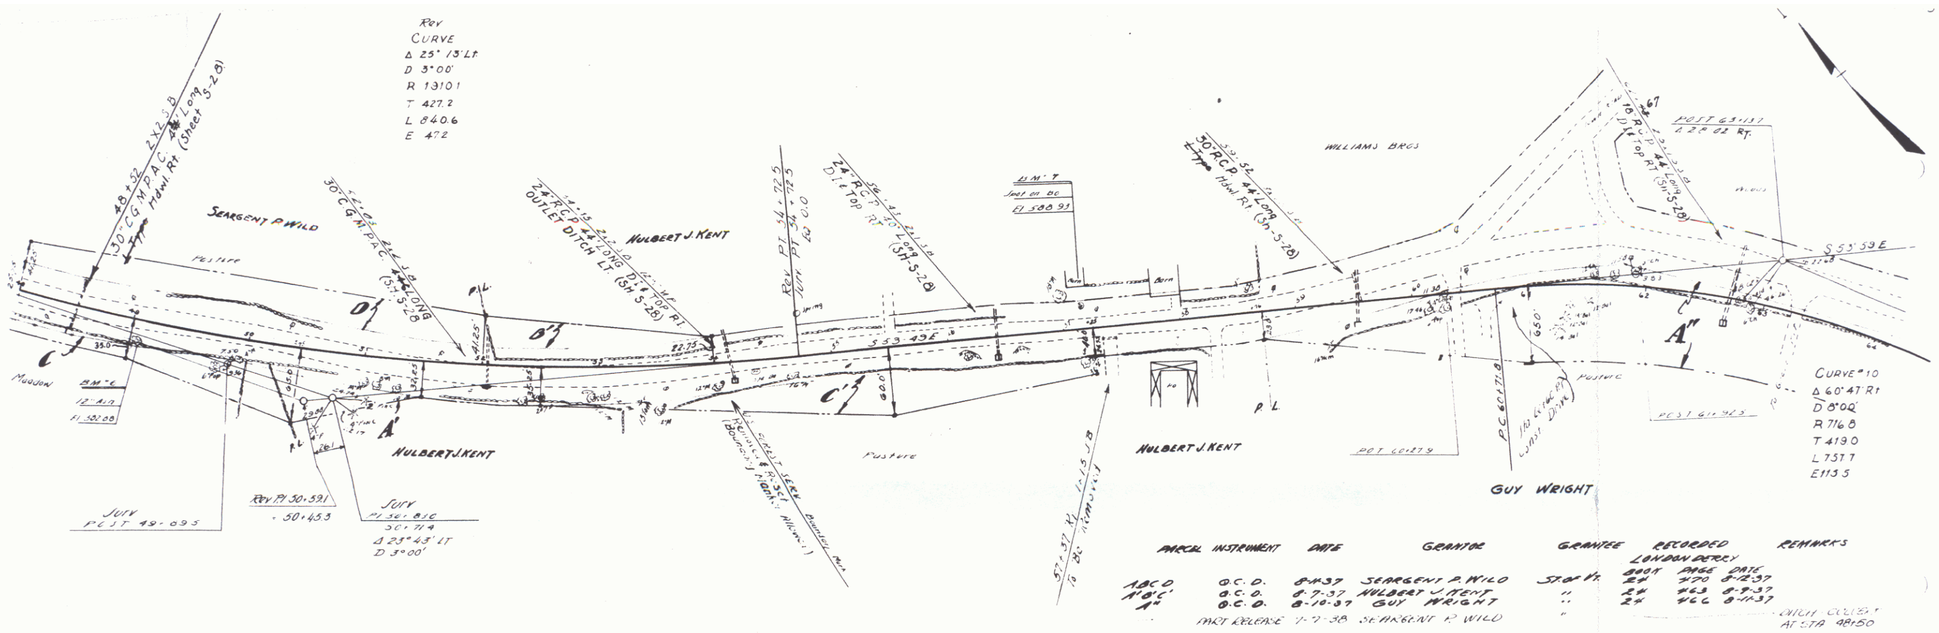

PARCEL	INSTRUMENT	DATE	GRANTOR	GRANTEE	RECORDED LONDON DERRY BOOK	PAGE	DATE	REMARKS
1 A C'	Q.C.D.	8-7-37	NULBERT J. KENT	"	224	463	8-9-37	
1 A"	Q.C.D.	8-10-37	GUY WRIGHT	"	224	466	8-11-37	
	PART RELEASE	7-7-38	SEARGENT P. WILD	"				

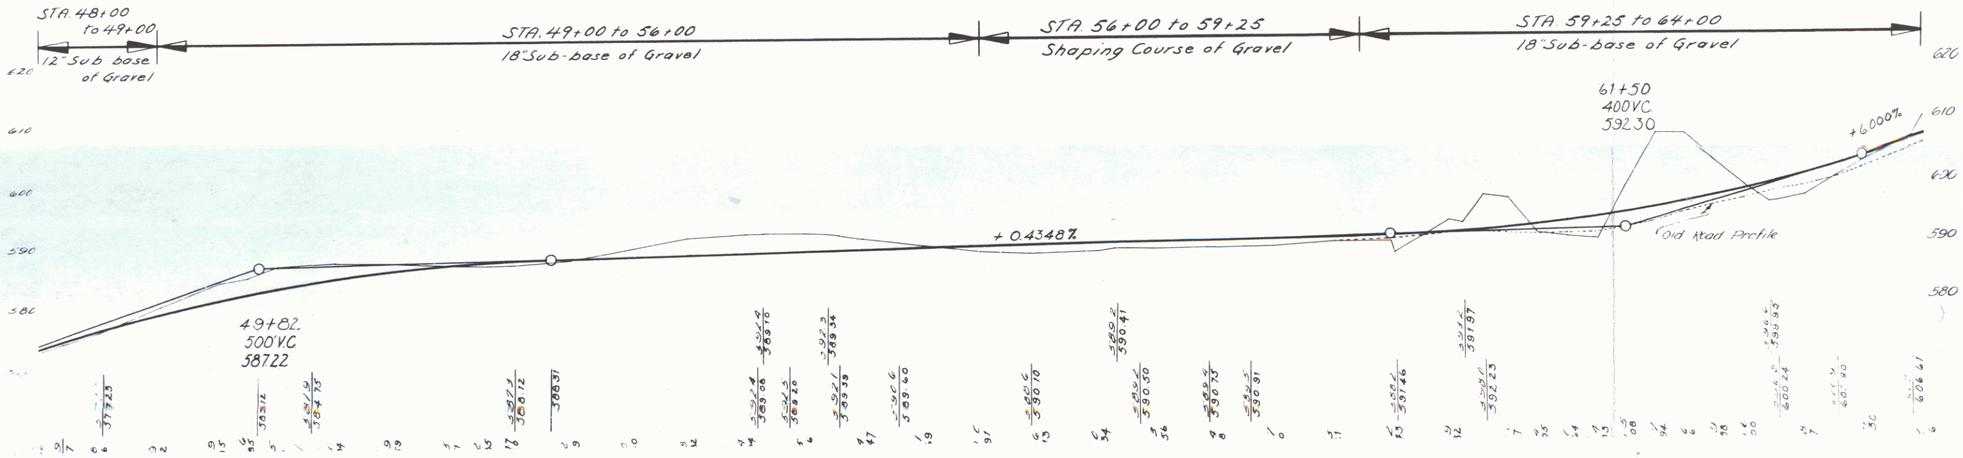

5