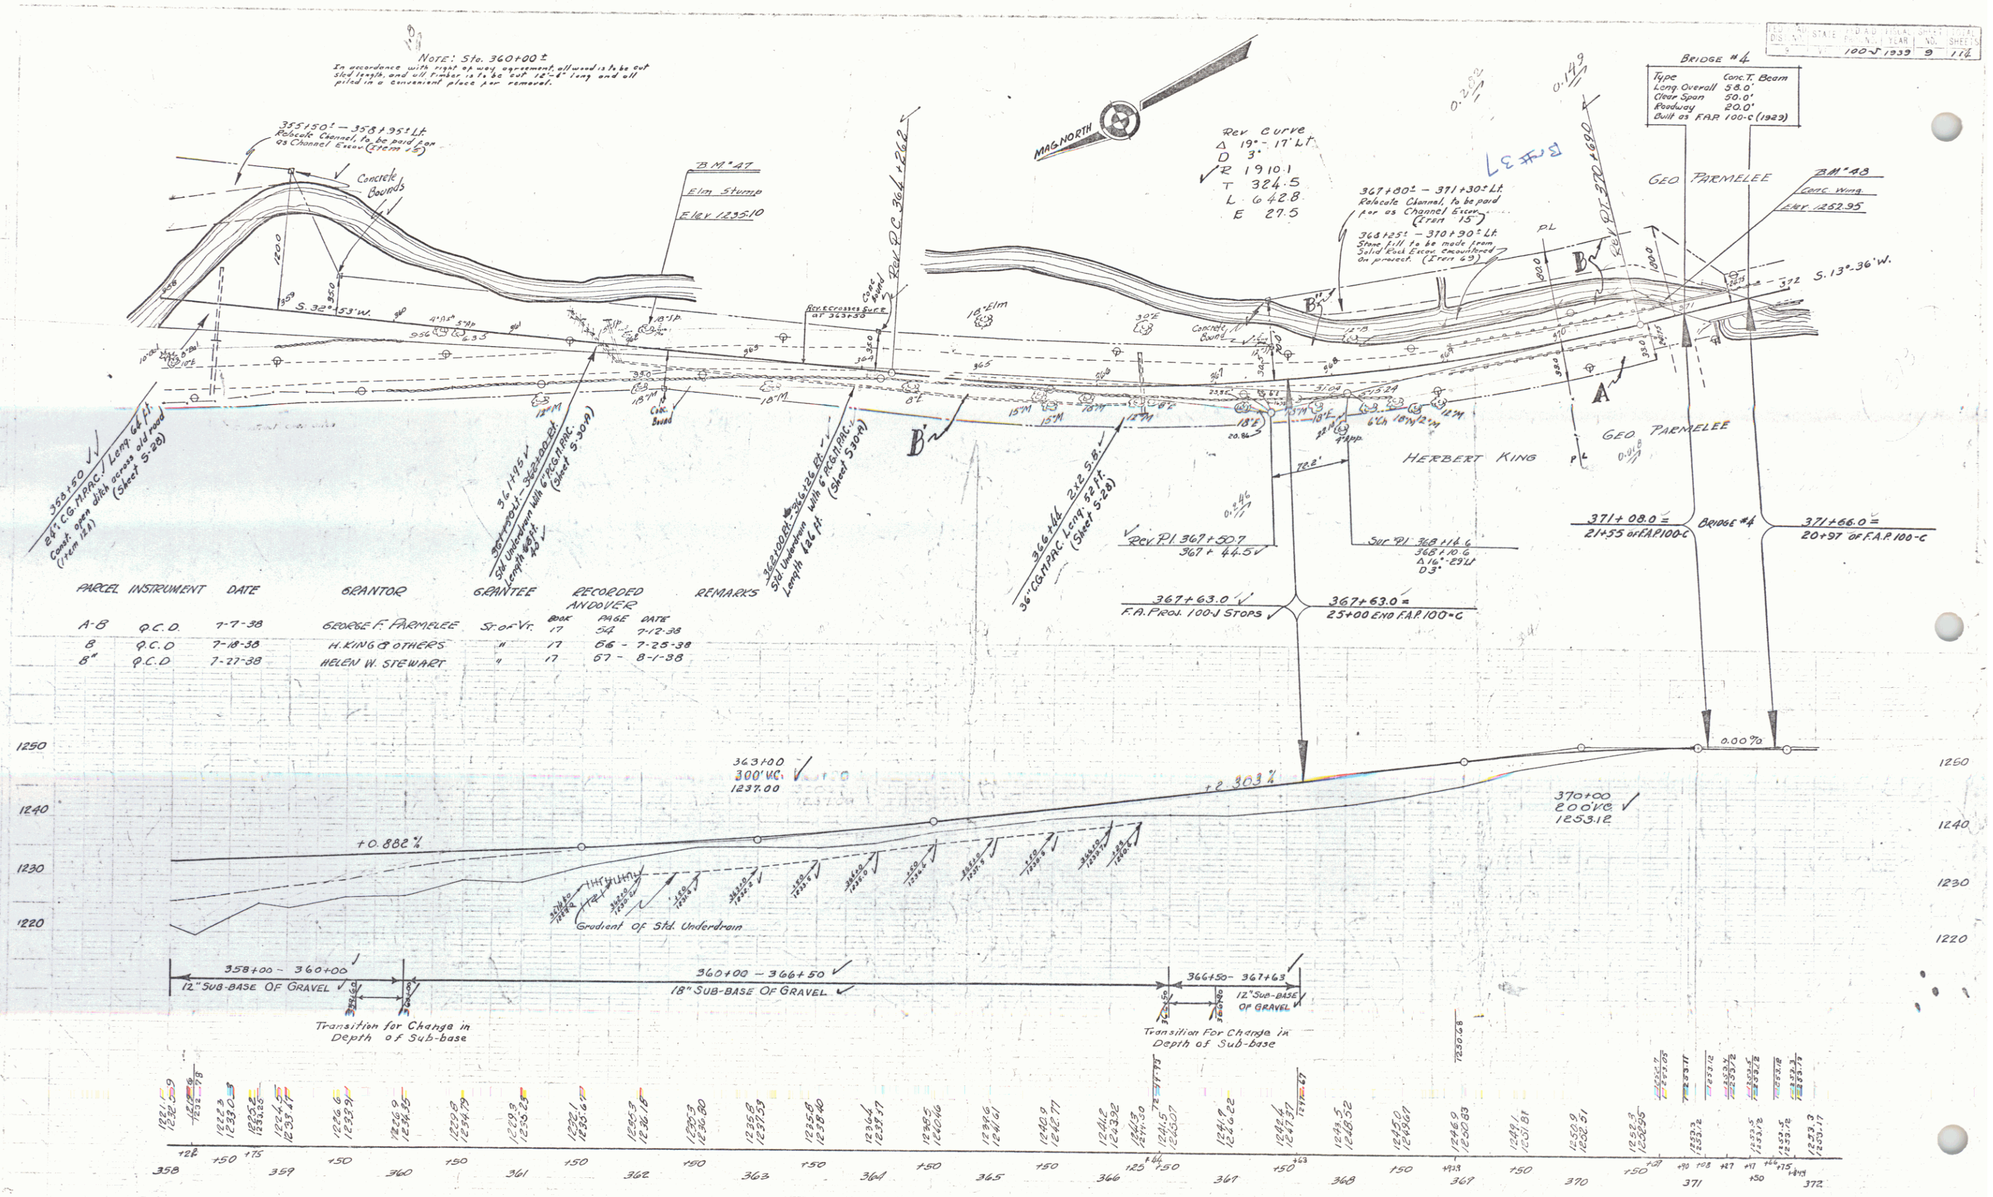

PARCEL	INSTRUMENT	DATE	GRANTOR	GRANTEE	RECORDED AND OVER BOOK	PAGE	DATE	REMARKS
A-B	Q.C.D.	7-7-38	GEORGE F. PARMELEE	St. of Vt.	17	54	7-12-38	
B	Q.C.D.	7-18-38	H. KING & OTHERS	"	17	66	7-25-38	
B"	Q.C.D.	7-27-38	HELEN W. STEWART	"	17	67	8-1-38	