FED. HWY. DIST. NO.	STATE	FED. AID PROJ. NO.	FISCAL YEAR	SHEET NO.	TOTAL SHEETS
1	VT.	100-J	1939	13	114

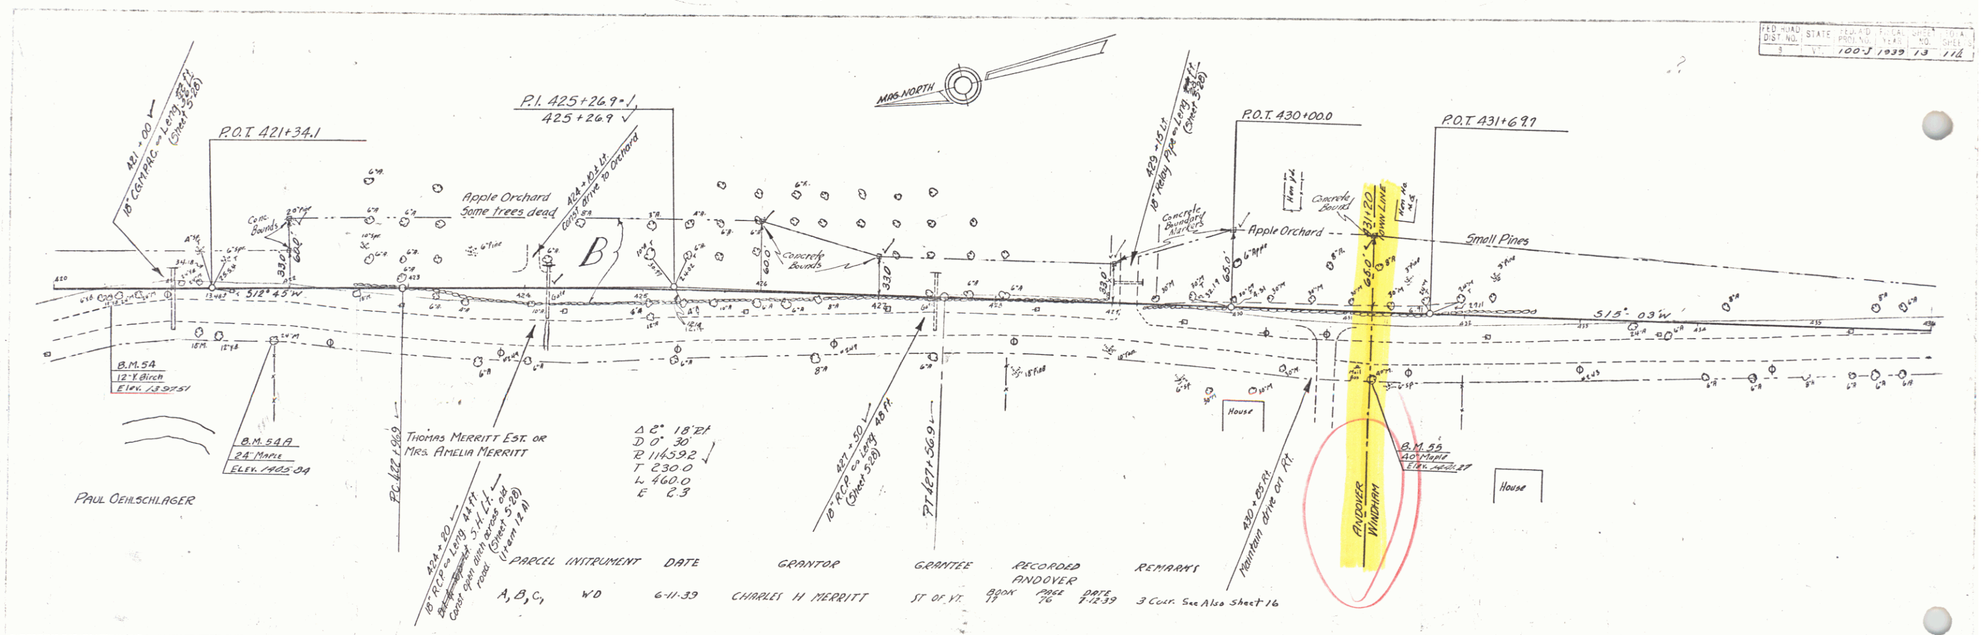

PARCEL	INSTRUMENT	DATE	GRANTOR	GRANTEE	RECORDED ANDOVER BOOK	PAGE	DATE	REMARKS
A, B, C,	WD	6-11-39	CHARLES H MERRITT	ST OF VT.	77	76	7-12-39	3 Cust. See Also Sheet 16

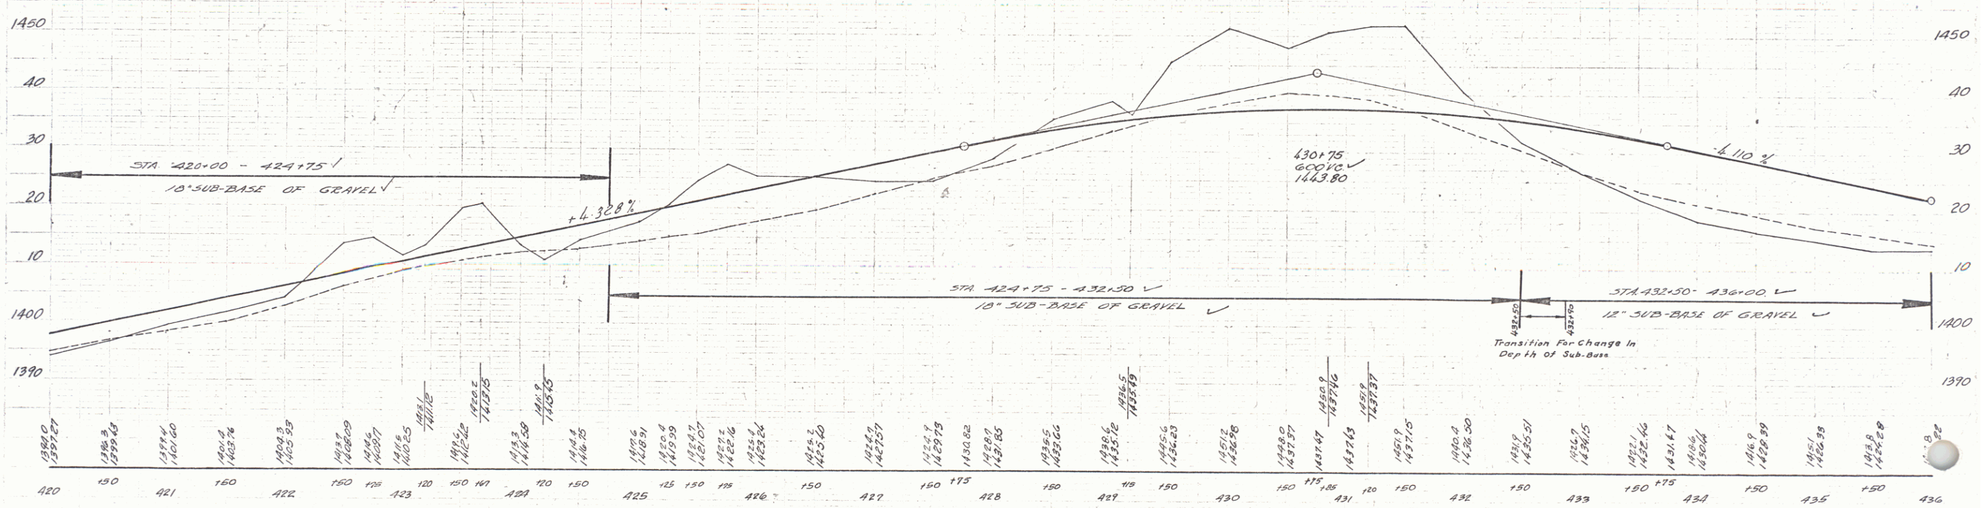

B.M. 54 SPIKE IN ROOT OF 12" Y BIRCH 6' RT 420+42 ELEV 1397.27
B.M. 54A " " " " 24" MAPLE 41' RT. 421+07 ELEV 1405.04
B.M. 55 " " " " 40" " 55 RT 431+20 ELEV 1441.27

SERIES F.A.P. NO. 100-J
SHEET 13 OF 114 SHEETS

12