FED. ROAD DIV.	STATE	FED. AID PROJ. NO.	FISCAL YEAR	SHEET NO.	TOTAL SHEETS
9	VT.	100-1	1959	14	114

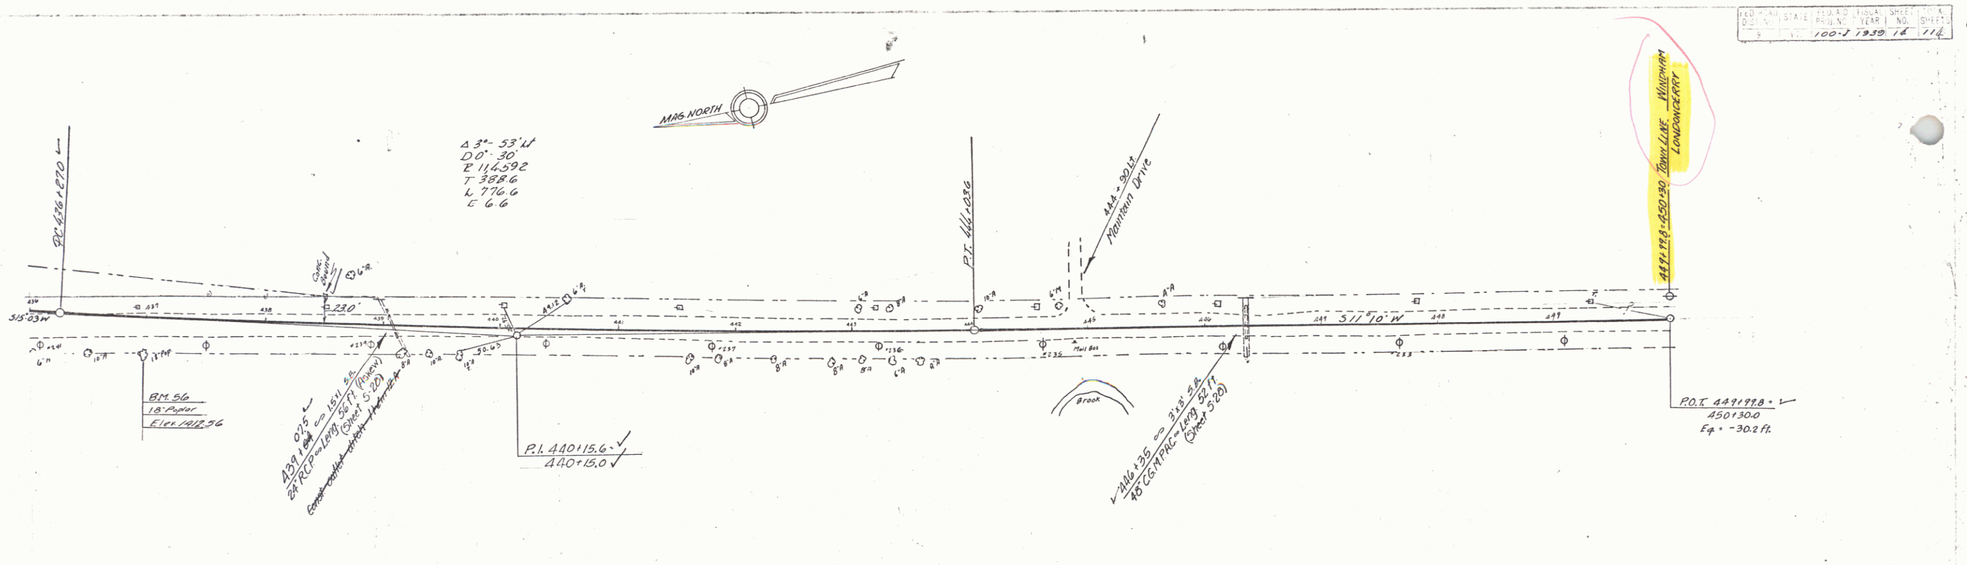

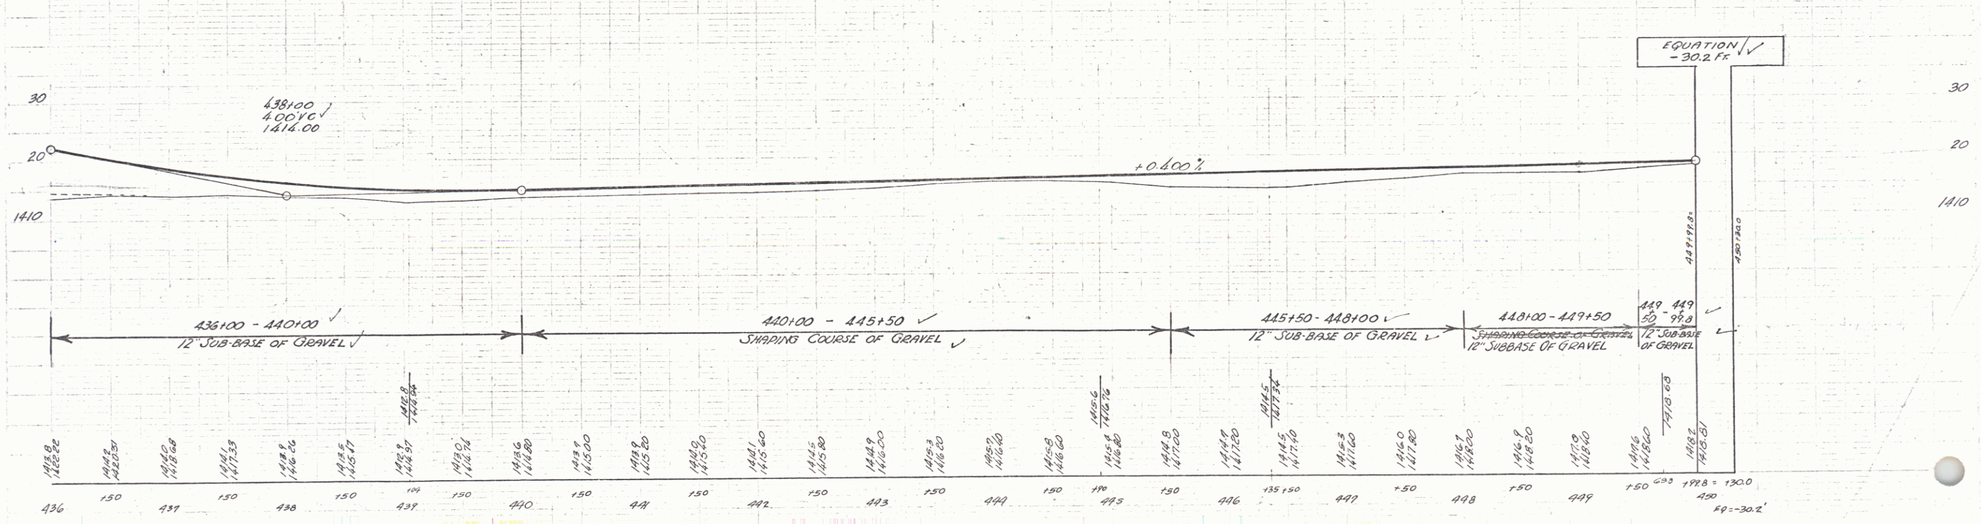

B.M. 56 SPIKE IN ROOT OF 18 POPLAR 30 RT. STA. 437+00 ELEV 1412.56

SERIES FAP NO. 100-1
SHEET 14 OF 114

13