FED. ROAD DIST. NO.	STATE	FED. AID PROJ. NO.	FISCAL YEAR	SHEET NO.	TOTAL SHEETS
		100-J	1939	16	114

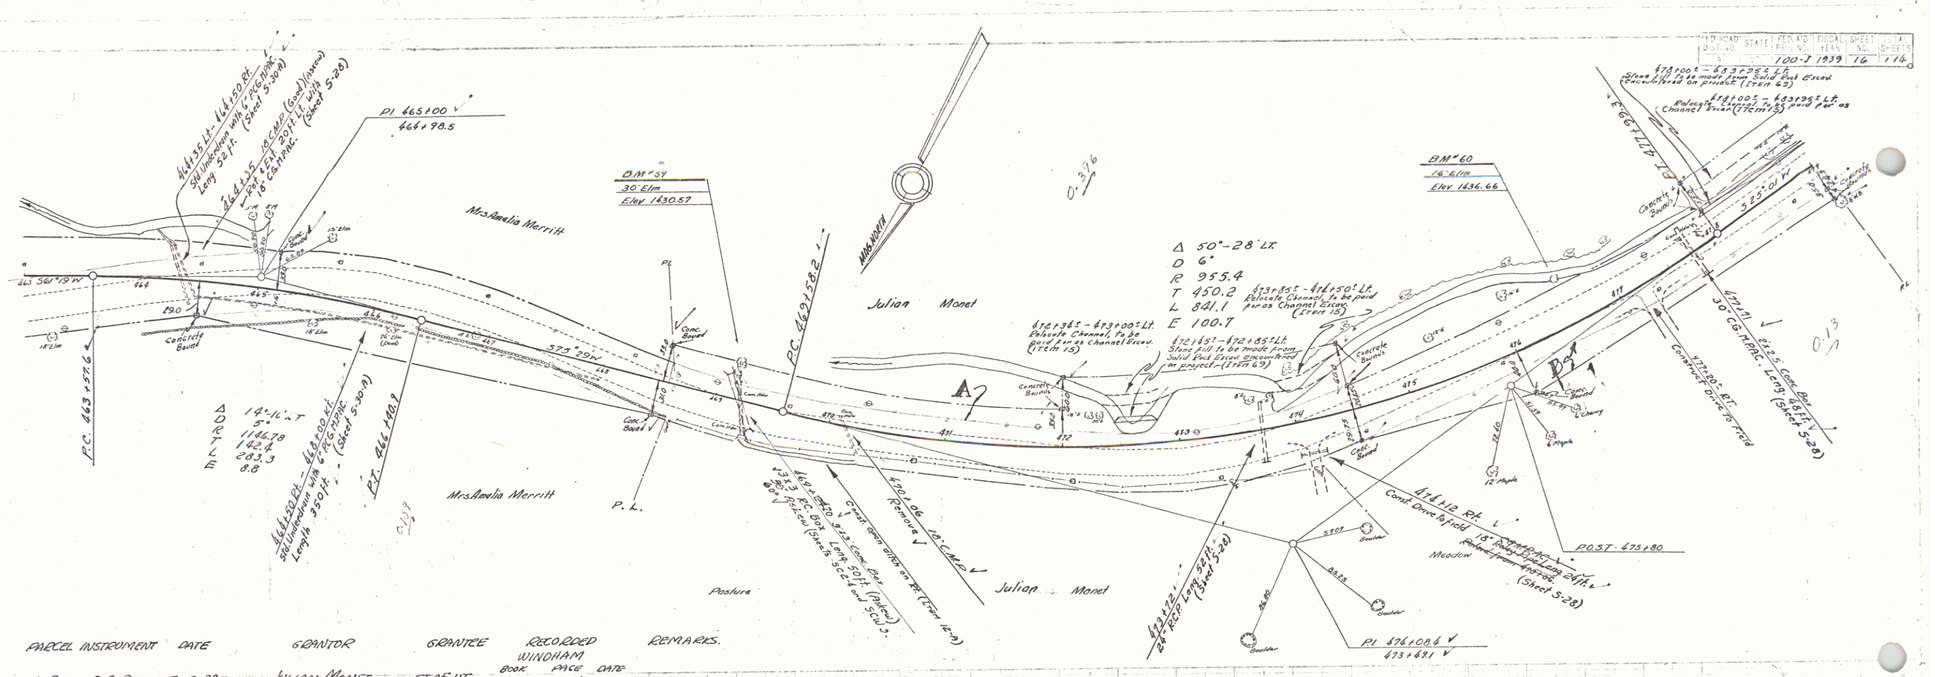

PARCEL	INSTRUMENT	DATE	GRANTOR	GRANTEE	RECORDED WINDHAM BOOK	PAGE	DATE	REMARKS.
A-B	Q.C.D	7-7-38	JULIAN MONET	ST. OF VT.	14	306-308	7-22-38	

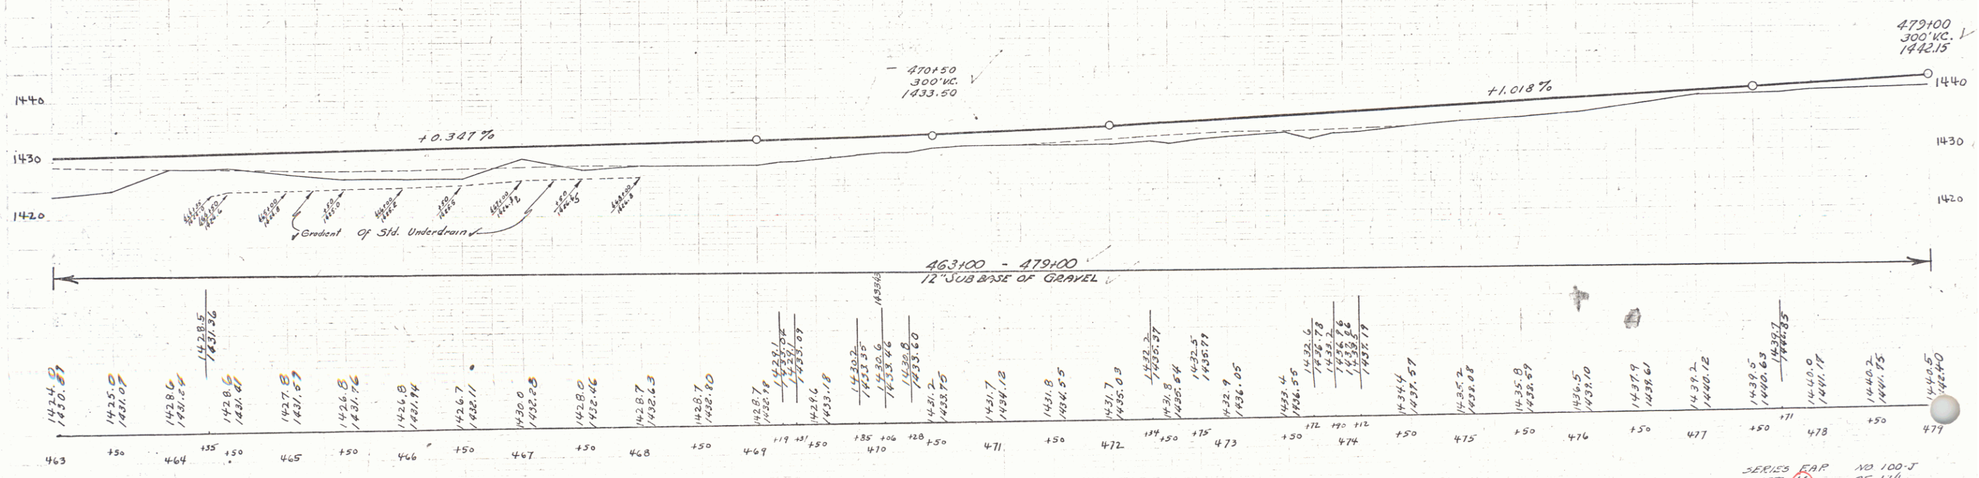

BM# 59 SPIKE IN ROOT OF 30" ELM 30' LT. 469+74 ELEV 1430.57
BM# 60 " " " " 16" " 39 LT 476+56 " 1436.66

SERIES FAP NO 100-J
SHEET 16 OF 114

15