FED. ROAD DIST. NO.	STATE	ROAD PROJ. NO.	FISCAL YEAR	SHEET NO.	TOTAL SHEETS
5		100-J	1939	18	116

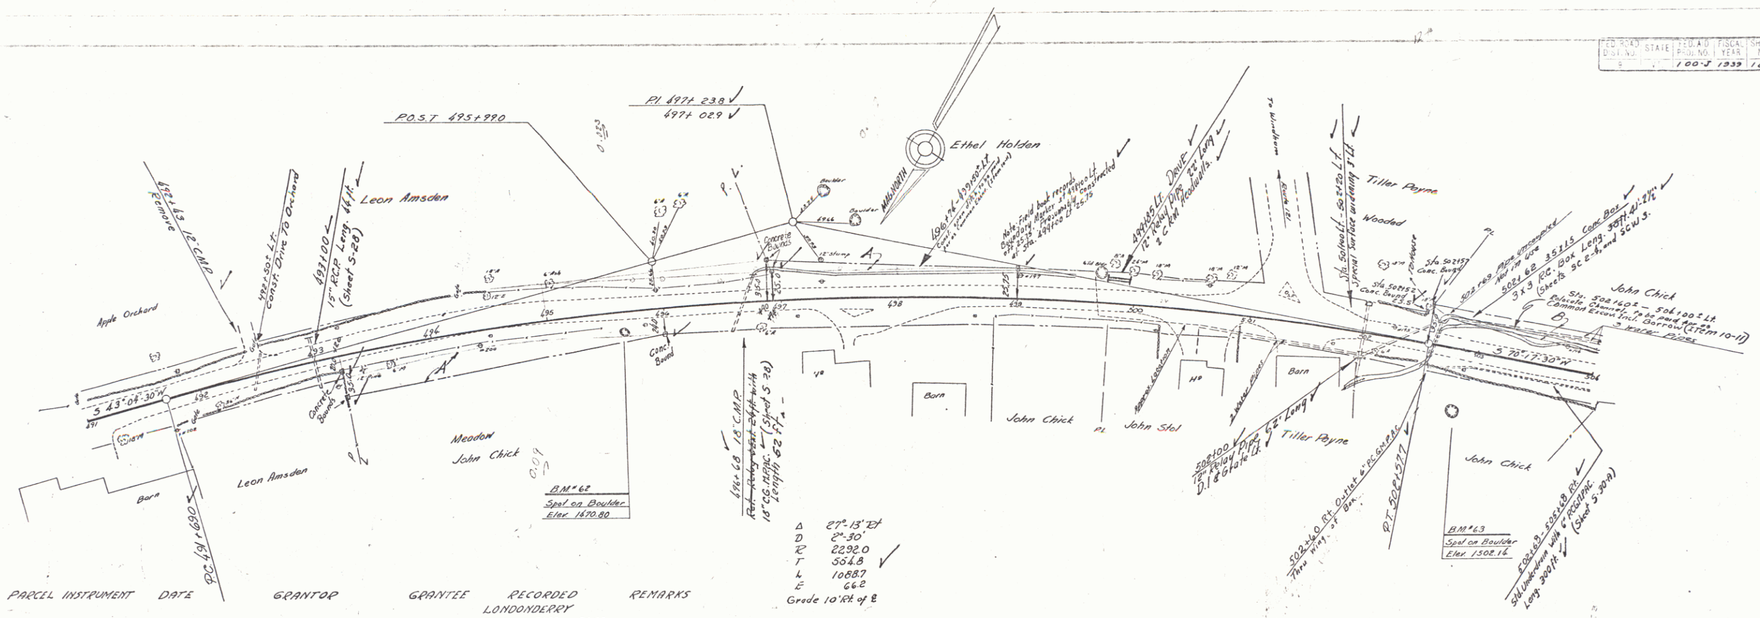

PARCEL	INSTRUMENT	DATE	GRANTOR	GRANTEE	RECORDED LONDONDERRY BOOK	PAGE	DATE	REMARKS
A	Q.C.D	7-28-38	ETHEL A. GRISWOLD	ST OF VT	25	21	8-1-38	
A-B	Q.C.D	7-28-38	JOHN A. & ROBERTA CHICK	ST OF VT	25	39	8-1-38	

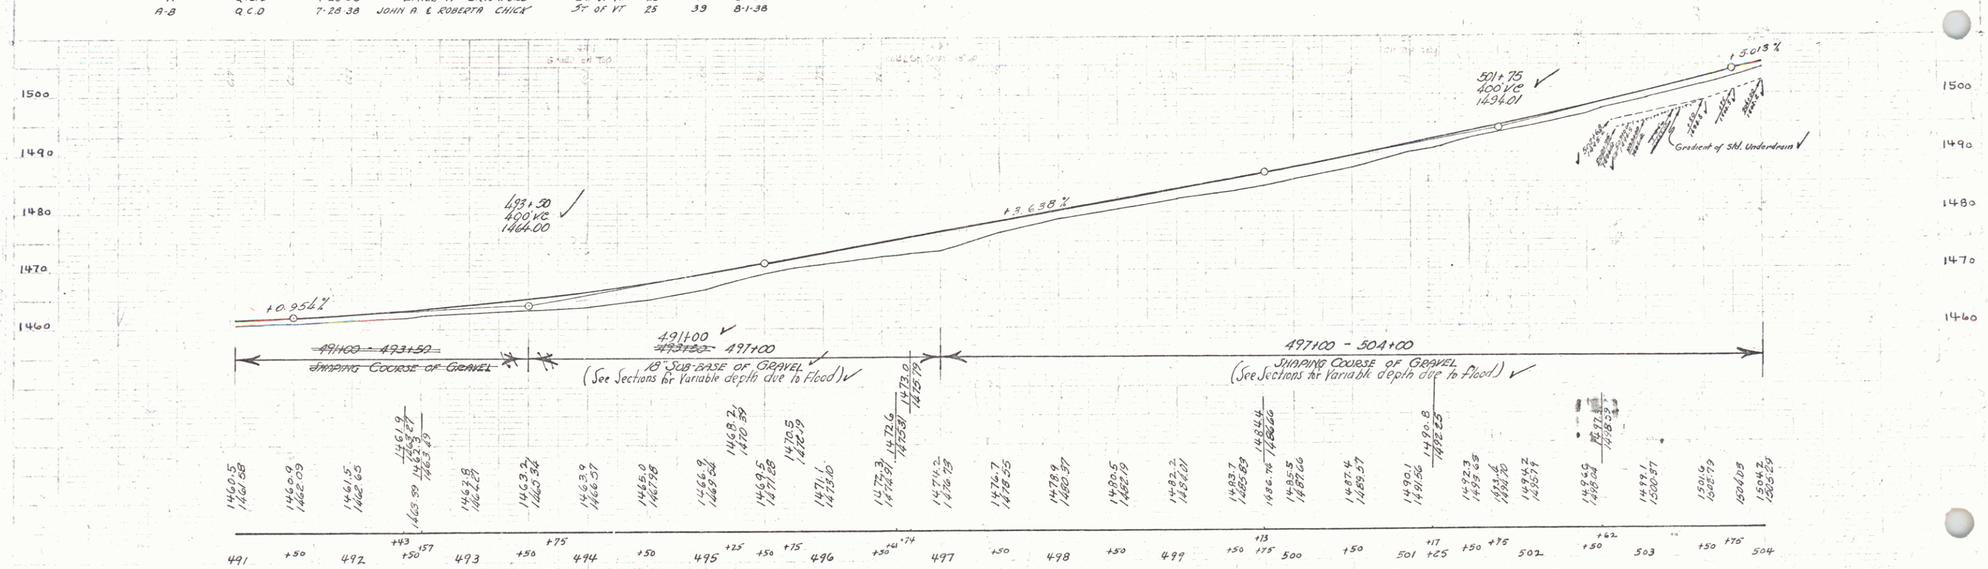

B.M. #62 SPOT ON BOULDER 14' RT 495+65 ELEV 1470.80

SERIES F.A.P. NO. 100-J
SHEET 18 OF 116

17